

# PROFILE & DECKS.

N<sup>o</sup> 423 & 424


SCALE 1/8" = 1 FOOT.

CLASS 100 A.I. WITH FREEBOARD  
CORRESPONDING TO A DRAUGHT  
NOT EXCEEDING THAT CONTEMPLATED  
BY THE RULES FOR A COMPLETE  
SUPERSTRUCTURE VESSEL HAVING A  
TONNAGE OPENING.

DIMENSIONS.  
LENGTH ON L.W.L. = 425'5  
BREADTH MLD = 57'6  
DEPTH MLD = 36'5

FOR SIZE OF TWEEN DECK PILLARS  
SEE MIDSHIP SECTION

BULKHEAD LINER PLATES  
AS PER RULES

 

PLAN No 442  
30/4/27

SHORT BROTHERS LIMITED  
SUNDERLAND.

WS28-0528



Sunderland

Messrs Short Bros. Ltd

Profile & decks

(AS BUILT)

17° 424


S.S. Anglo Australian

SUNDERLAND RET

29431.

W145

RETAIN

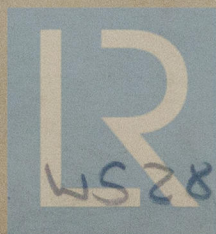

© 2021

Lloyd's Register  
Foundation

WS28-0328