


S/S. "MIDDLESEX"



COFFERDAM BK^D ON FR^W 100.

SCALE $\frac{1}{4}" = 1 \text{ FOOT}$.

S.O. 1014.

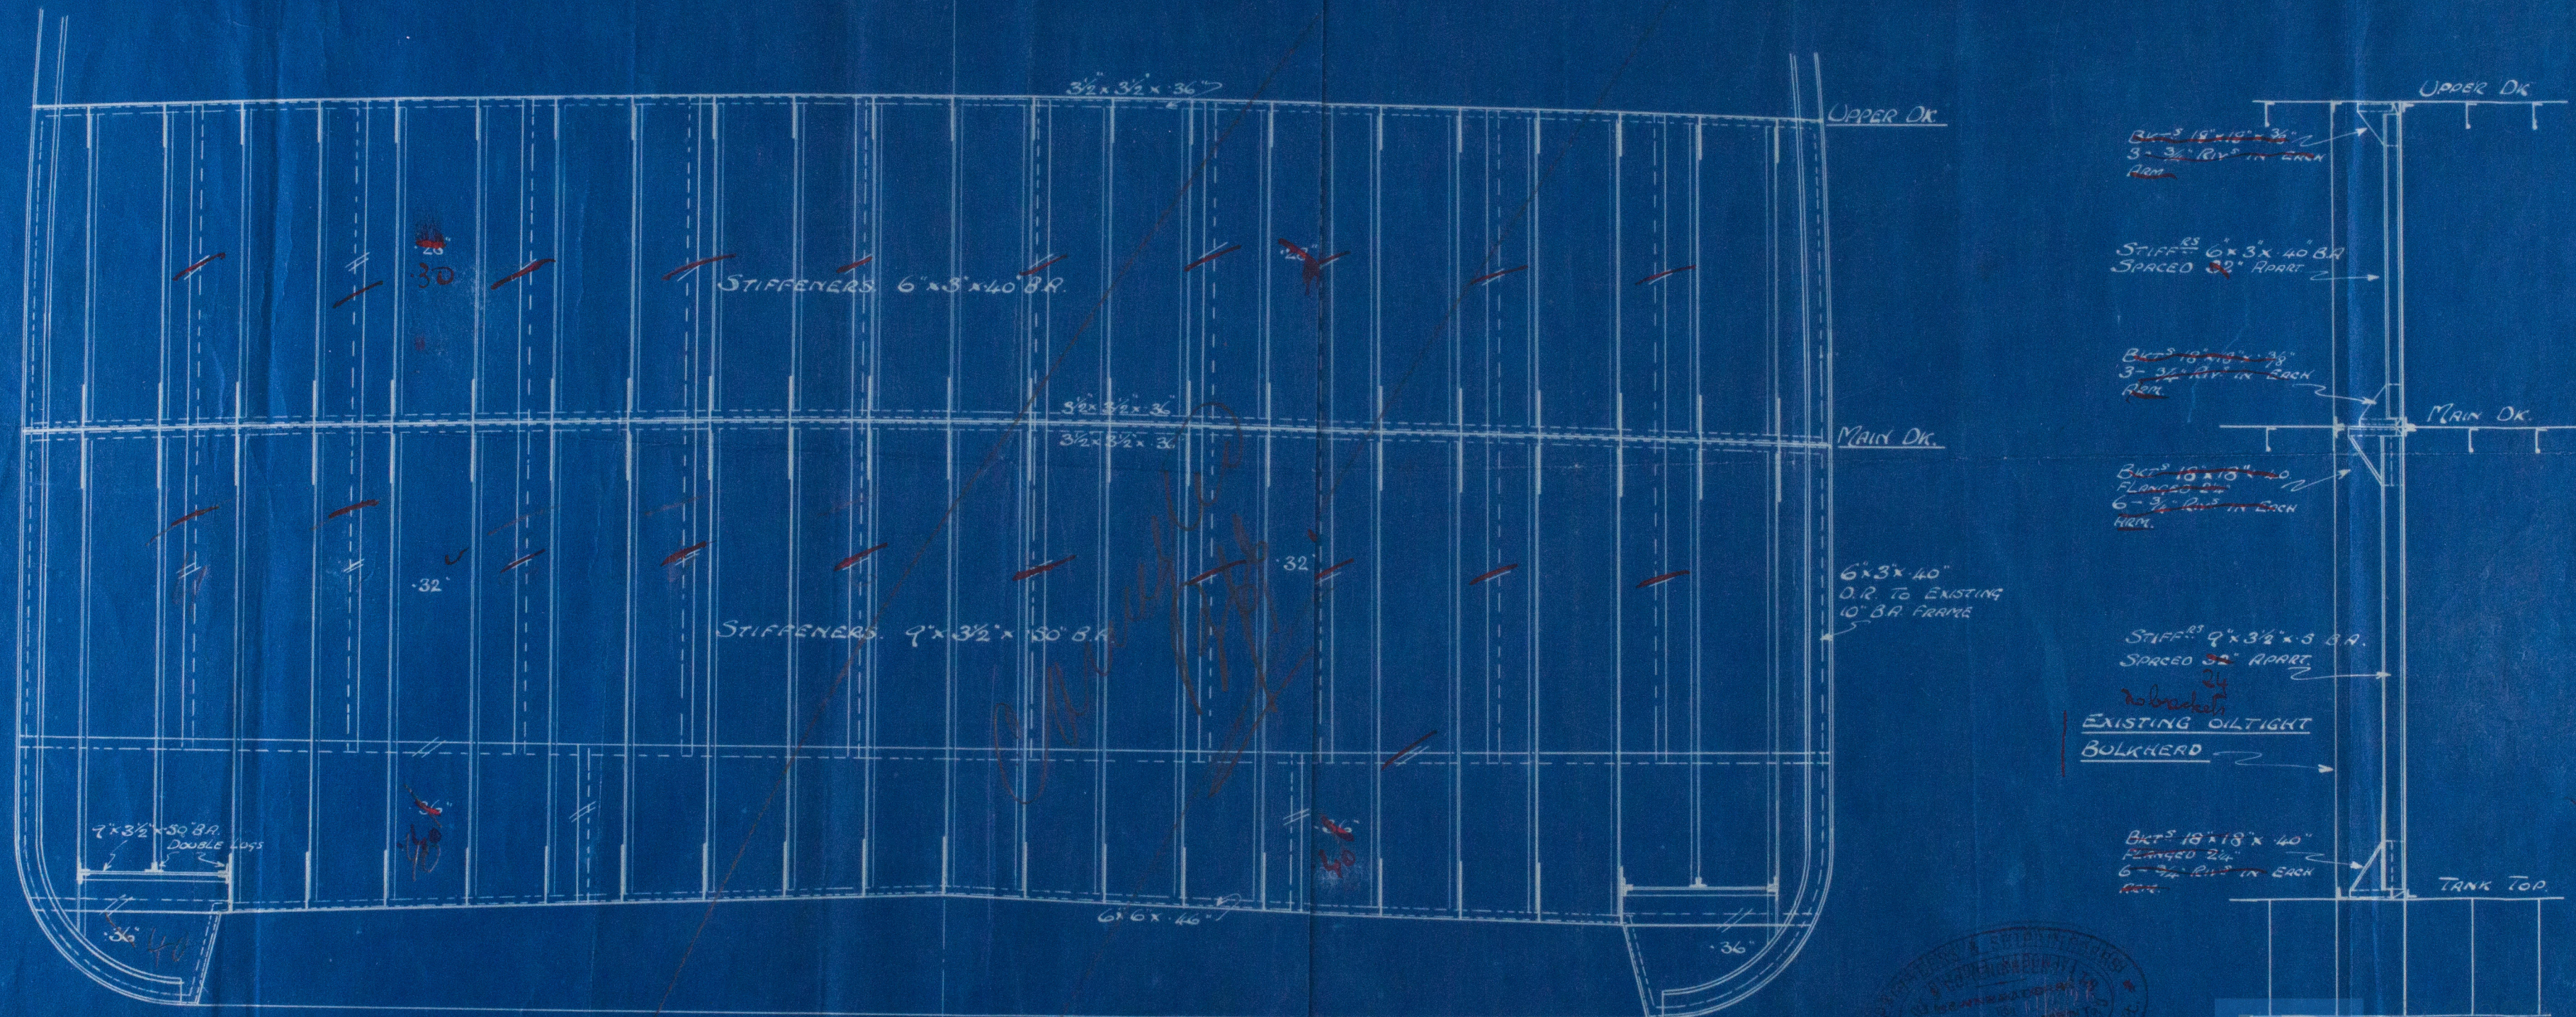

BULKHEAD 109. LOOKING FORWARD.

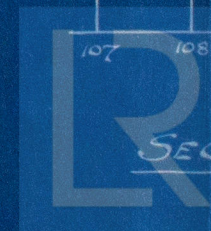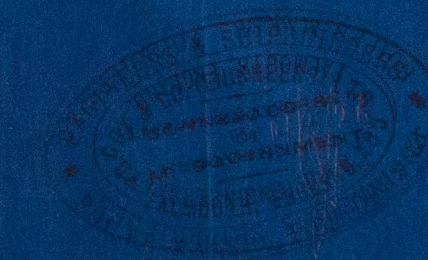


SECTION.

W53-0138

Lofferdan Bld.

X/53- 0138

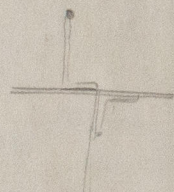

© 2020

Lloyd's Register
Foundation