



— BOILER ROOM PIPE ARRANGEMENT —
OIL FUEL INSTALLATION (TODD SYSTEM)
S. S. MIDDLESEX

DRG N°45359

2 - SHEETS. SHEET N° 1

SECTION LOOKING AFT

ENGINE ROOM

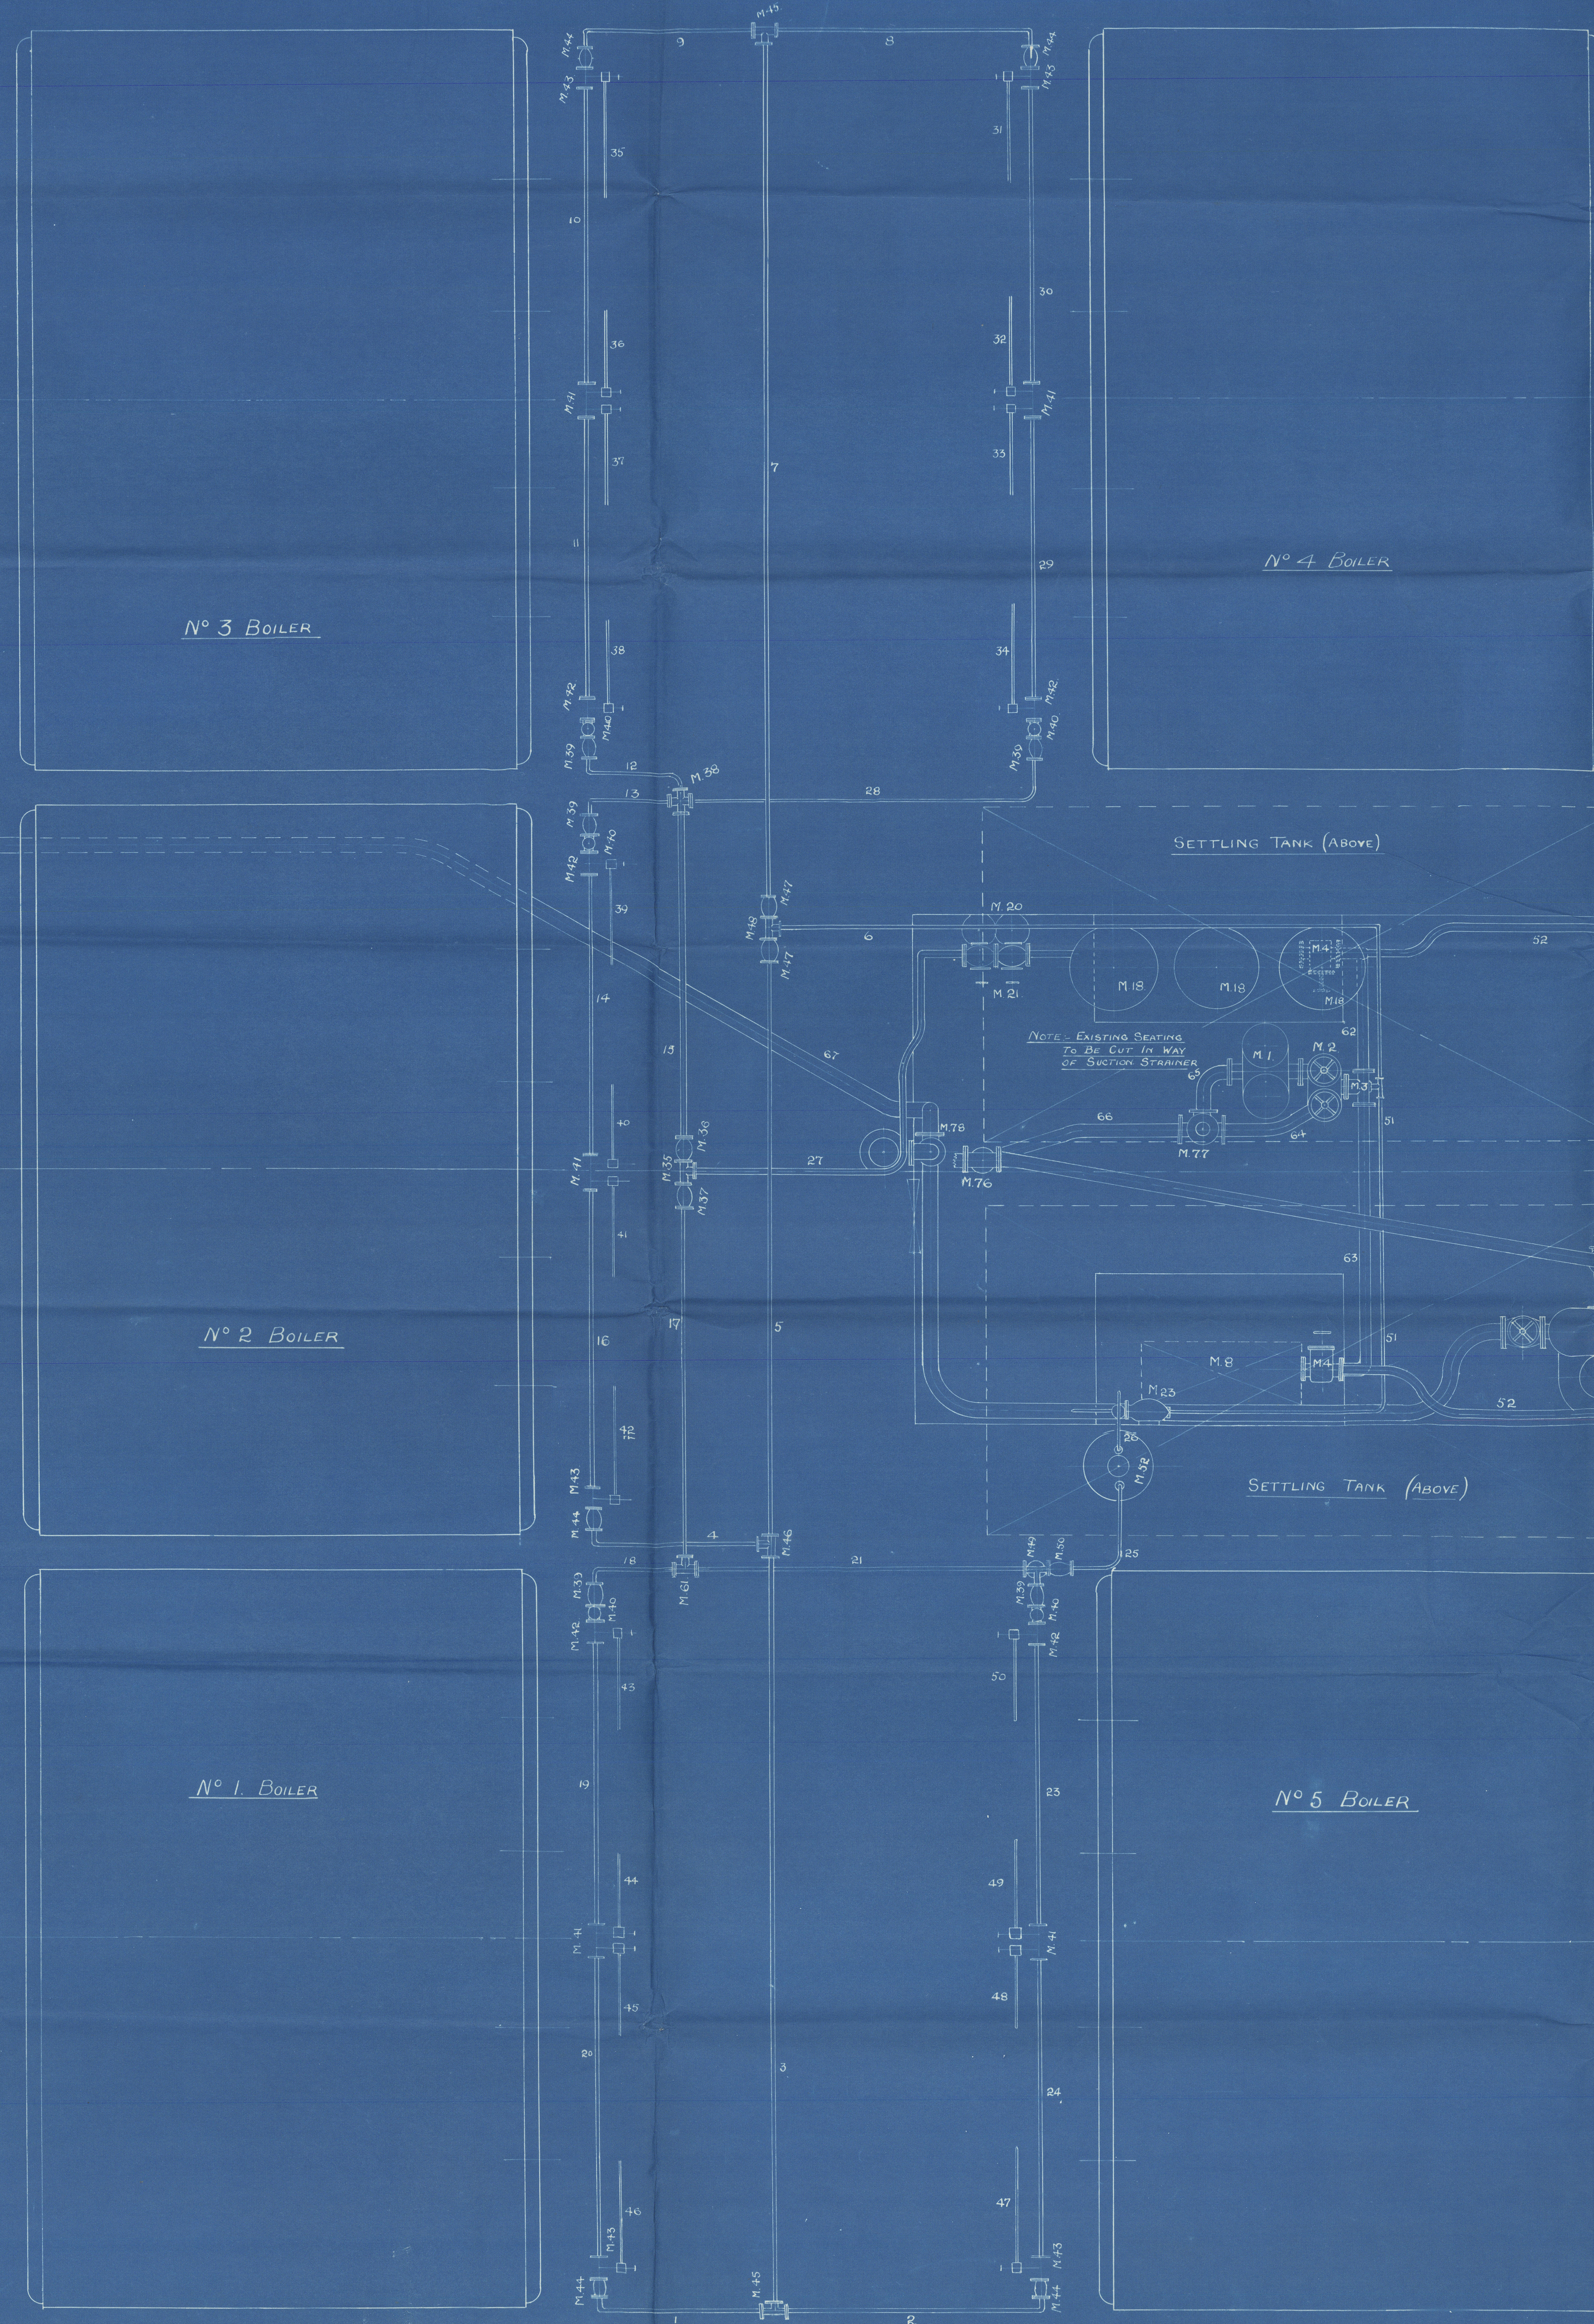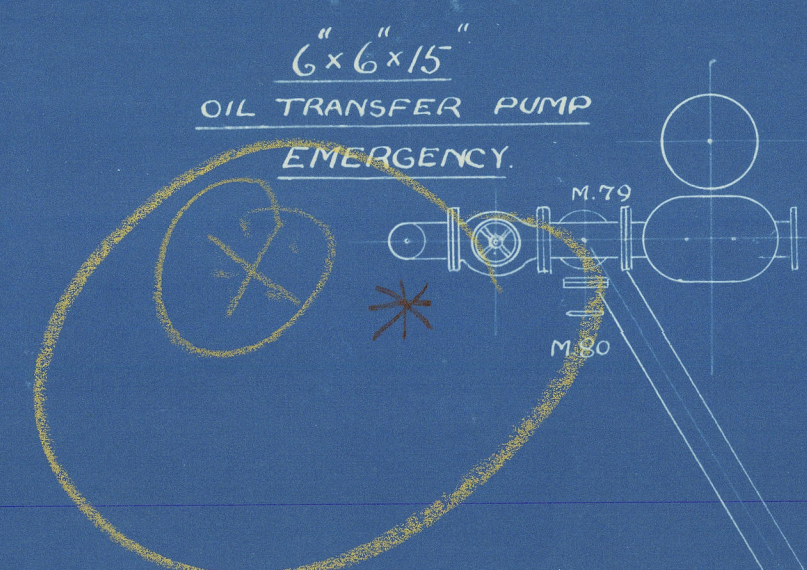

SECTION LOOKING FORWARD



* Steam supply to oil fuel pressure pumps
and fire extinguishing apparatus to be
controlled as per Sec 49 par 17 of the Rules for 1921-22

The boiler room is to be fitted with a fire
extinguishing apparatus, to be controlled
as per Sec 49 of the Rules for 1921-22.
To be completed with.

OK J.T.B.
20-11-24

27/11/24

S.P. Middlesex Lin. rept. no. 88353

Boiler room pipe arrangement.

W51-0151



© 2020

Lloyd's Register
Foundation