




# STEEL BOILER 10'-0" DIA BY 10'-0" LONG LLOYDS 90 LBS W.P.

9/11/09

N<sup>o</sup> 4093

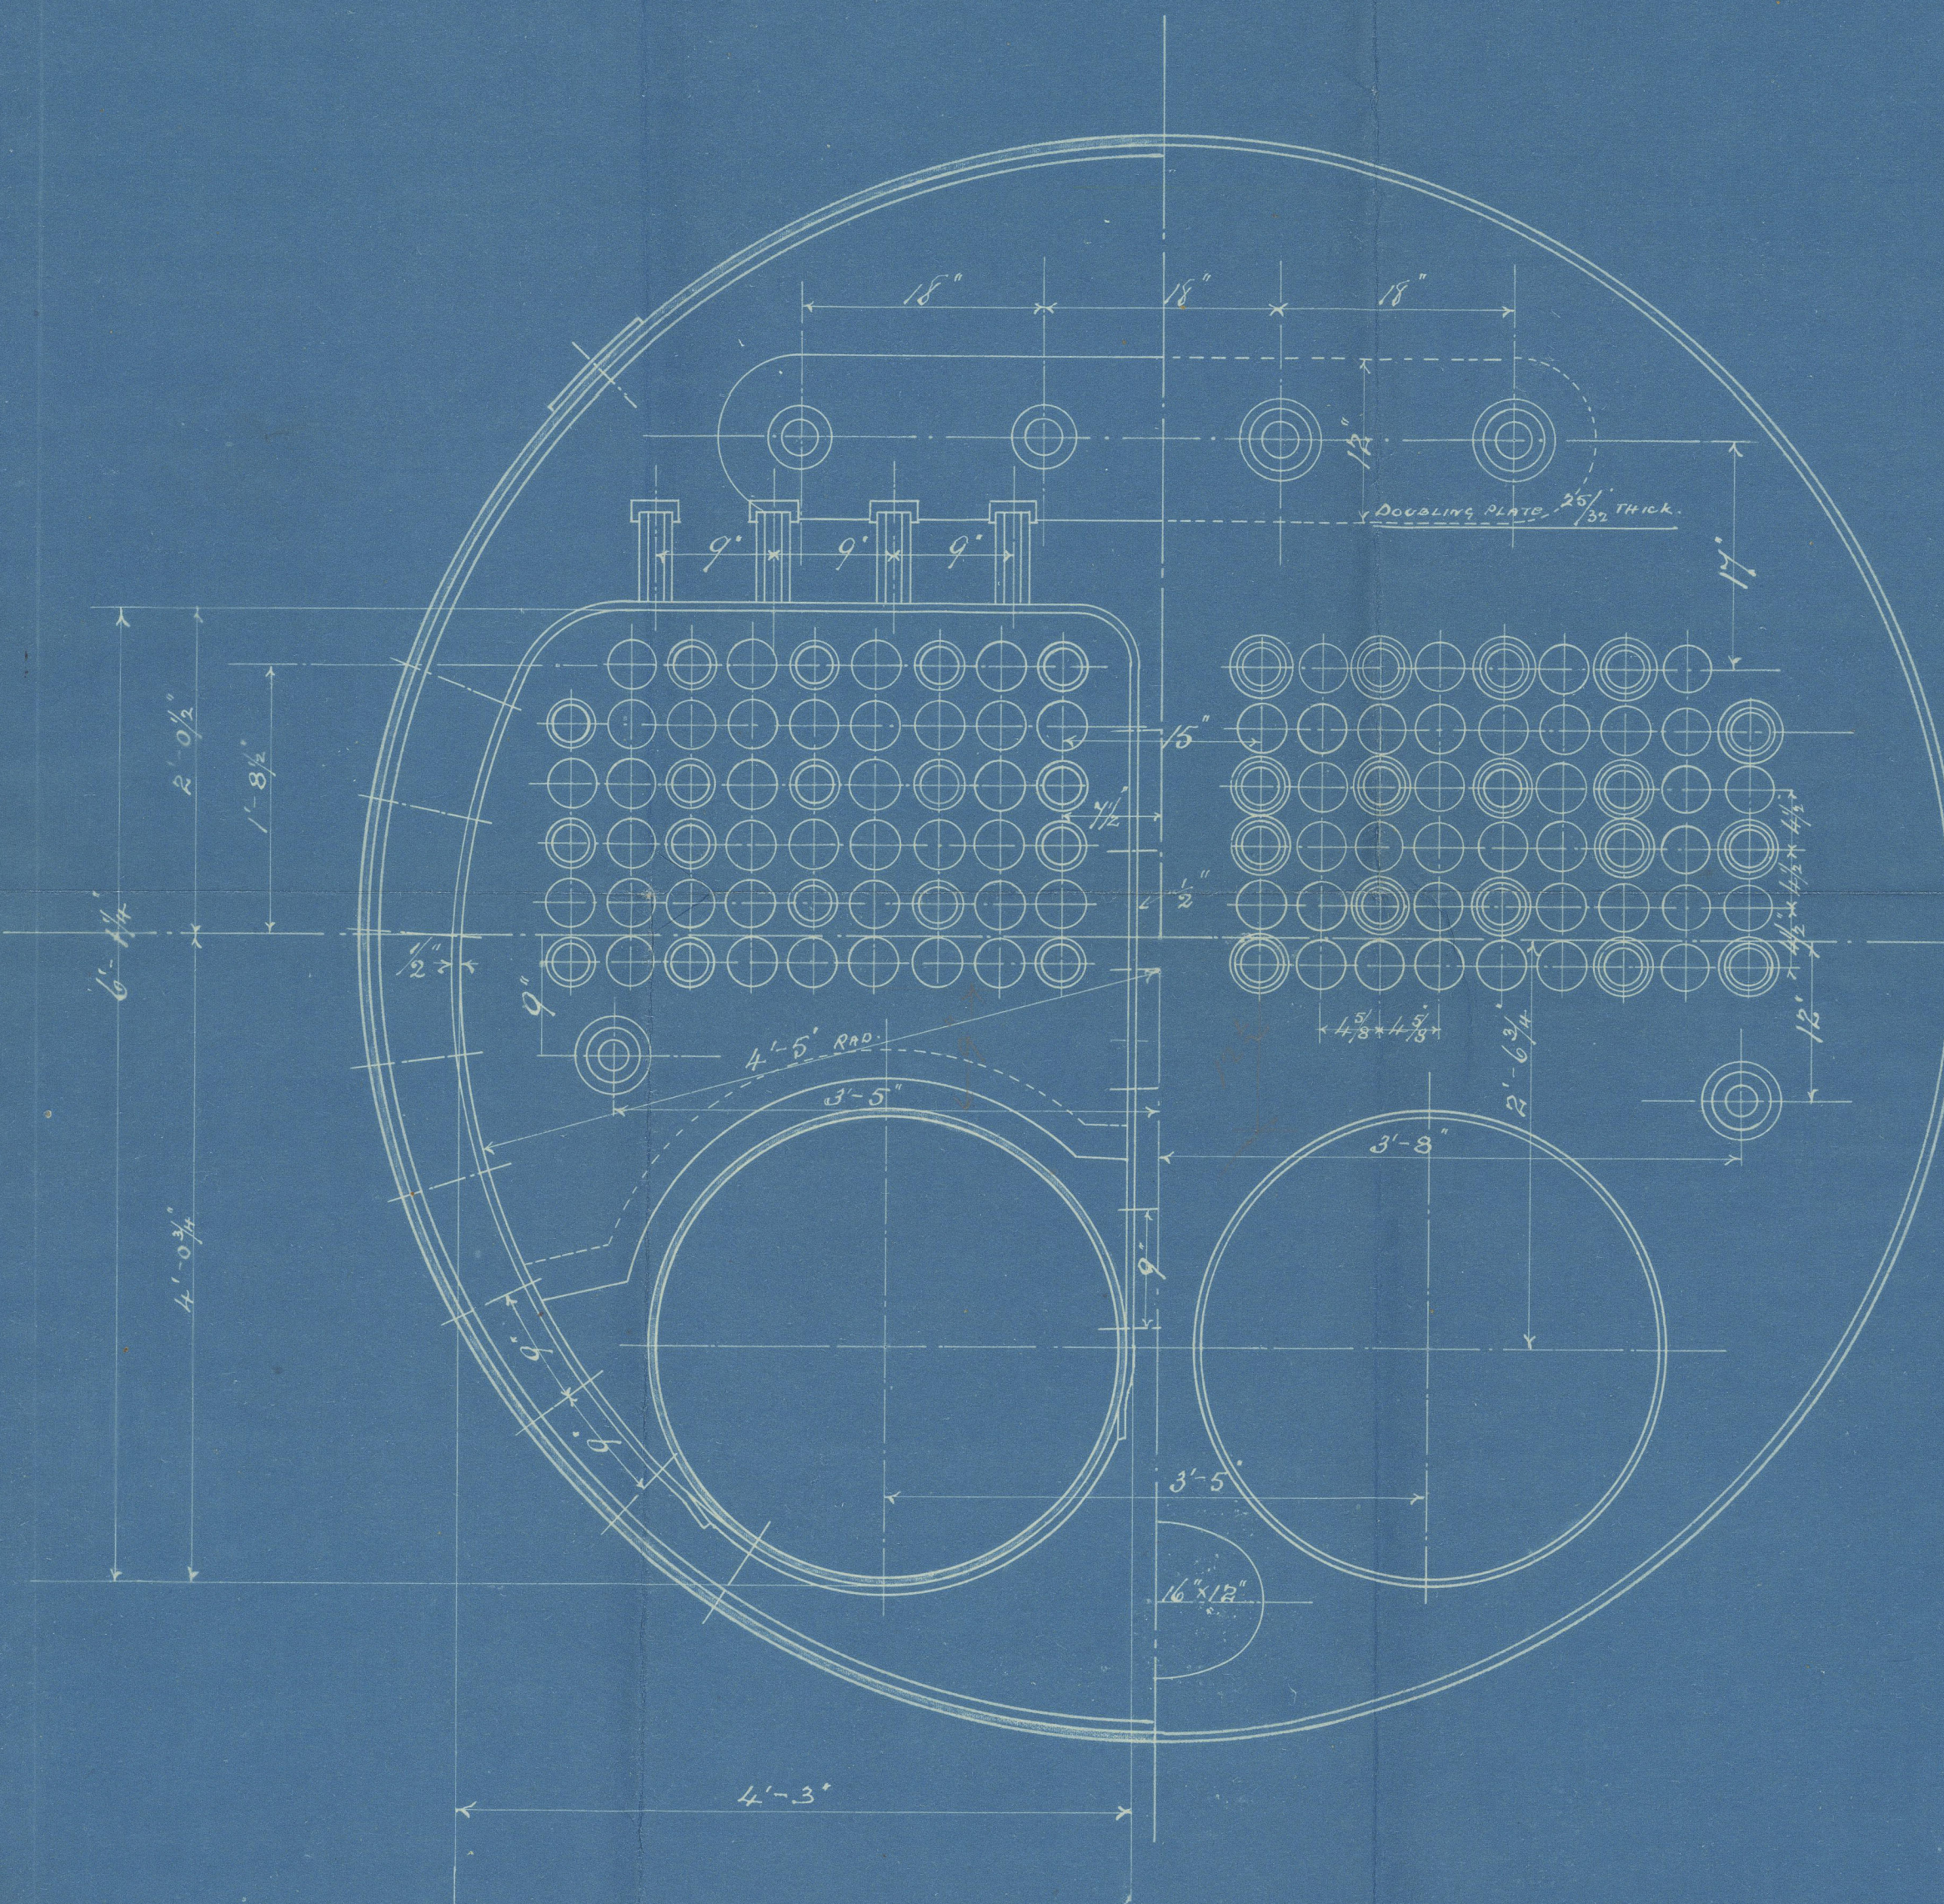


RILEY BROS (BOILERMAKERS) LTD  
STOCKTON ON TEES.

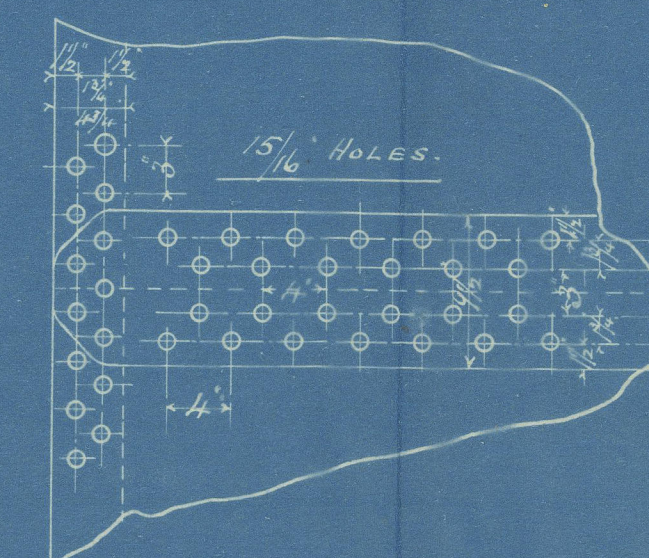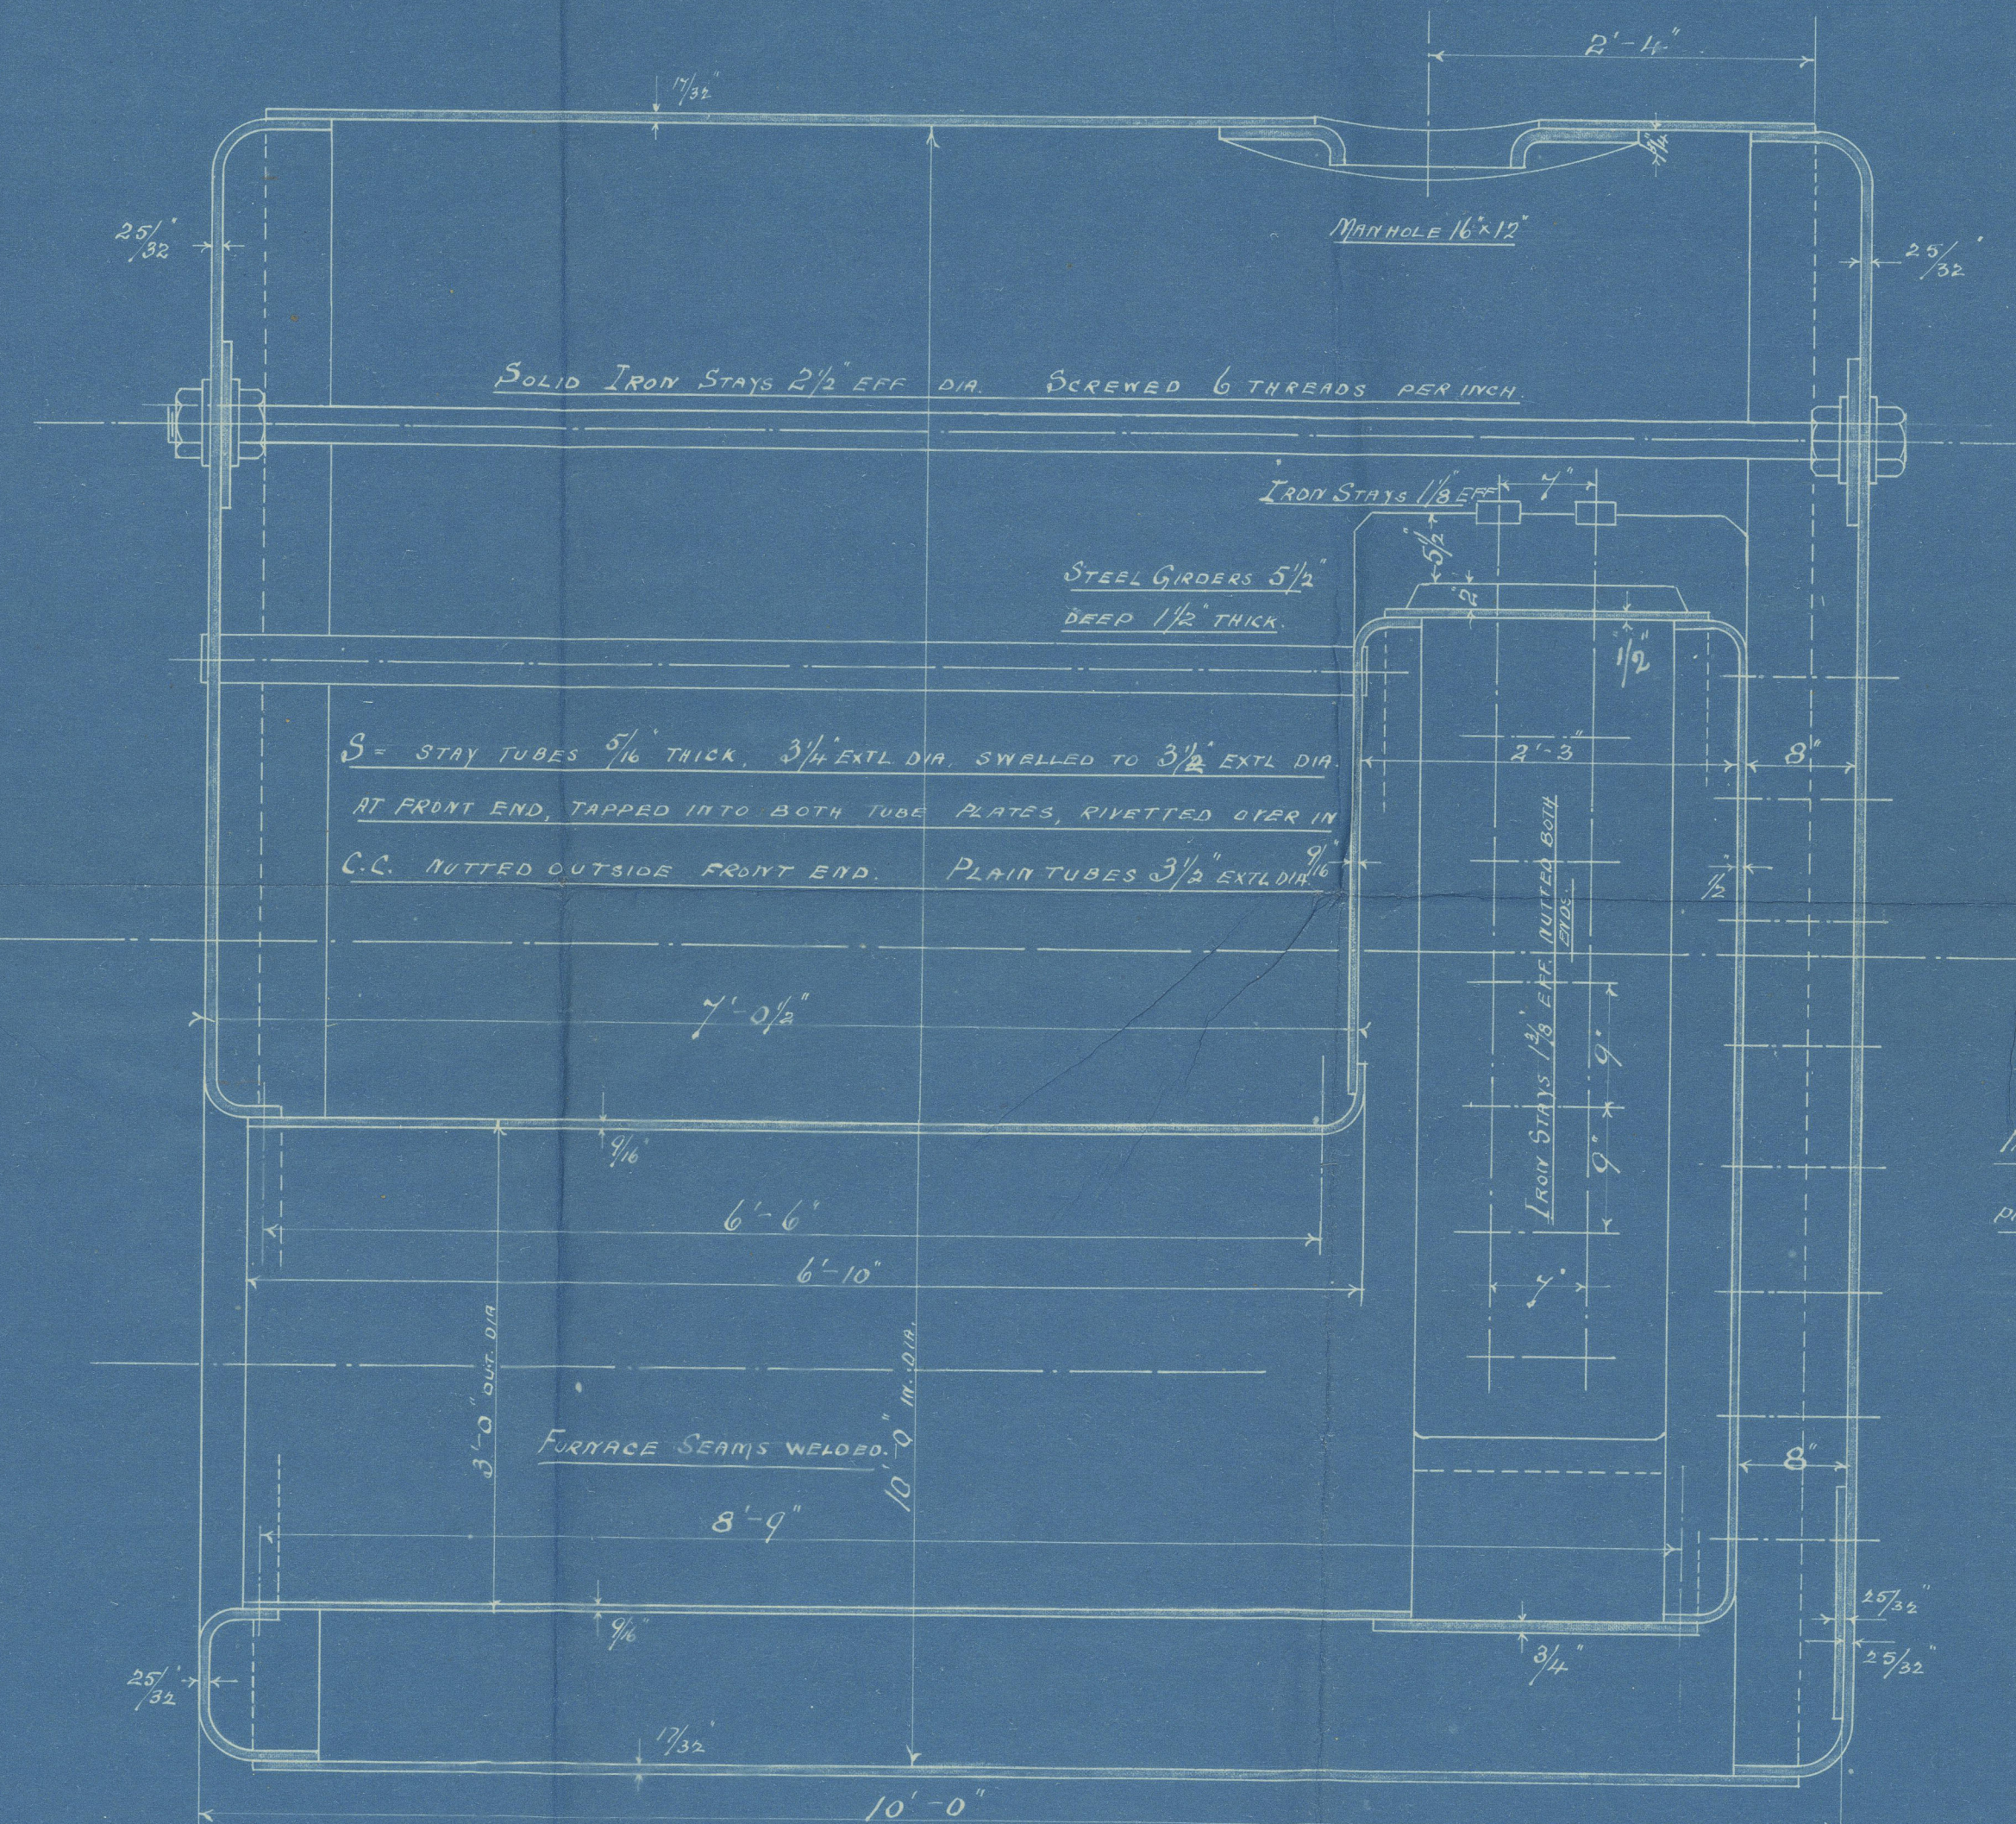

SHELL RIVETING.  
ALL HOLES DRILLED IN POSITION AFTER BENDING.  
DOUBLE BUTT STRAPS 17/32 THICK.  
SHELL PLATING OF 28/32 TONS TENSILE.

J.R.R.  
9.11.09

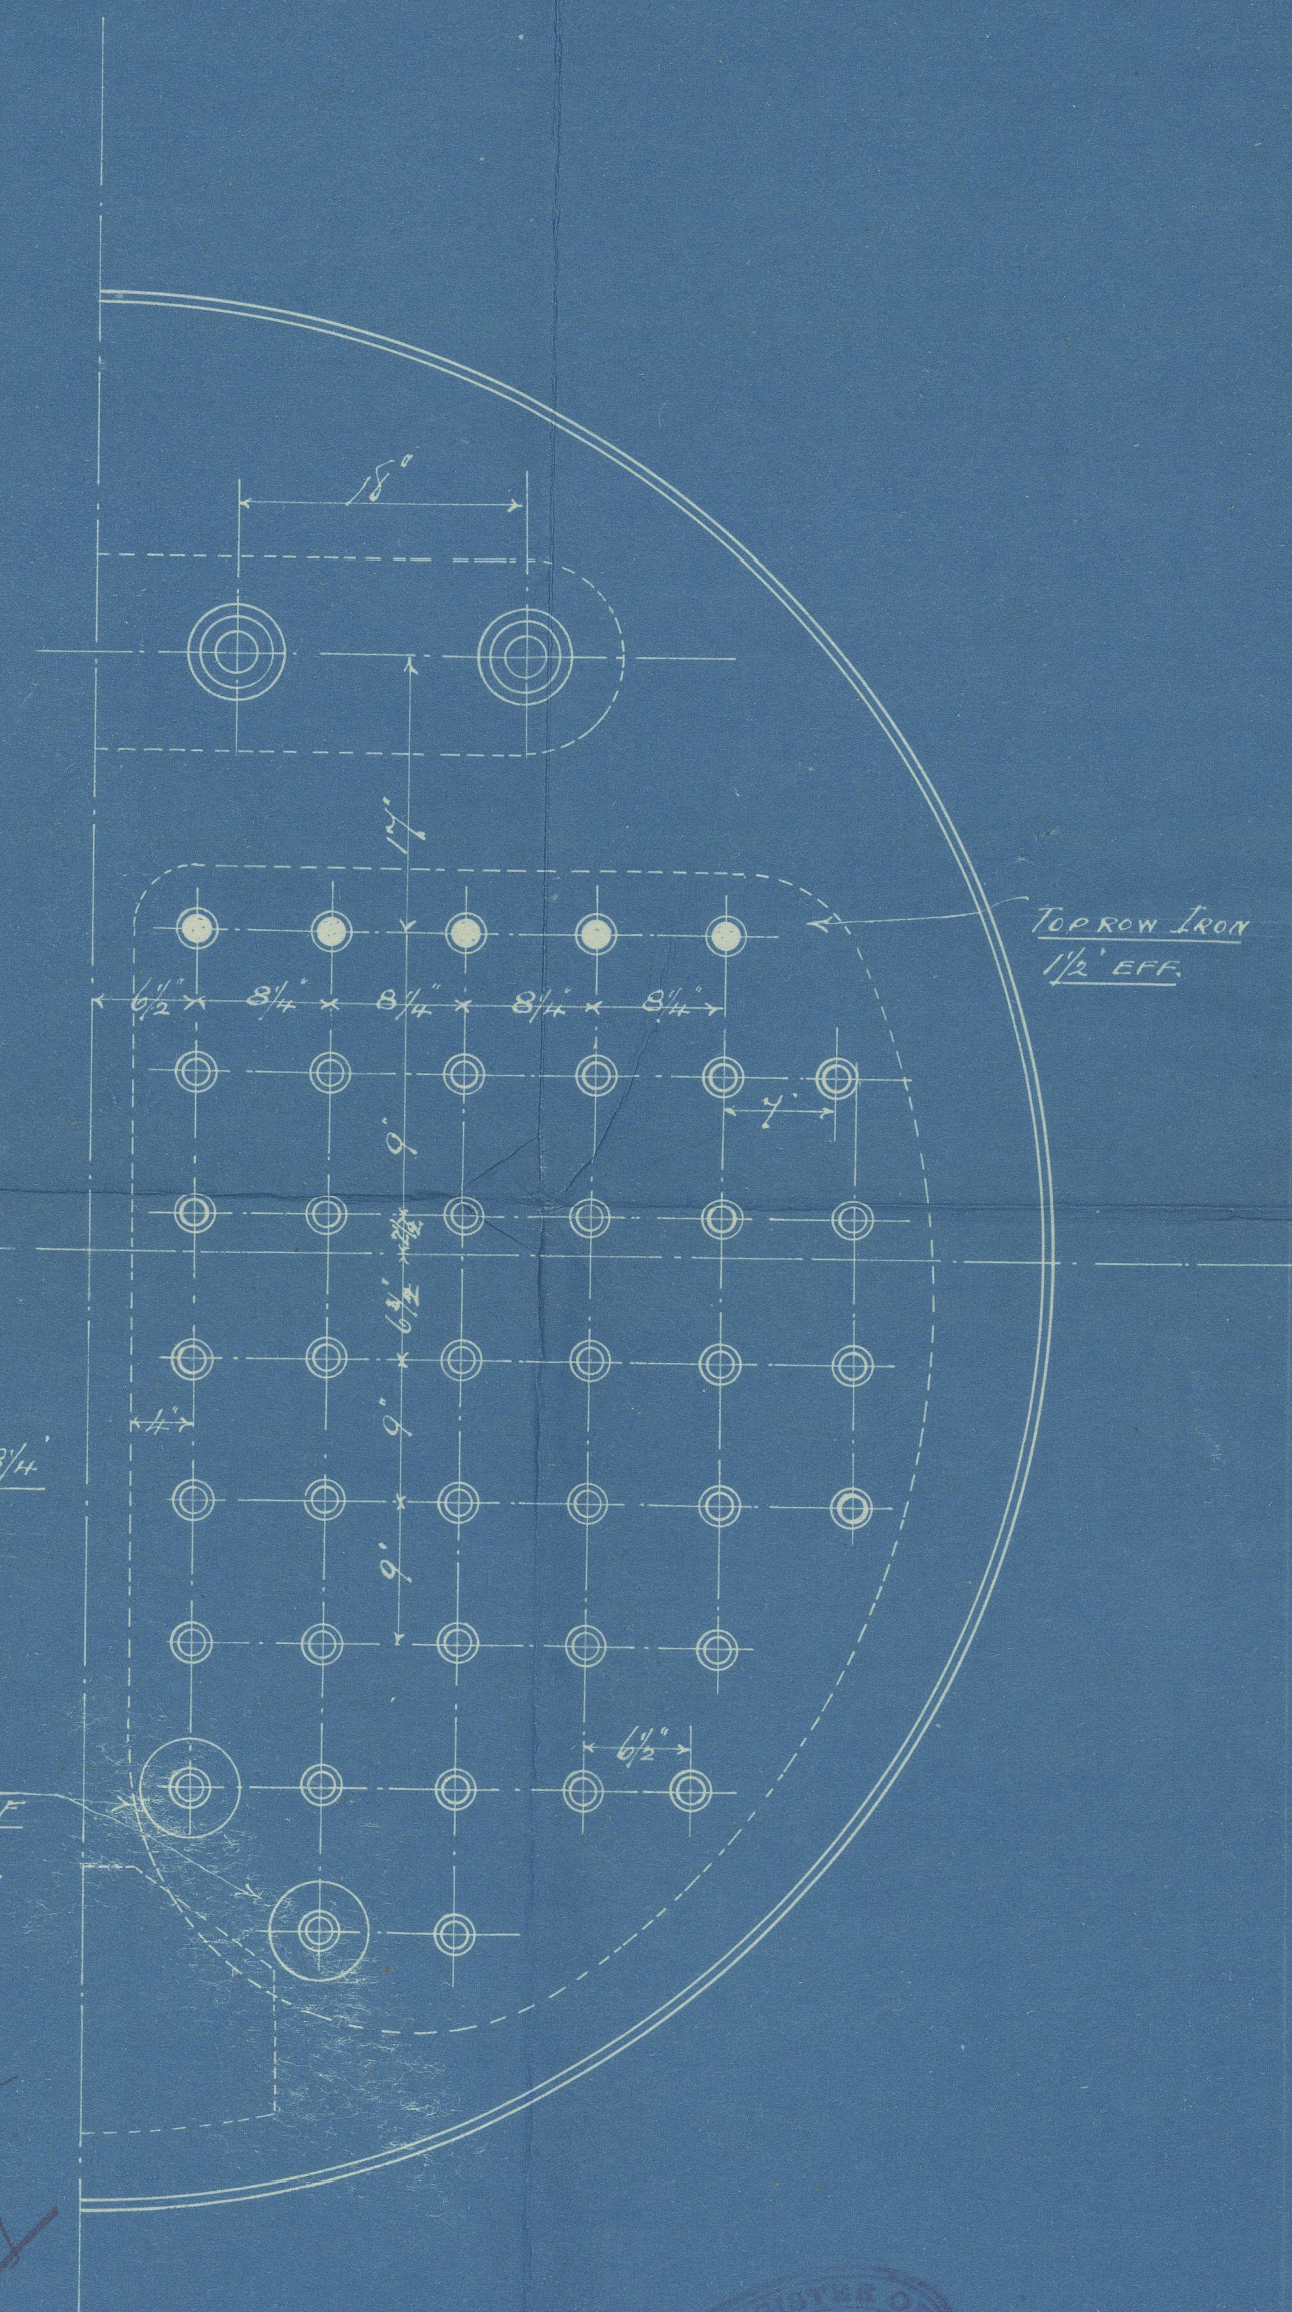

HEATING SURFACE. 863 sq. ft.

GRATE AREA. 3'-8" DIA. 33 sq. ft.





Messrs Riley Bros

Souley Boiler No 4093  
for

Messrs Richardson Duck & Co  
S. S. No 607

Working Pressure 90 lbs

S. S. "Sterndale"

No. 4353  
LLOYD'S TEST.  
180 lbs.  
6-1-10  
WM

Mdb Rpt No 6080

RETAIN



© 2020

Lloyd's Register  
Foundation

MS45-0337