


total capacity tons, F.P.T. tons, A.P.I. tons, M.I. feet


CHARACTER Machinery and Boiler

MANSEPOOL div. rfd. No 114350

STERN FRAME  
REPAIRS

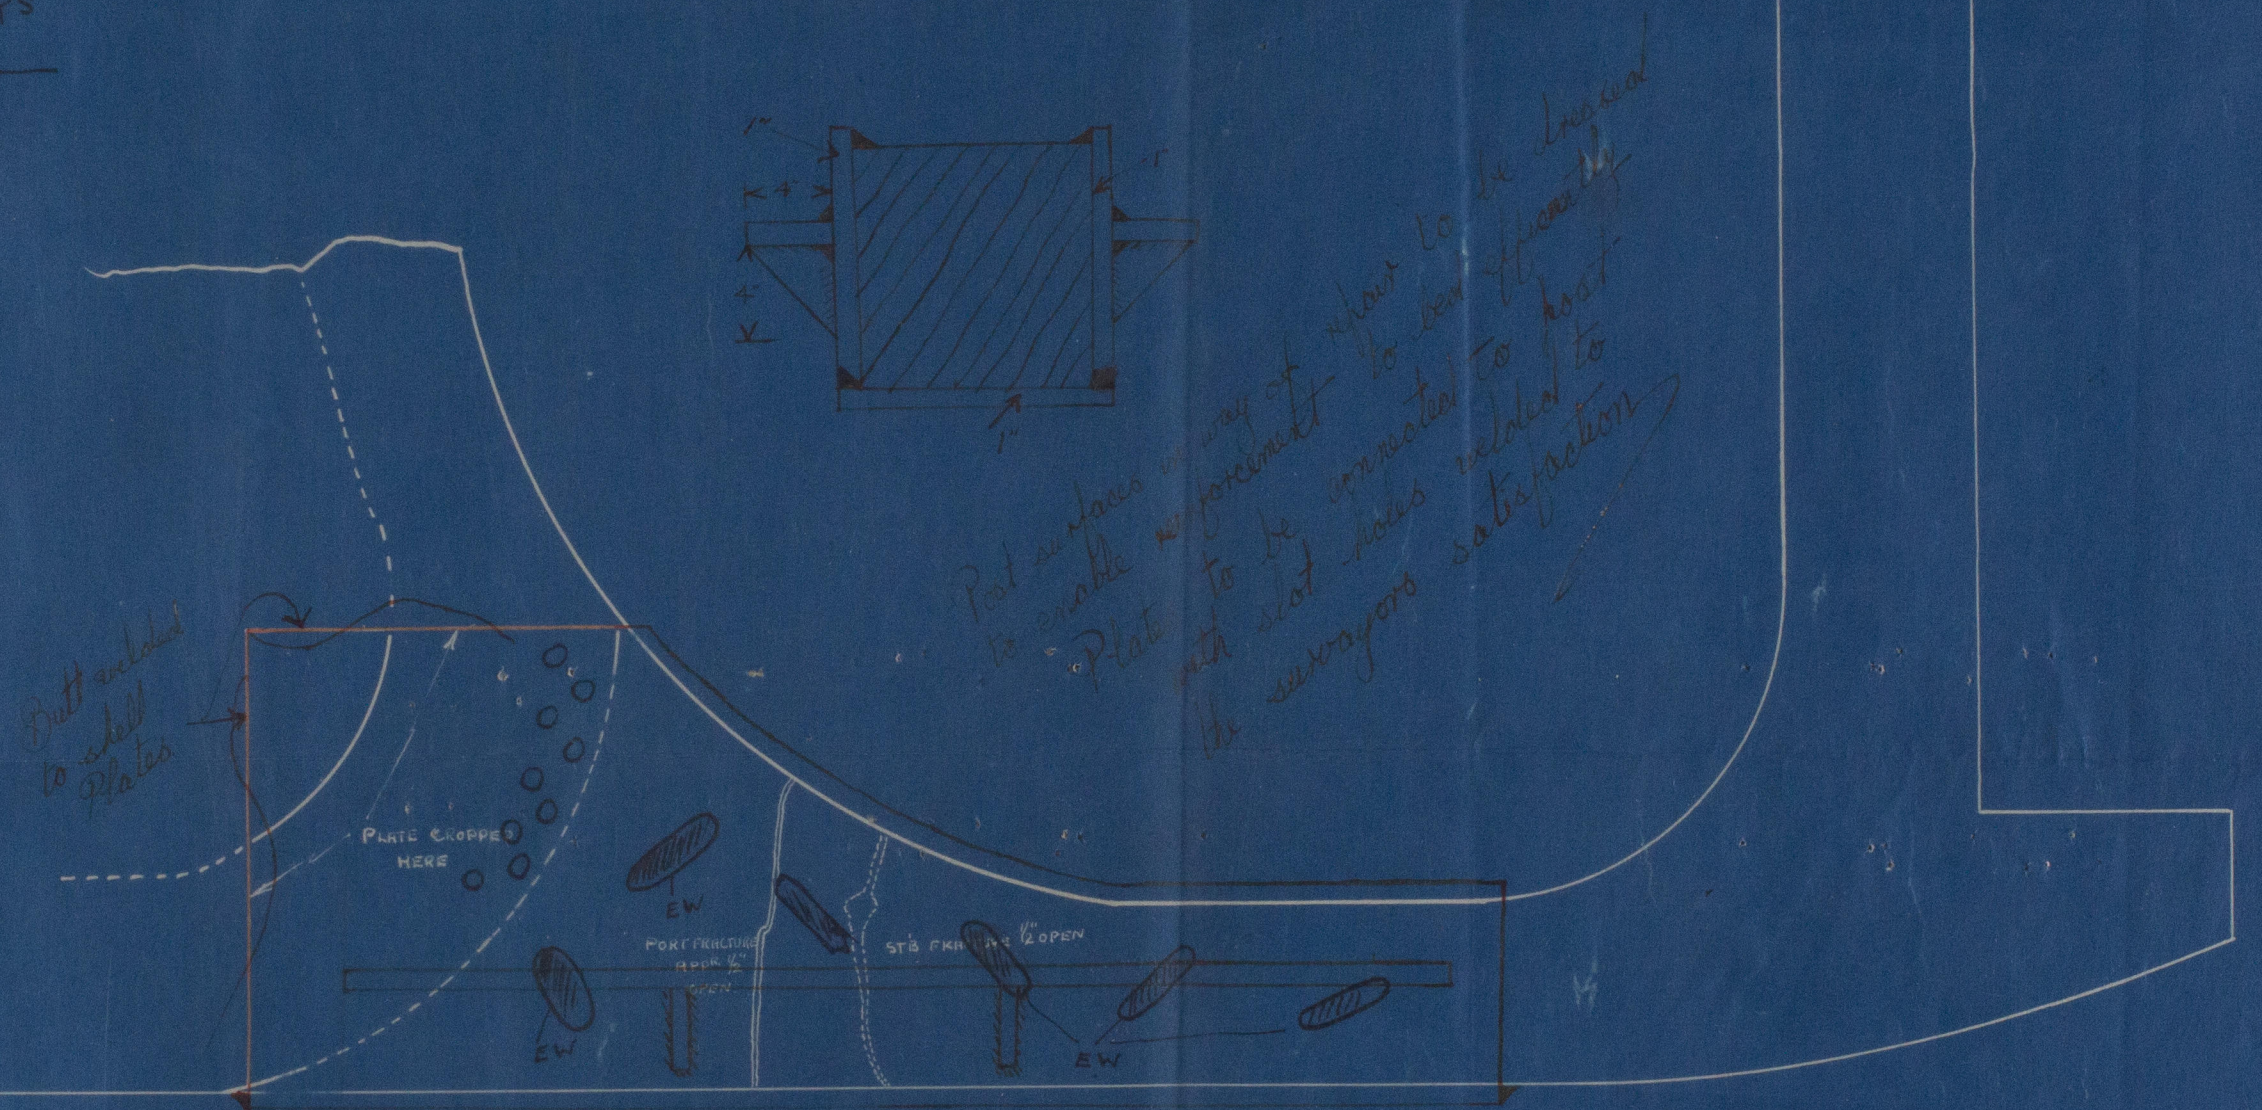

Post surfaces in way of repair to be dressed to enable reinforcement to be efficiently plates to be connected to post the surveyors satisfaction

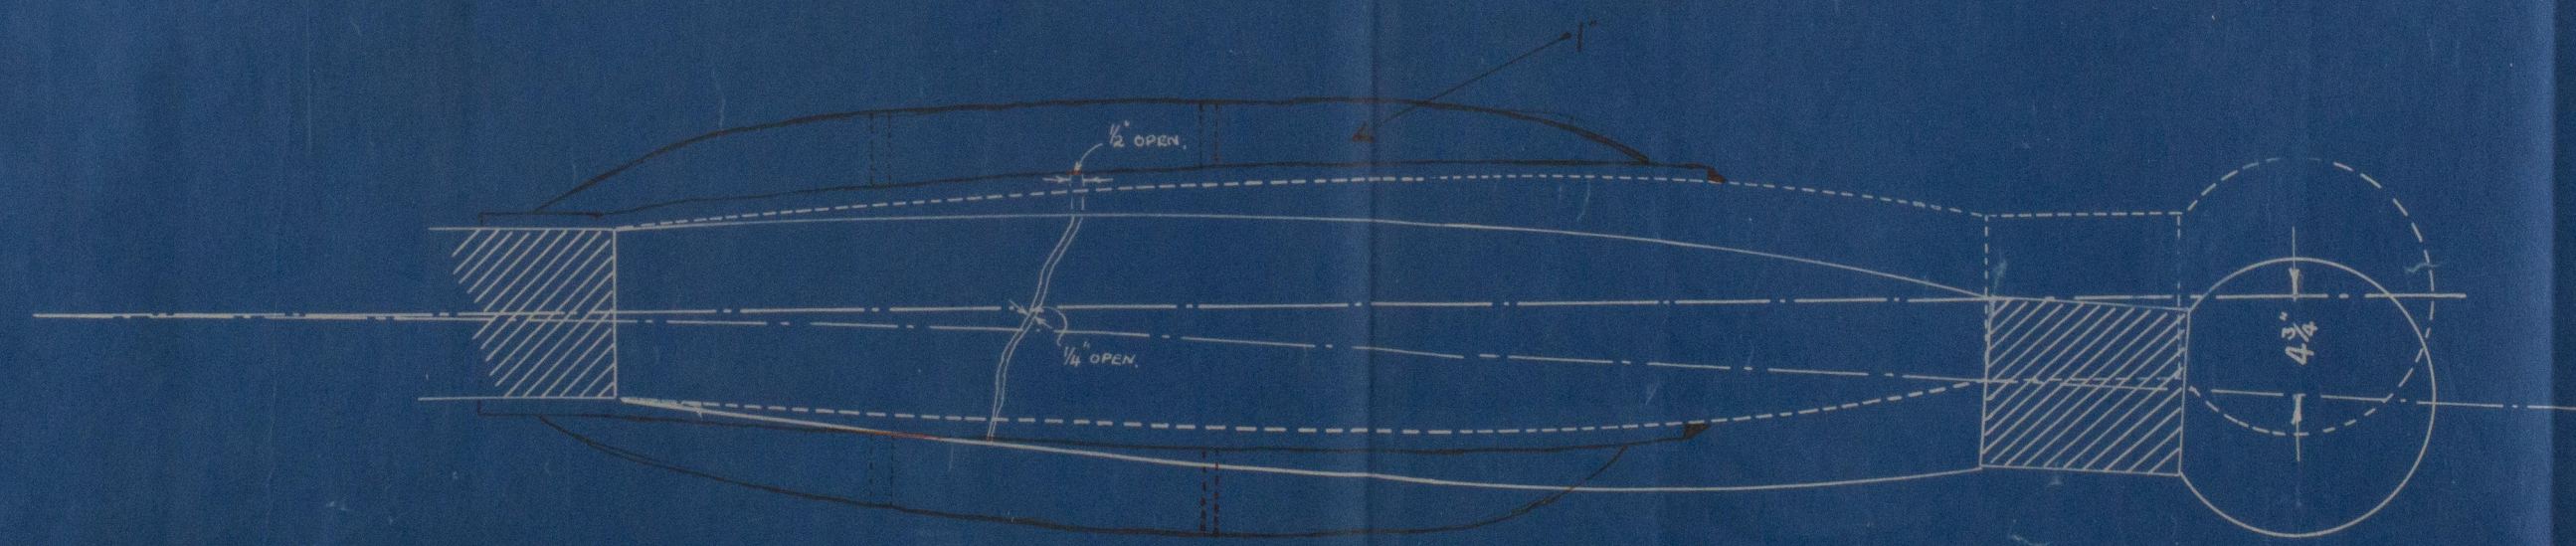

PLAN AT BOTTOM OF RACE.

All work to be to the satisfaction of the surveyors



U.S. Record No. 10092

Committee's name  
Character Assigned 100A1, Subject: H.M.  
S.S. No. 3-6.40. M.S. 1.40.  
+L.M.C. 10.39  
CERTIFICATE NUMBER  
W55-0093(12)