

Lloyd's Register of Shipping.

(Report on Vessel No. _____ Port Sunderland,)

No. ✓ SHIP FORGINGS OR CASTINGS.



THE WORDS FORGINGS OR CASTINGS, IRON OR STEEL, SHOULD BE STRICKEN OUT AS MAY BE REQUIRED.

I have to report that the undermentioned Iron or Steel Forgings or Castings, manufactured by Messrs Sunderland Forge & Eng Co. Ltd of Sunderland for the Vessel No. 303, being built by S. P. Austin & Sons of Sunderland, have been inspected by me as set forth below and found to be, so far as can be seen, Sound

Mark on Forgings or Castings.


Lloyd's
No. 414

D. D. Williamson.

Sunderland, 14-1-19

	STERN FRAME.	RUDDER FRAME.	STEM.
Material*	<u>Scrap Iron</u>	<u>Scrap Iron.</u>	/
How made	<u>Forged ✓</u>	<u>Forged ✓</u>	
Dimensions	<u>8' x 6' 9" x 6"</u>	<u>9 1/2" dia to 7 1/2" dia</u>	
Progress on Inspection	<u>Finished</u>	<u>Forged & Finished</u>	
Date when Inspected	<u>16-8-18,</u>	<u>4-10-18 to 14-1-19</u>	
CASTINGS.			
Tests on Standard Test Pieces.			
Tensile Test—			
Tons per square inch			
Extension per cent. ...			
Cold Bending Test—			
Angle before fracture			
Drop Test—			
Height from ground ...			
Hammering Test—			
If made according to Rules and found satisfactory ...			

SKETCHES OF FRAMES SHOWING POSITION AND DESCRIPTION OF WELDS OF FORGINGS.

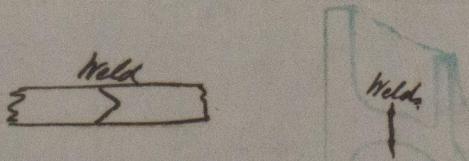

Fee (if any chargeable) £

To be paid at ✓



© 2021

Lloyd's Register Foundation

Sunderland.

S.P. Austin & Son.

Steam & Rudder Frames.

Forging Report

N^o 303.

s.s. "Mardinian".

Std Rpt do. 27606



© 2021

Lloyd's Register
Foundation