


Nos 556 & 7. S/s.

Sketch shewing amendment to length of
Nos 2 & 3 Hatchways (13 frame spaces instead of 12)


— $\frac{1}{8}$ " = 1 foot —

Hatch Webs 18×34 at centre to 14×34 at ends with brackets
mountings dble top & bottom $4 \times 3 \times 40$

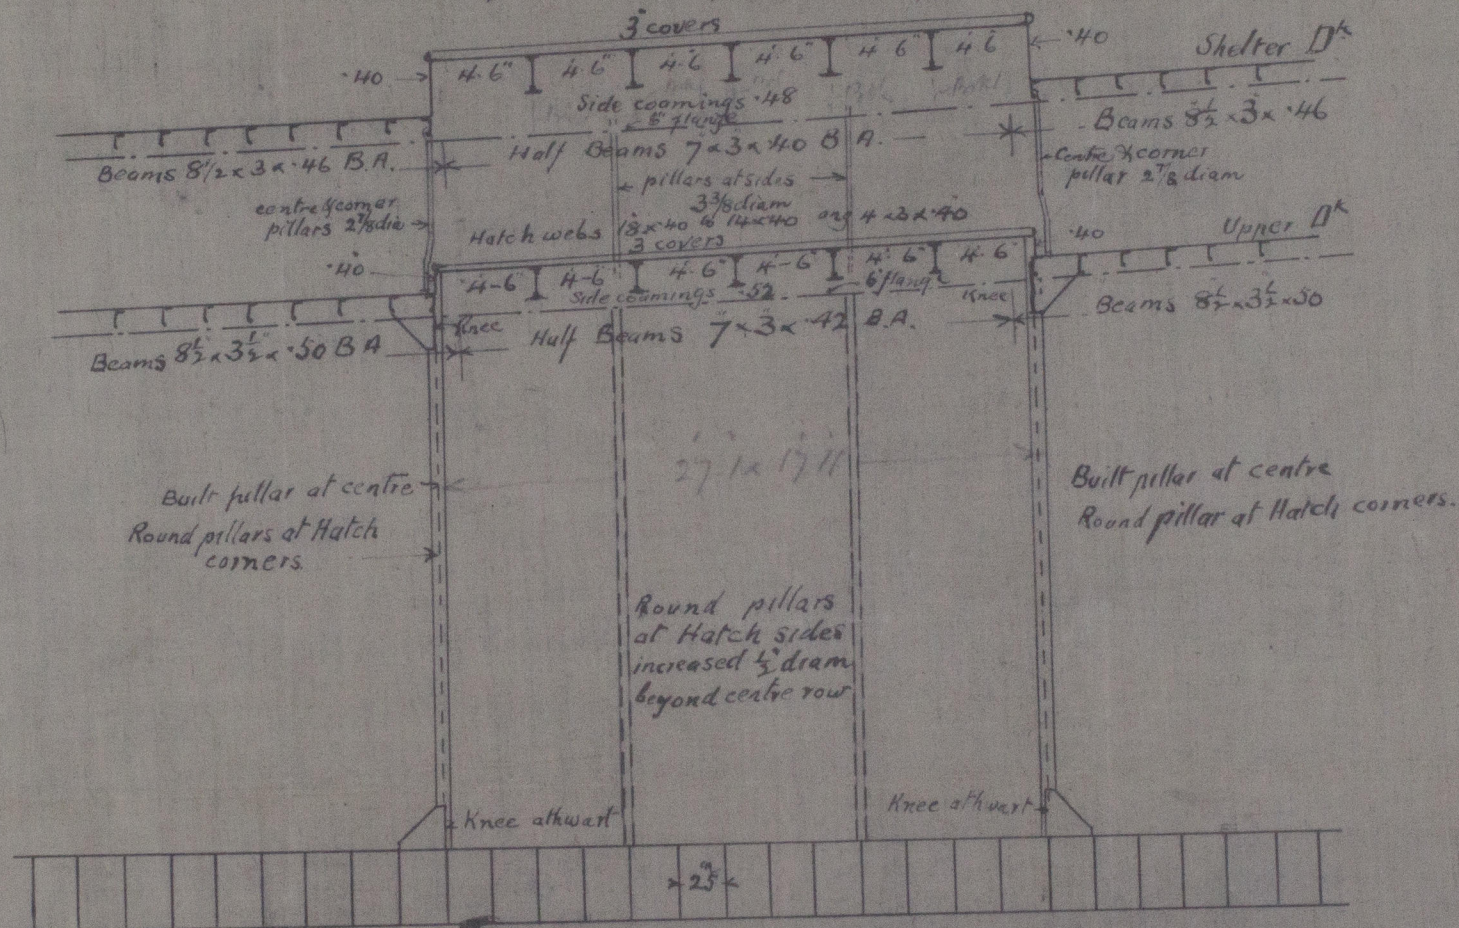

Corrected to Lloyds approved plan
29.1.15

WS51-0208

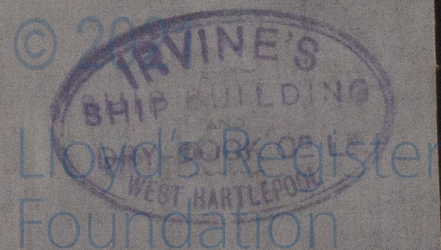

Irvine S.B. & D.D. & Co. Ltd.

S.S. No 556.

Alteration to Nos 2 & 3

Hatchways.

No. 556

W 551-0208



© 2021

Lloyd's Register
Foundation