


CENTRE ROW SUPPORTS 6\"/>

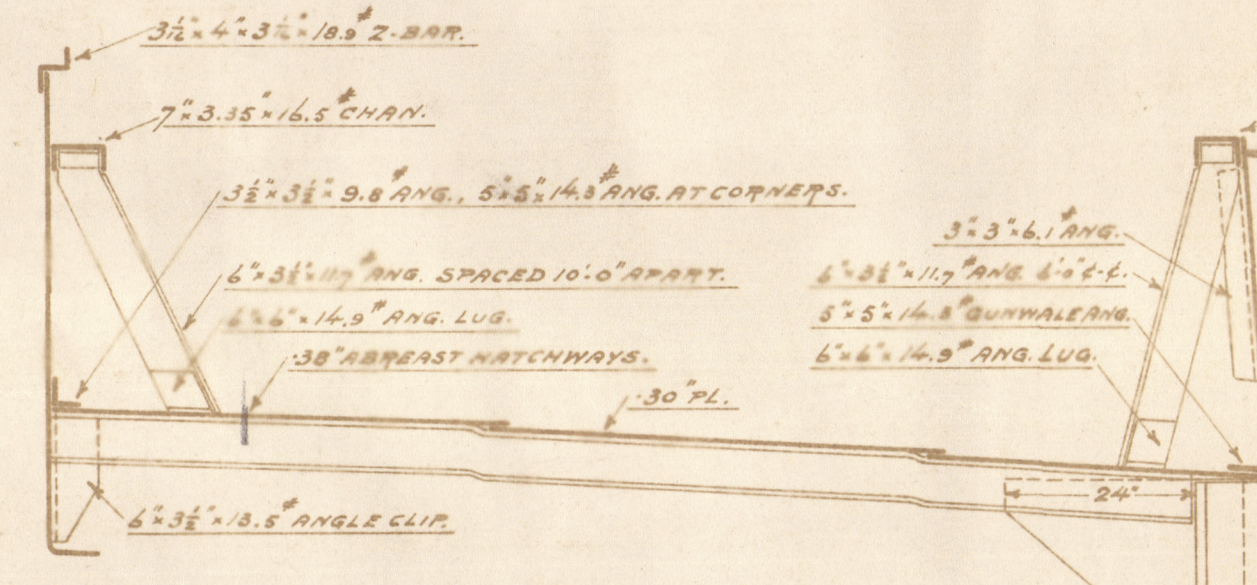


DETAIL DRAWING OF HATCH ENDBEAMS, PILLARS AND GIRDERS TO BE SUBMITTED.

NO. 14 = 66.5
2nd = 16738
5676.0 = 10.9

FRAMES 9\"/>

NOTE: UNSPECIFIED DETAILS AS PER RULES.
EQUIPMENT AS PER RULE.
SIDE STRINGERS TO PAINTING ARRANGEMENT 3 to be submitted.
FORM, AS REQUIRED.

SIDE PLATING 56\"/>

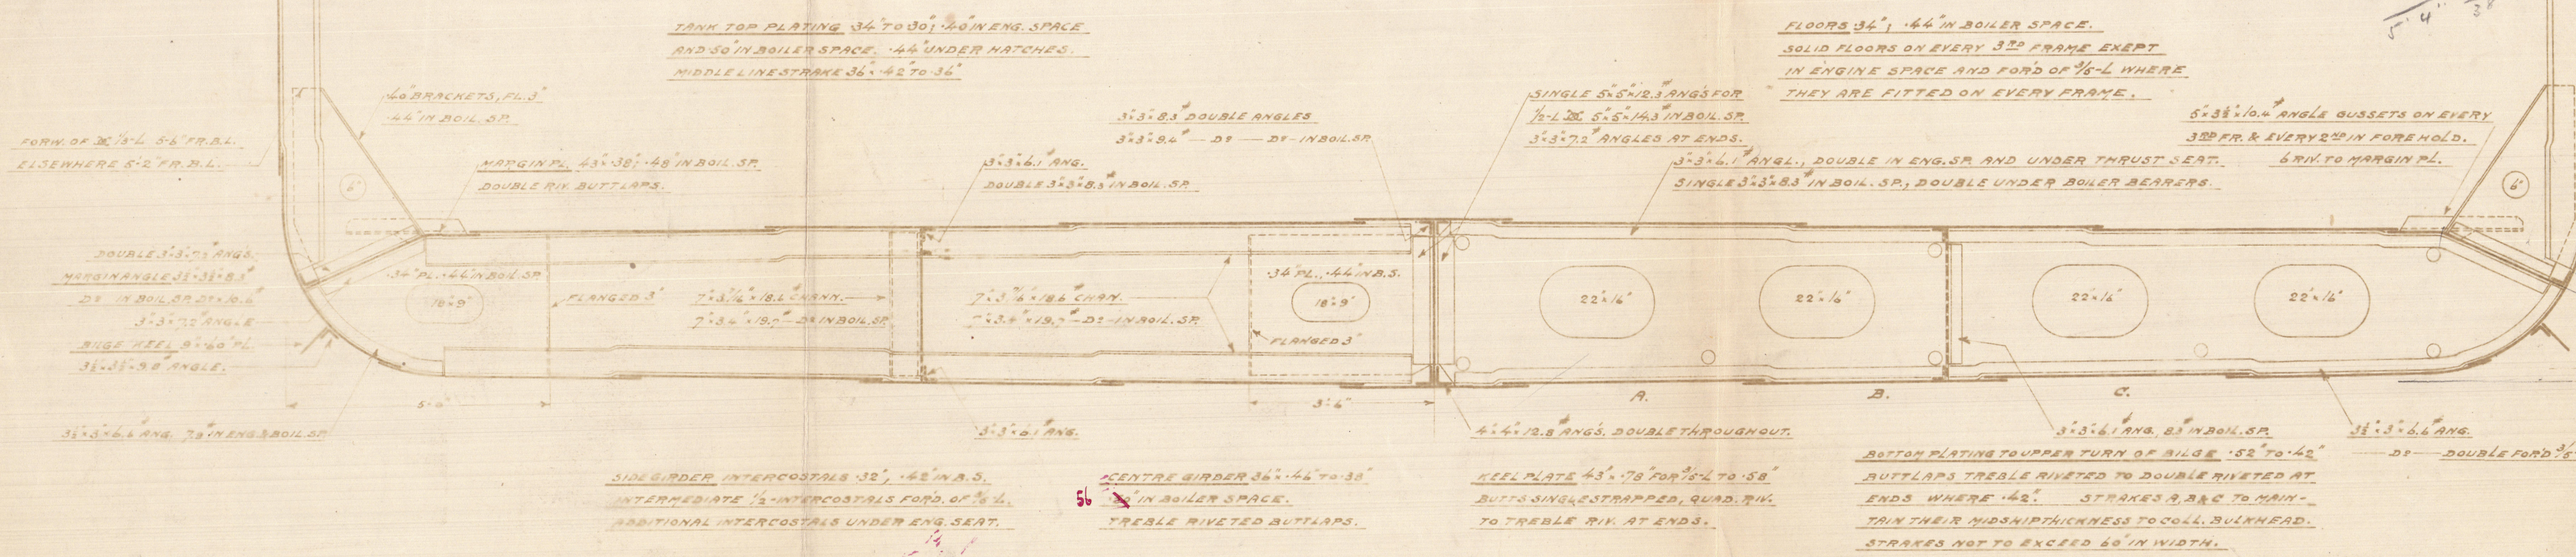

London
APPROVED
LLOYD'S REGISTER OF SHIPPING
NOV 16 1917
NEW YORK
MIDSHIP SECTION
OF
SINGLE DECK GENERAL CARGO STEAMER
LLOYD'S CLASS #100 A.1.
SCALE: 1/2\"/>



Canadian Allis-
Chalmers.

4/s. War Vixen
Buffalo. No. 69:

300-1-2-3.

M/S

M. S.

Gen. Box. 2372.



© 2021

Lloyd's Register
Foundation

W 553-0011

1698
1810
2015
2015
1258
58
1057



© 2021

Lloyd's Register
Foundation

W553-0011