


24.4.20

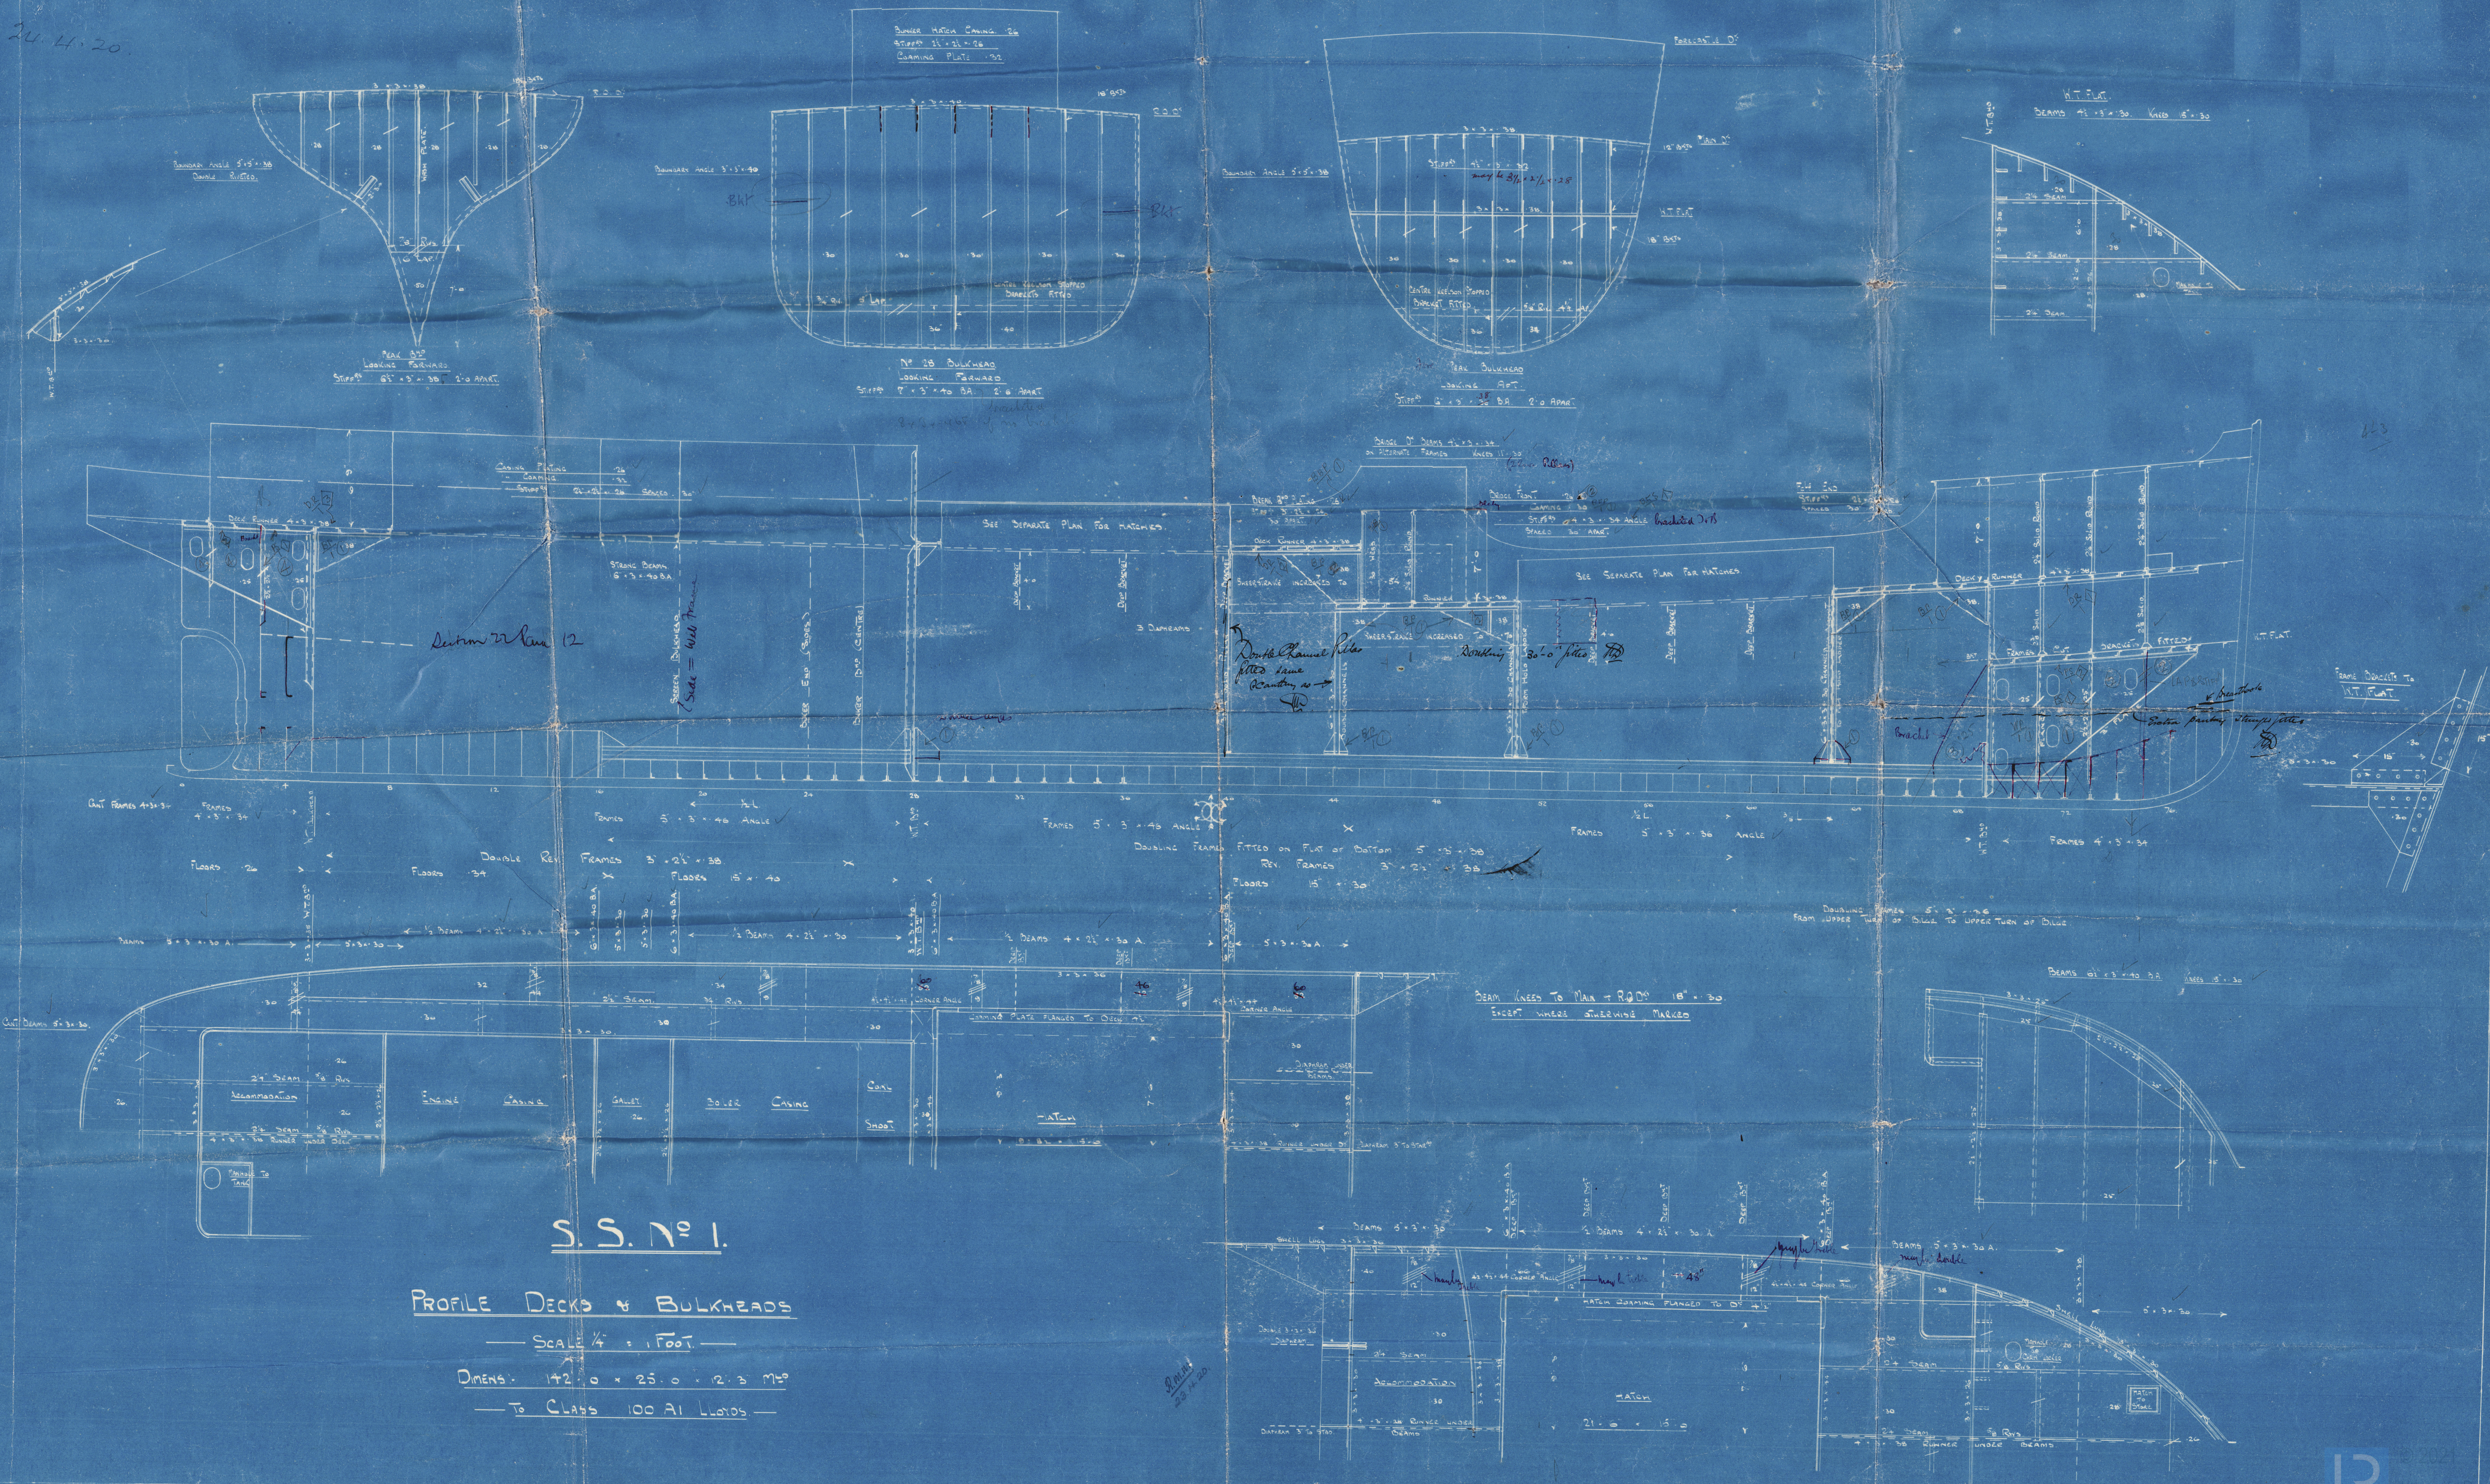

S.S. No 1.

PROFILE DECKS & BULKHEADS

SCALE 1/4" = 1 FOOT.


TO CLASS 100 A1 LLOYDS.



PITCHERS

S.S. N° 1

PROFILE +  
BULKHEADS

S. Braemore.

San Rpt 84648



© 2021

Lloyd's Register  
Foundation

W553-0106