






J & D. MORRIS LTD.

S. S. No. 64.

PROFILE & DECK PLANS.

(AMENDED.)

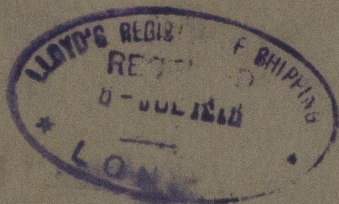

S. S. "SQUADRON"  
NEWCASTLE ON TYNE.

Report No. 70939.

© 2020

Lloyd's Register  
Foundation

W560-0253