
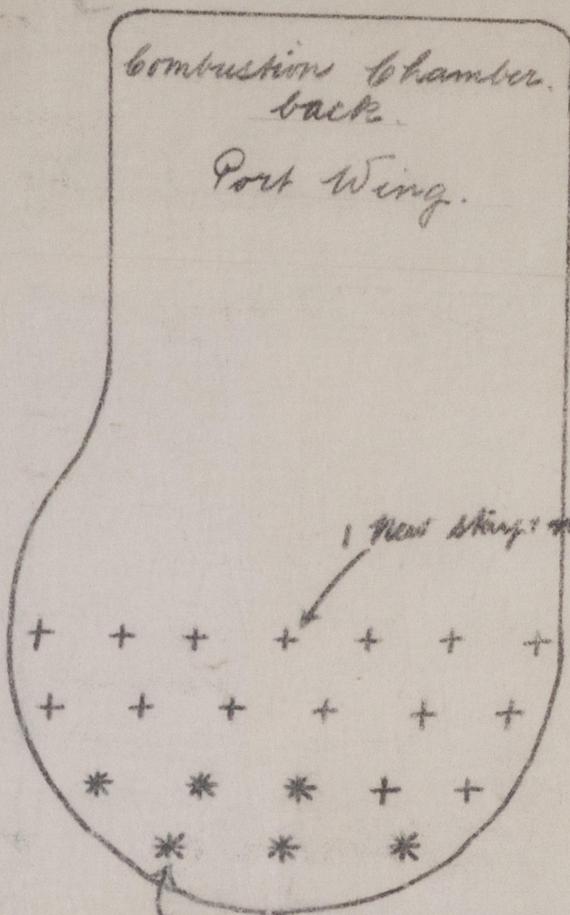


Y. Competitor


Durban 19/11/25

Starboard Boiler

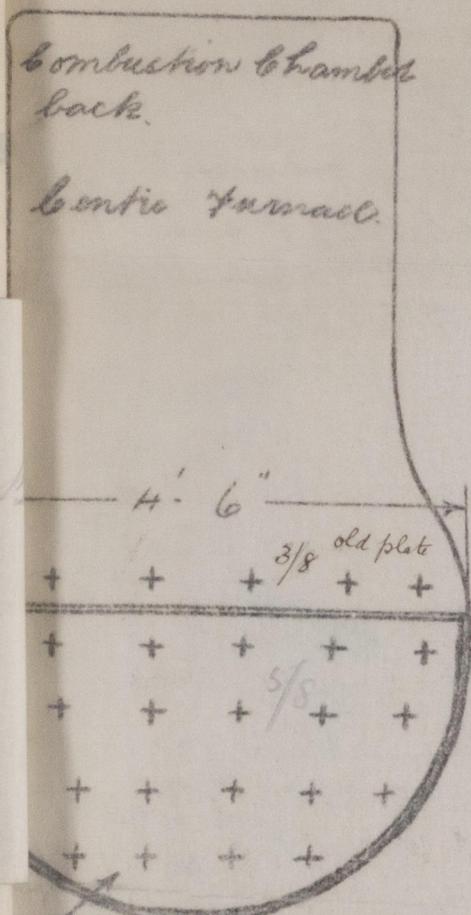

portion fit to back plate
22 stays renewed.

* New stays + new pads
+ welds on water side.

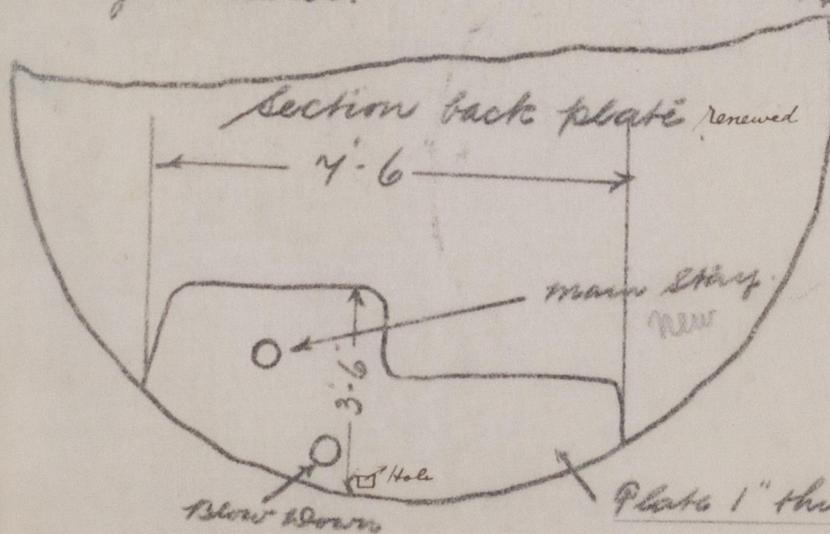

furnace. 1 crack welded.

Wing furnace. 1 crack welded.

Welding about 6 x 2"

renewed port smokebox. 24.

centric 22.

Start 9.

W575-0048



© 2020

Lloyd's Register Foundation