



1/8 Competitor

Durban 12/11/25


Port Boiler

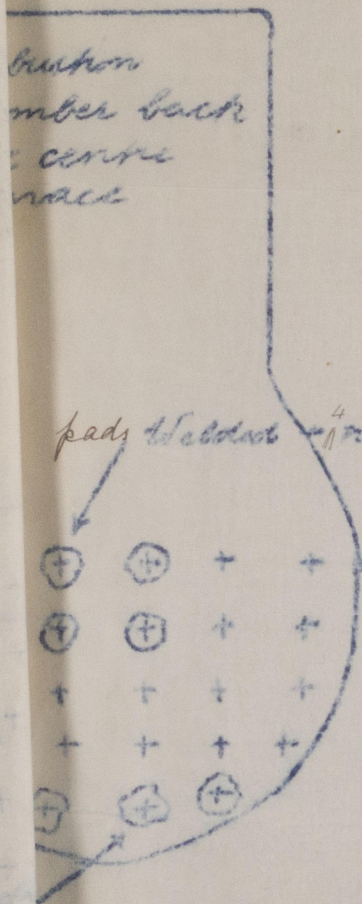

4 stays and new rivets

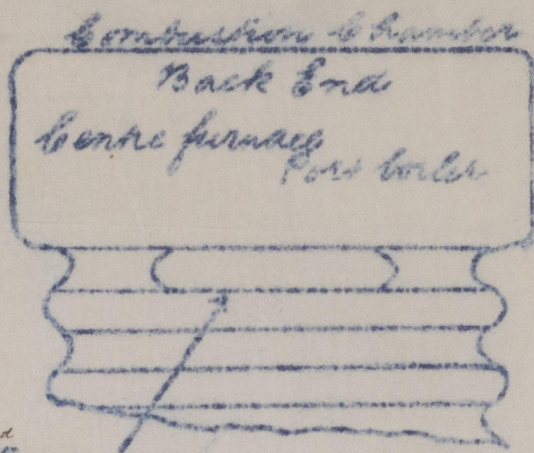

Welded + riveted patch 14" - 6" circumferentially around neck at bottom of furnace

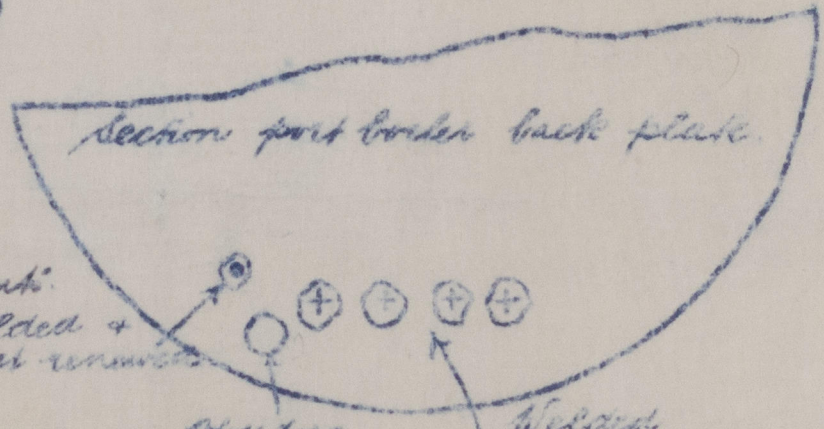

2 furnace 2 cracks welded
 furnace 6 " "
 2 furnace 2 " "

cracks
 Weldings about
 5" x 2"

welded port smoke box 20.
 " Centre " " 12.
 " Star of " " 14.

All rivets on boiler
 Salt Cook running port boiler
 New bridge



© 2020

Lloyd's Register Foundation

WS75 - 0050