


MIDSHIP SECTION as built. J. Thomson
 L.B.P. 348'-6" B. Ex. 49'-9" D.M. 25'-8"
 SCALE 1/2" = 1 FOOT.

28.12.06
 6.3.07

POOP DECK.
 BEAMS 6'-3" x 1/20 BULB ANGLES ON EVERY FRAME.
 STRINGER PLATE 3'-4" x 1/20
 STRINGER ANGLE 3'-4" x 1/20
 FROM STEEL DECK 5'-0" x 1/20
 Side Plating 5'-0" x 1/20

BRIDGE DECK
 BEAMS 7'-3" x 1/20 BULB ANGLES ON EVERY FRAME.
 HALF BEAMS IN WAY OF OPENINGS 6'-3" x 1/20 BULB ANGLES
 STRINGER PLATE 4'-0" x 1/20
 STRINGER ANGLE 4'-0" x 1/20
 FROM STEEL DECK 7'-0" x 1/20
 STRONG BEAMS IN E.B. SPACE 9'-3 1/2" x 1/20 BULB ANGLE.

FORECASTLE DECK.
 BEAMS 7'-3" x 1/20 BULB ANGLE ON EVERY FRAME
 BEAMS UNDER WINDLASS 8'-5" x 1/20 BULB TEE.
 STRINGER ANGLE 3'-4" x 1/20
 FROM STEEL DECK 5'-0" WITH WOOD SHEATHING.
 Side Plating 5'-0" x 1/20

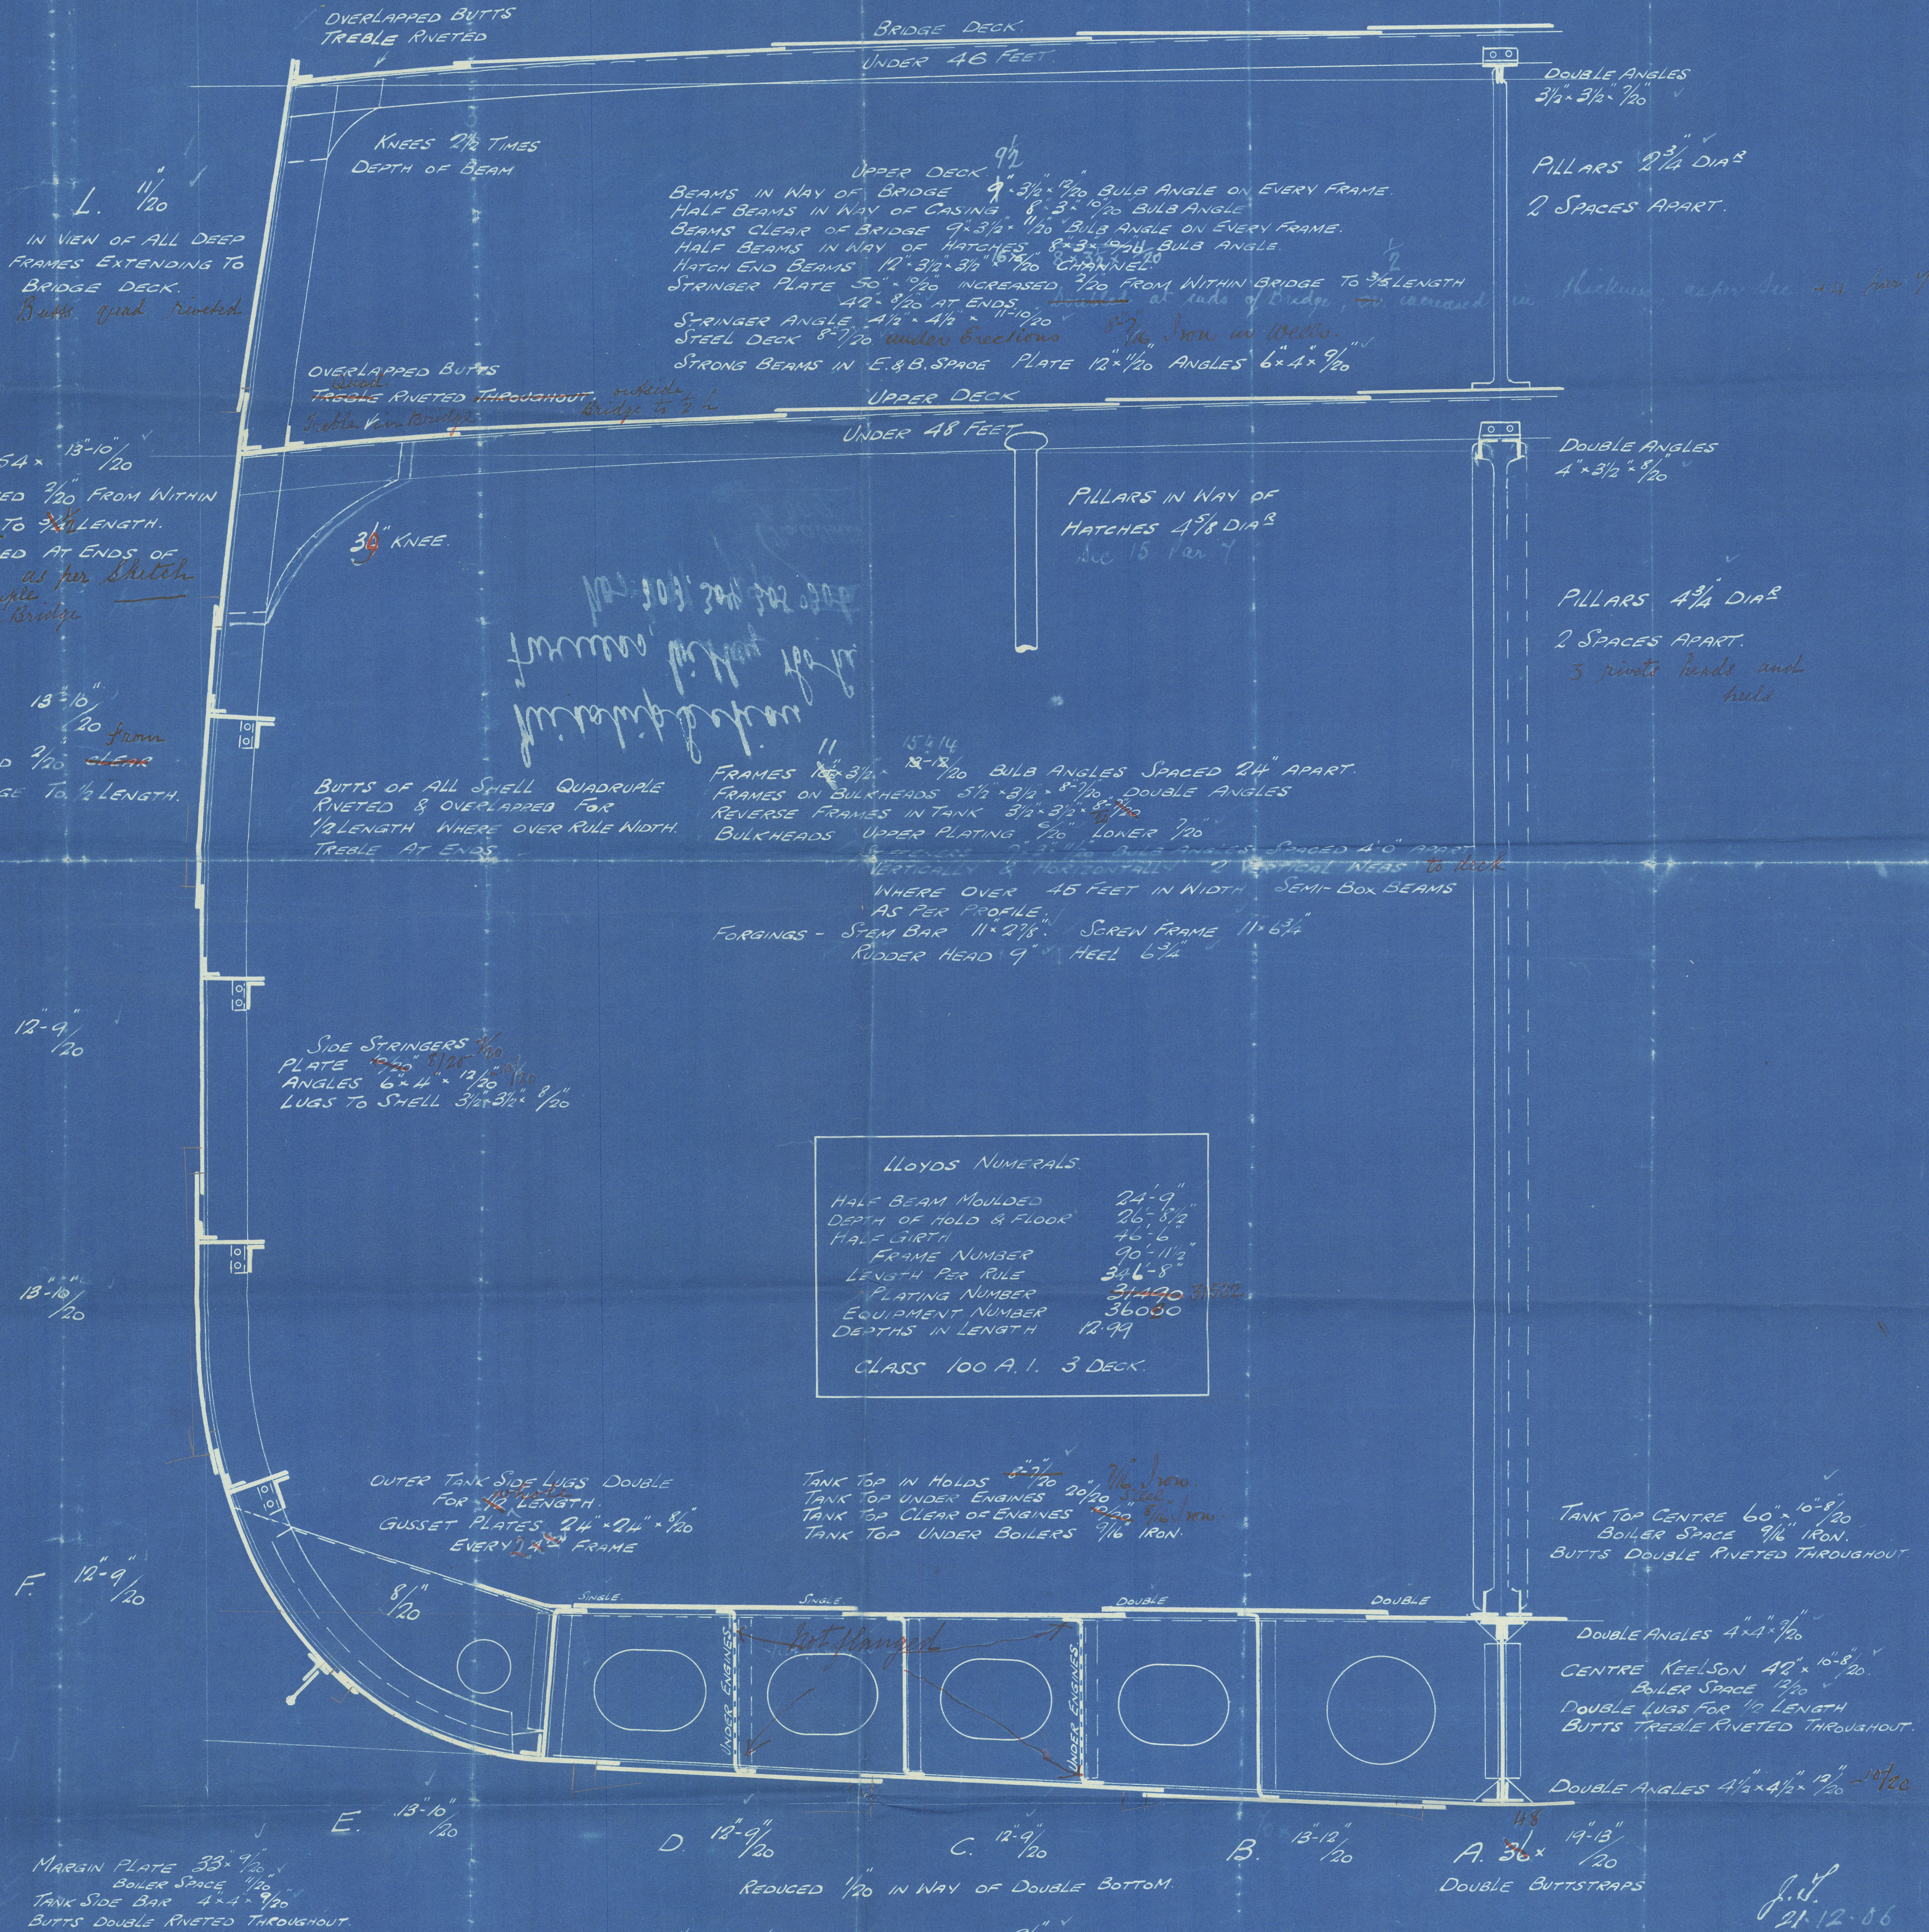

LLOYDS NUMERALS.	
HALF BEAM MOULDED	24'-9"
DEPTH OF HOLD & FLOOR	26'-5 1/2"
HALF GIRTH	45'-6"
FRAME NUMBER	90-11 1/2"
LENGTH PER RULE	346'-8"
PLATING NUMBER	34490 3532
EQUIPMENT NUMBER	36000
DEPTHS IN LENGTH	12.99
CLASS 100 A. 1. 3 DECK.	

No 303. 4. 5. & 6
 27/12/06


21.12.06

303

Midship Section
as "Bouquet" "
Hpl. Report No.



Copy
RETAIN

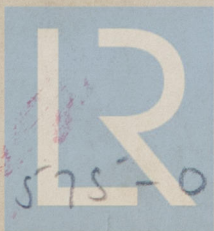

© 2020

Lloyd's Register
Foundation

W 575-0059