


28.12.06.
6.3.07.

PROFILE.

L.B.P. 348'-6" B. EX. 49'-9" D.M. 25'-8"
SCALE 1/8" = 1 FOOT

W. T. BULKHEAD OMITTED IN AFTER HOLD, TO MAKE
VESSEL SUITABLE FOR CARRYING TIMBER CARGOES

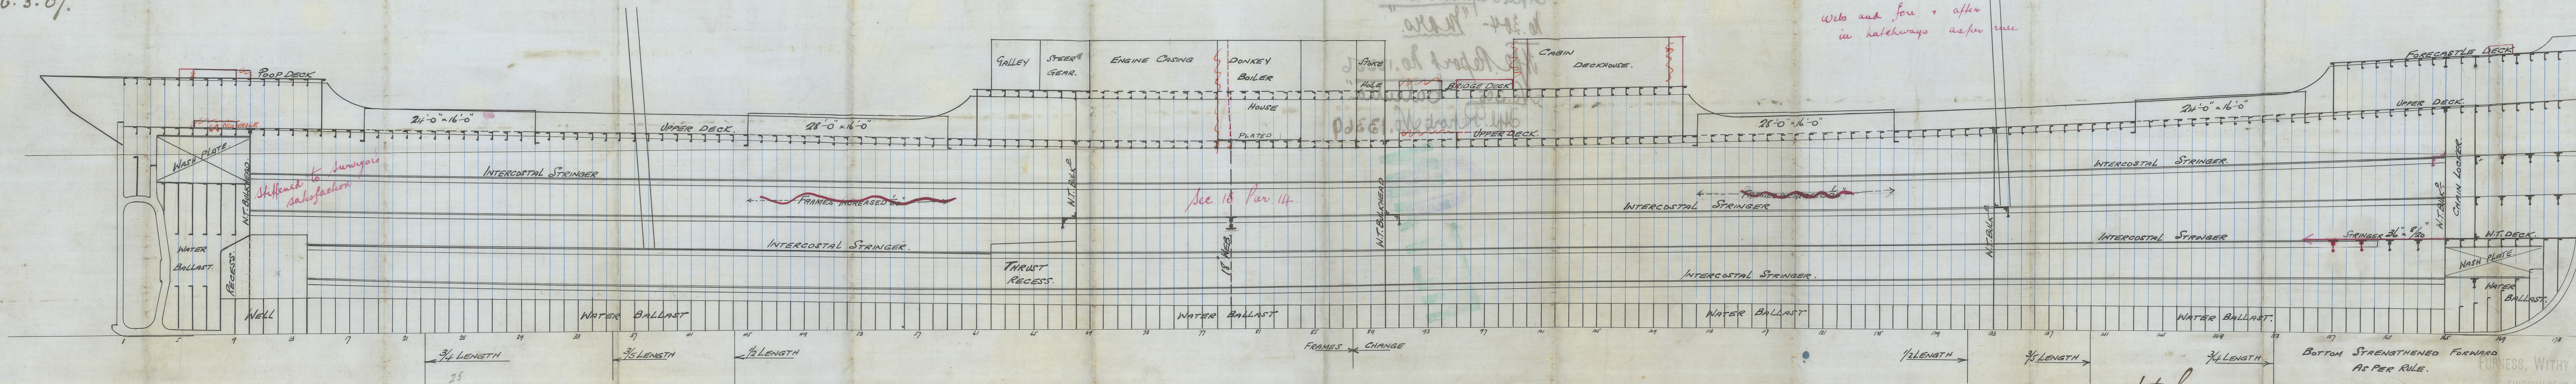

N^{os} 303, 304, 305, 306 S.S.

27/12/06

Profile
Turners, with the above

Nos. 303, 304, 305 ~~306~~

*Yard N altered to 309, but
vessel not to be built*

No. 303 *sub.* competitor *2/12/08*


Hpl. Report No. 13336.

No. 304- "Mars."

Hpl. Report No. 13356

No. 305 "Calcutta."

Hpl. Report No. 13369

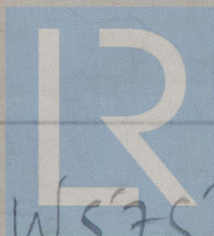

© 2020

Lloyd's Register
Foundation

WS75-0060