


# PROFILE & DECK PLAN STEEL SCREW STEAMER N° 705

DIM 180'0" B.P. x 29'0" E x 13'6" MLD

*Being modified arrangements  
(as filed)*

PLAN No. 6297  
FOR ENCLOSURE TO  
Messrs Lloyd's Surveyors.  
SHELL FROM  
COCHRANE & SONS, LTD.  
SHIPBUILDERS SELBY.  
DATE 28/11/22

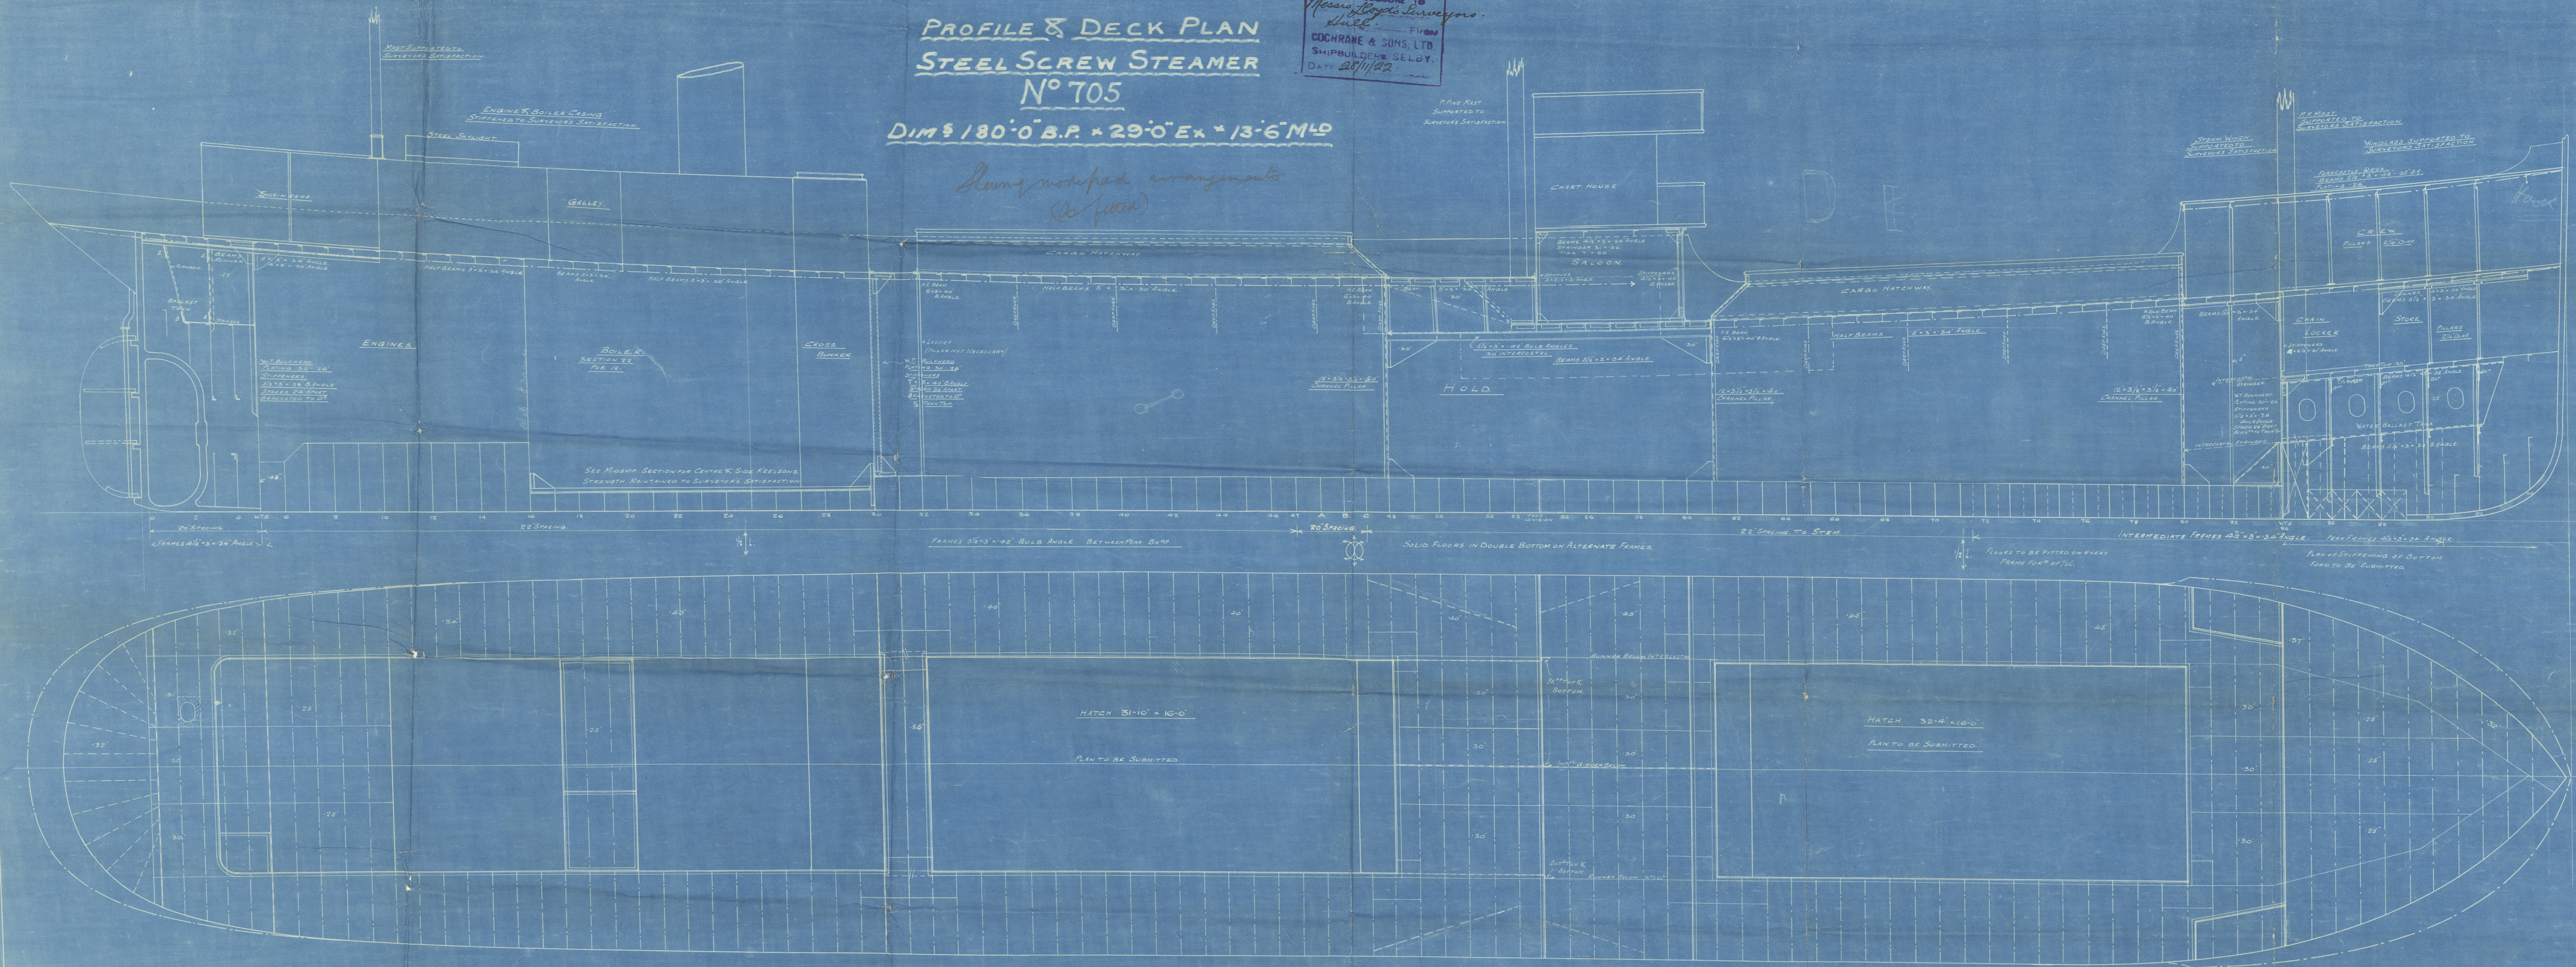

PROFILE & DECK  
102




s/s Gallion

Hull Rpt. 34044  
Cochrane's

705 1794

s/s Gallion

Hull Rpt 33880

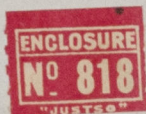


Profile of Deck  
(as fitted)

s/s Blue Gallion

Hull Rpt No. 35272

REMAINS

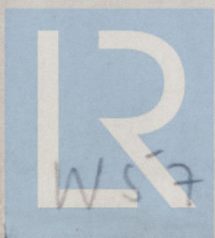

© 2020

Lloyd's Register  
Foundation