


15/6/20
11.4.23 (A.P. 194)

PLAN No. 4549
FOR ENCLOSURE TO
Messrs Lloyd's Surveyors
Hull FROM
COCHRANE & SONS, LTD.
SHIPBUILDERS, SELBY
DATE 3/6/20

PROFILE & DECK PLAN
STEEL SCREW STEAMER
N° 705

DIM 180'0" B.P. x 29'0" E x 13'6" MLD

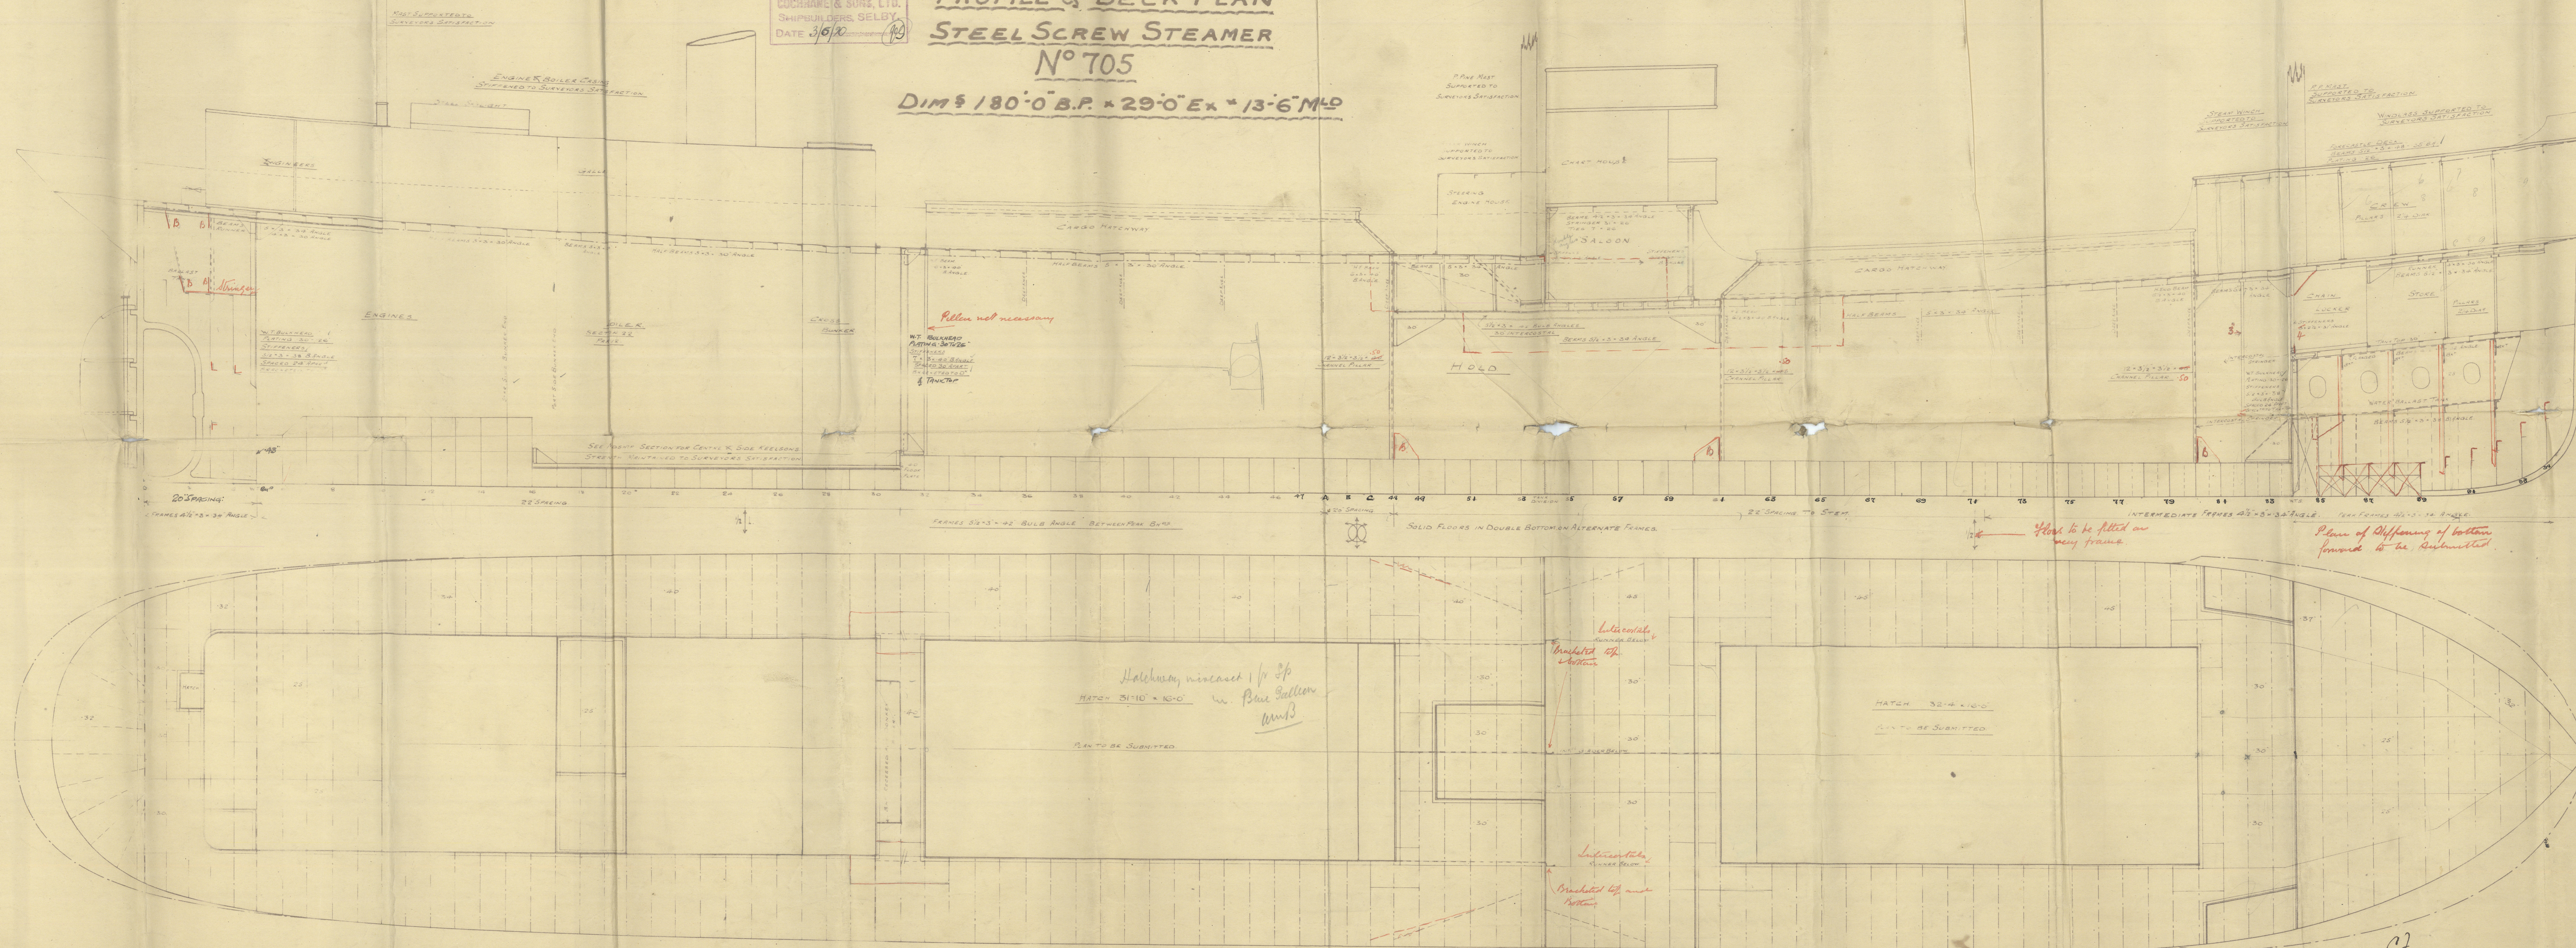

C.T.
15.6.20

PROFILE & DECKS

COCHRANE & SONS LTD

Nº 7051794.

5/5 Gallion Hull Hed Rpt No 33880

Steel 1st Entry Lpt. No. 34047.

Blue Gallion Hed - - 35194

" do Hull Rpt No 35272

REMAIN



© 2020

Lloyd's Register

W575-0076 Foundation

5/5 Galleon. Hull Rpt. No. 34048

W575-0076



© 2020

Lloyd's Register
Foundation