

MIDSHIP SECTION

S.S. NO 789

SCALE $\frac{1}{2}$ " = ONE FOOT

BUILDERS DIMENSIONS 423'-0" x 53'-0" x 32'-0"

LOYDS 423'-0" x 52'-7 1/2" x 33'-1"

CLASS 100 A1 LOYDS. THREE DECK

EQUIPMENT

2 BOWER ANCHORS STOCKLESS	68	CWTS
1 " "	58 1/2	"
1 STREAMER STOCK	19	"
1 KEDGE	8	"
270 FMS STUD CHAIN CABLE	2 1/2	"
90 " STREAM WIRE	5	"
120 " STEEL WIRE	5 1/2	"
2 or 90 HAWKERS	8	"
2 or 90 WARPS	7	"

31. 12. 06

7. 1. 07.

19. 2. 07.

5. 6. 07.

22. 9. 08.

115. 11

108. 11

423

45730

EQUIPMENT N°

115. 11

45691

52255 EQUIPMENT N°

115. 11

45691

115. 11

45691

See later plan
to suit new rules

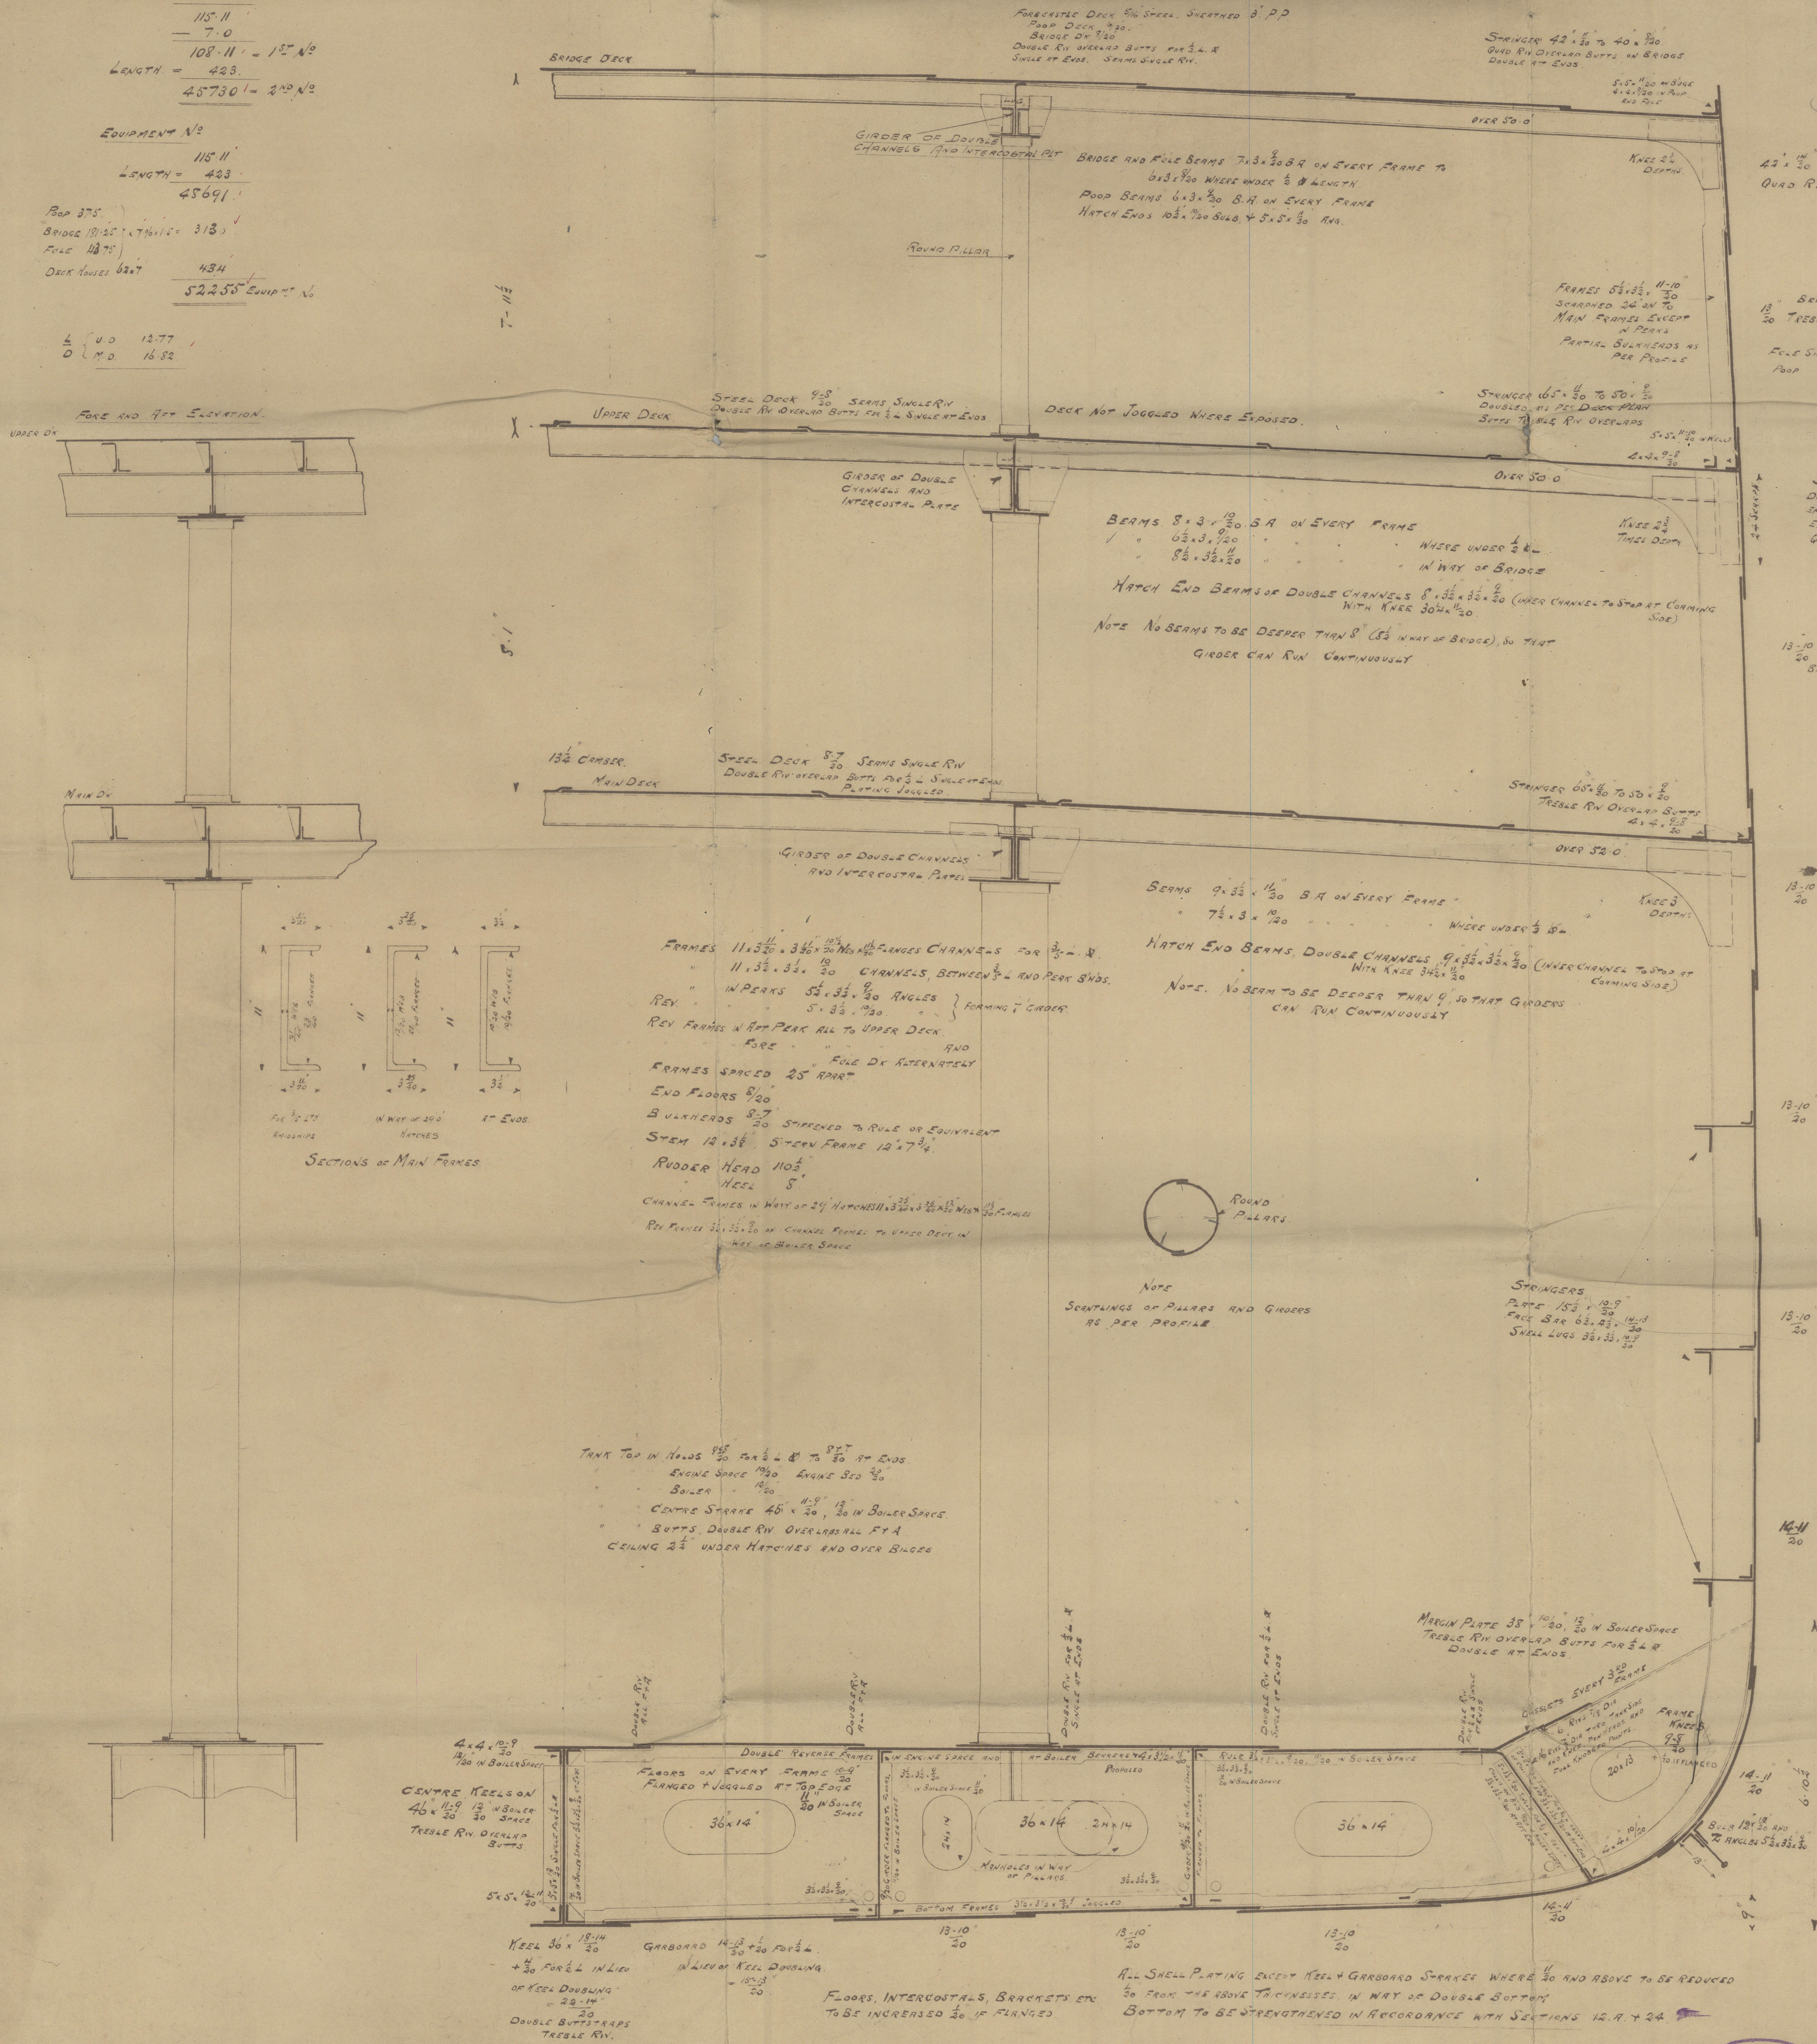

SECTIONS OF MAIN FRAMES


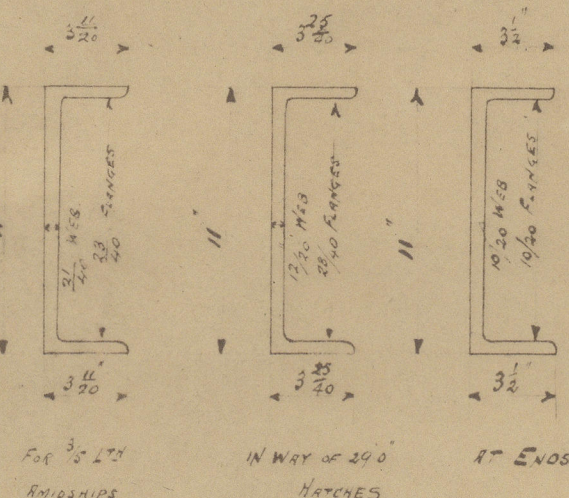


TANK TOP IN HOLD 1/2" PLATE & 8" TO 10" AT ENDS
ENGINE SPACE 1/2" PLATE 1/2" ENGINE 3/4" PLATE
BOILER 1/2" PLATE
CENTRE SPACE 4 1/2" x 1/2" IN BOILER SPACE
BUTTS DOUBLE RIV OVERLAP ALL FTA
CEILING 1/2" UNDER HATCHES AND OVER BILGES

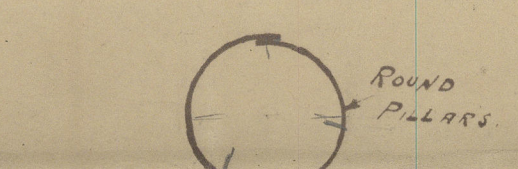

NOTE
SCANTLING OF PILLARS AND GIRDERS
AS PER PROFILE

BUTTS OF SHELL PLATING OVERLAPPED AND DUAL RIV FOR 1/2"
TREBLE AT ENDS EXCEPT WHERE OTHERWISE MARKED, ON
ACCOUNT OF STRESS BEING OVER RULE BREADTHS
SEAMS DOUBLE RIV ALL FORE-AND-AFT

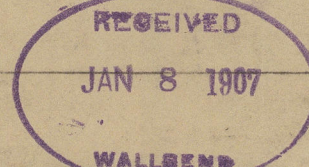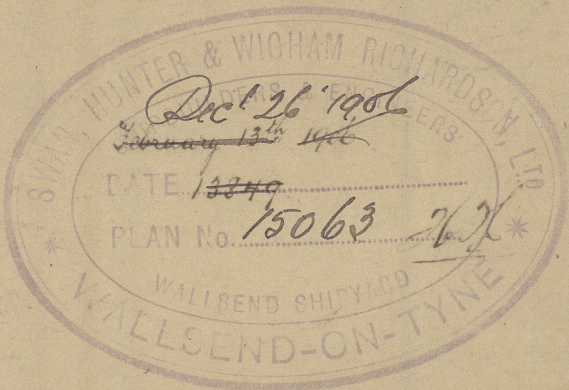

Middleup Section





789

Messrs. Swan Hunter & Wigham Richardson Ltd


original section
see later one

S.S. "BENGOELA"
NEWCASTLE-ON-TYNE.

REPORT No 60884

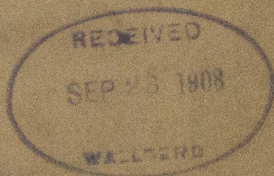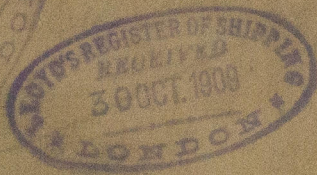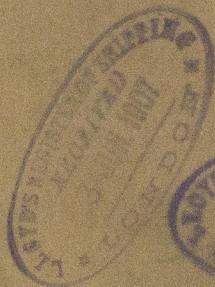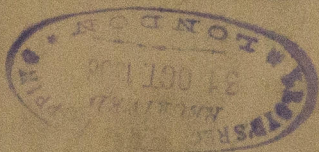


RETAIN

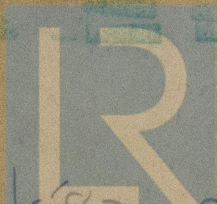

© 2020

Lloyd's Register

W580-0180 foundation

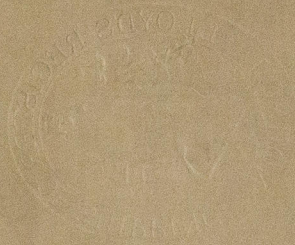

Lloyd's Register
Foundation