

18.4.13
18.5.13
10.6.13
12.7.13

Dis of Pillar
not exceeding 1 1/4"
above 1 1/4" + 1/4"
6" & above


No of rivets
Head & heel
4
6
8

PLAN VIEW AT
HATCH CORNERS
SHELTER DK.


SS N° 214. PROFILE & DECK PLANS

DIMENSIONS 40'0" BP x 51'8" ML x 31'0" ML
SCALE 1/8" = 1 FOOT


DETAIL OF HATCH CORNER
AT UPPER MAIN DECK

 


SHELTER DECK

 

UPPER DECK

 


DECK

 

18.4.13
18.5.13
10.6.13
12.7.13

RETAIN

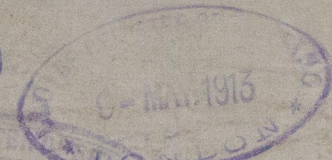

No 214



Profile & Deck Plans.

Northumbrian S.B. Co Ltd

S.S. FRISIA

NEWCASTLE-ON-TYNE

Report No 86011



MAY 17 1913

ANDROMEDA

W.69.B

W 582-0311



© 2021

Lloyd's Register Foundation