


21.2.03  
26.5.03

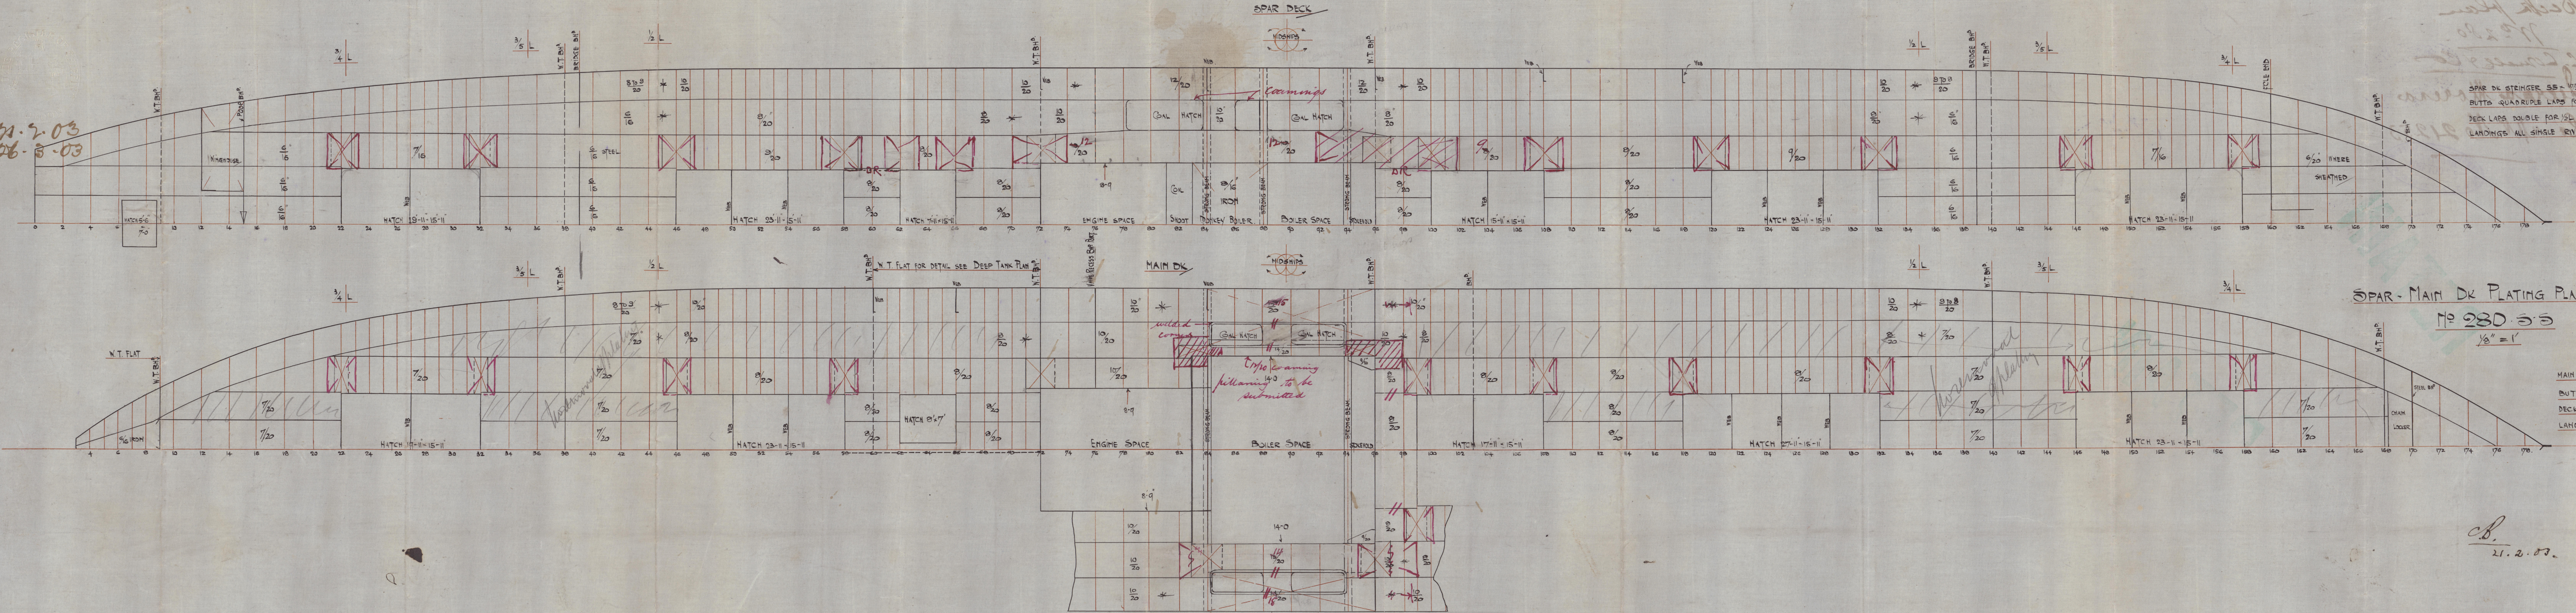

21.2.03



Beck plan  
No 280

C. Combe & Co

Sierra Morena  
Glo. apt No 21253






MAIN OF STEIN  
BUTTS TREE  
DECK LADS  
LANDINGS


W582-0371



© 2021

Lloyd's Register  
Foundation