


REGISTER OF
27-2-03

Tracing showing arrangement of Stringers in Fore Hold


— No 280.55. —

— Scale $\frac{1}{8}" = 1 \text{ foot.}$ —

27.2.03

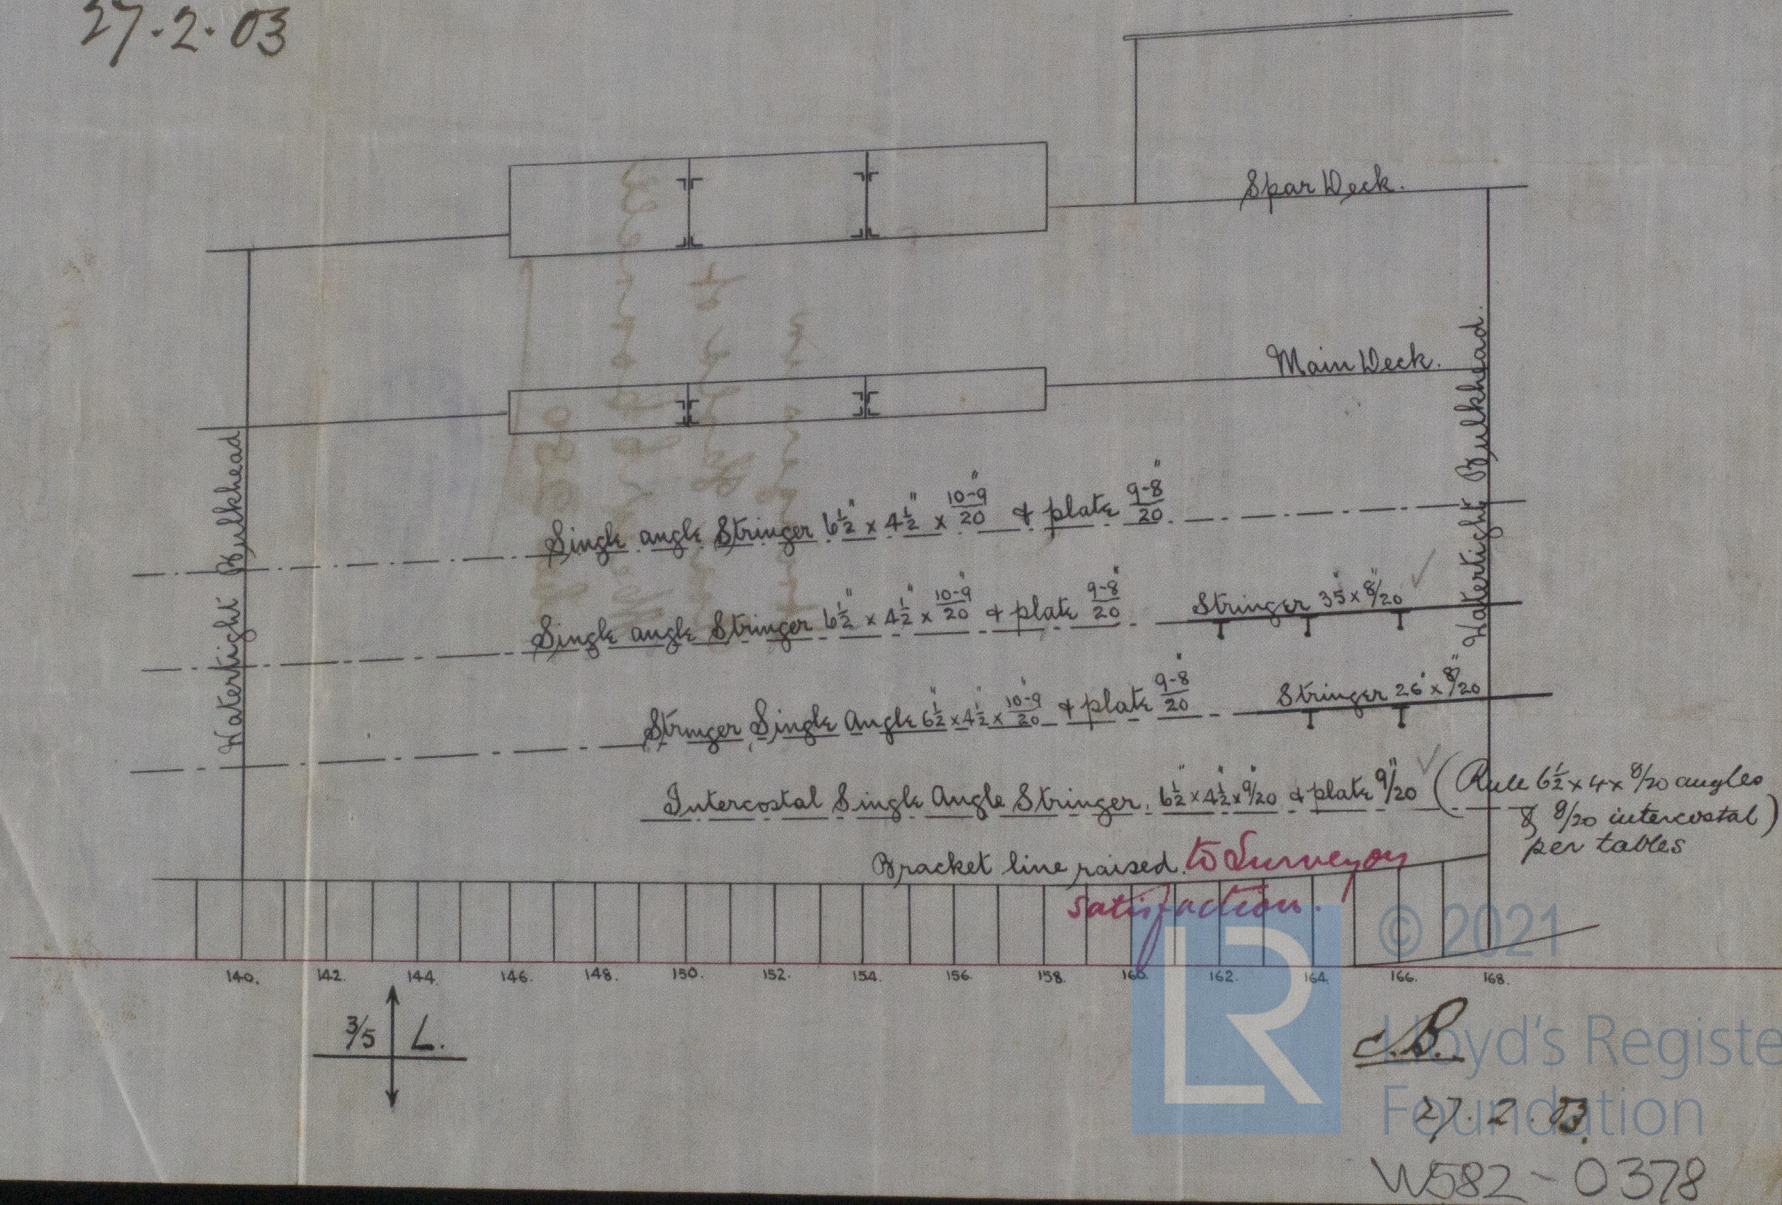

Stringers in
Boat Hold of
Hearbbonnell
Box 280

 

W582-0378



© 2021

Lloyd's Register
Foundation