


31.12.15

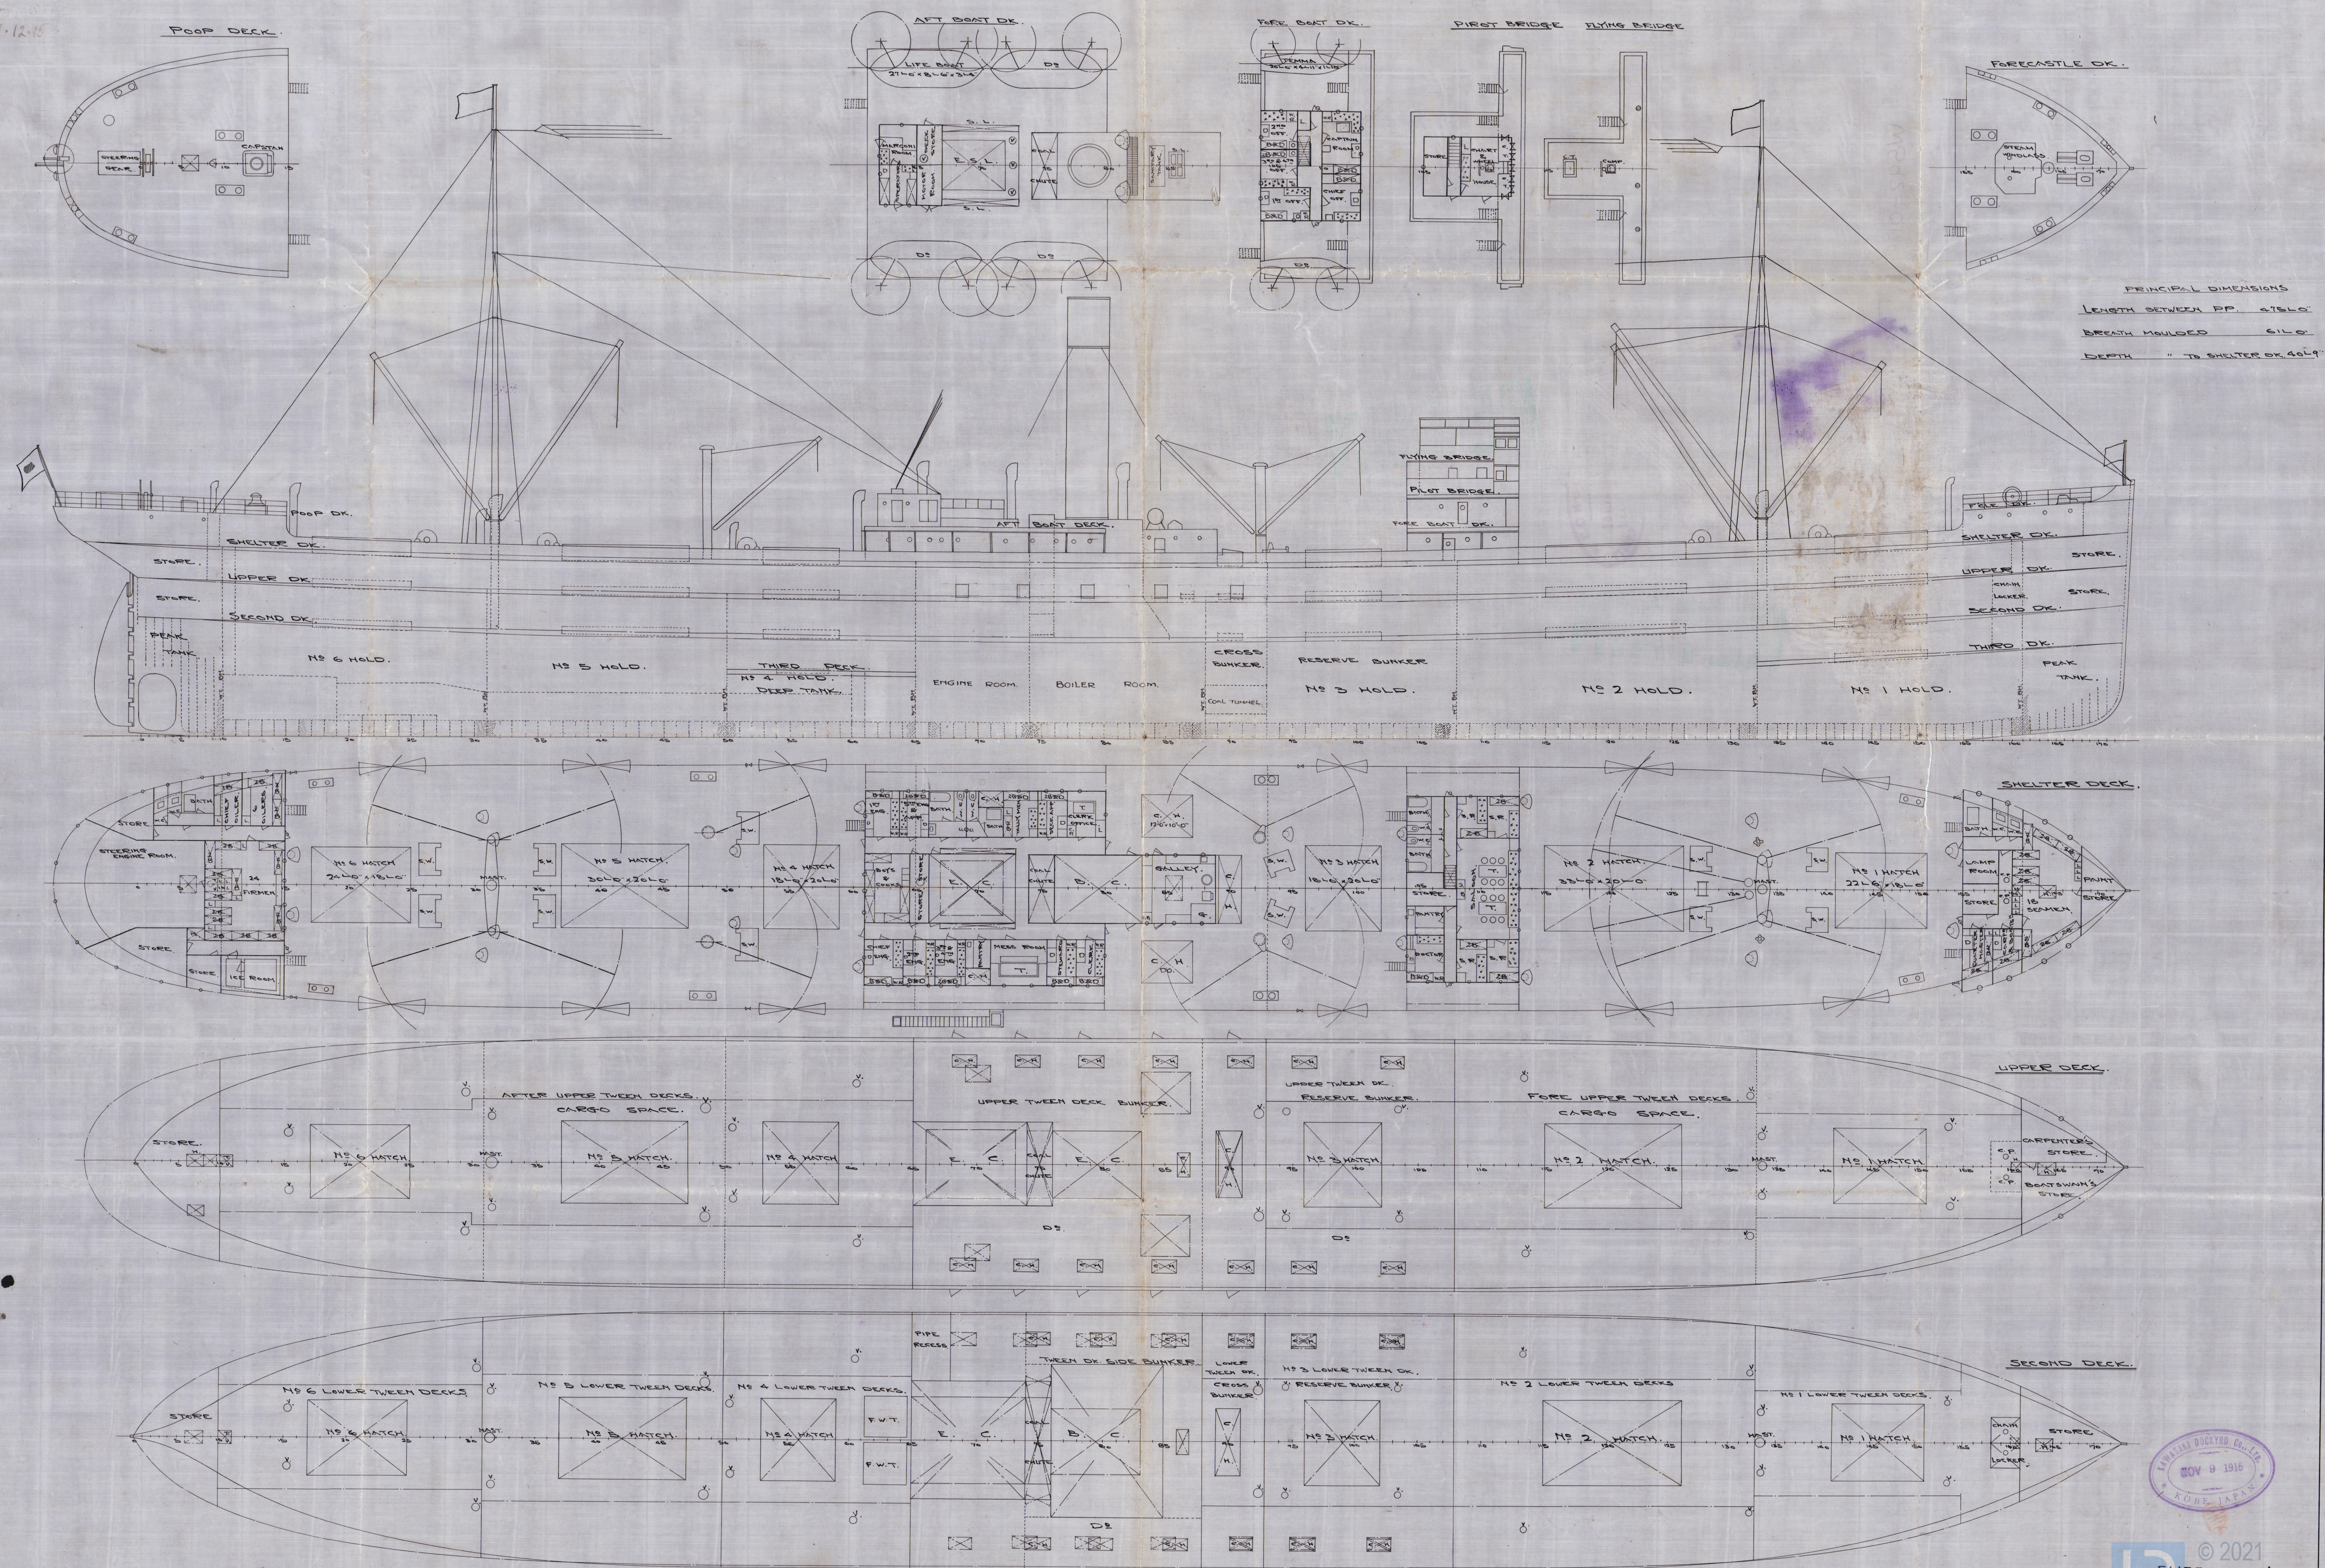

PRINCIPAL DIMENSIONS

LENGTH BETWEEN PP. 47.60"

BREATH MOULDED 61.0"

DEPTH " TO SHELTER OR 40.0"

WS92-0170

2014-10-10

22 OCT 1950

88E IN

Don

DO NOT WRITE


DO NOT WRITE

DO NOT WRITE



© 2021

Lloyd's Register
Foundation

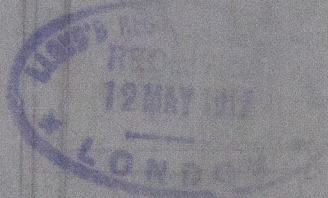

12 3 1950



