

# OIL CARRYING STEAMER


NOS 216 + 217 (0060)

17.7.12

MODIFICATION OF TRUNK OIL TIGHT BULKHEADS

(SEE MIDSHIP SECTION — N° 37128)


SCALE  $\frac{1}{25}$

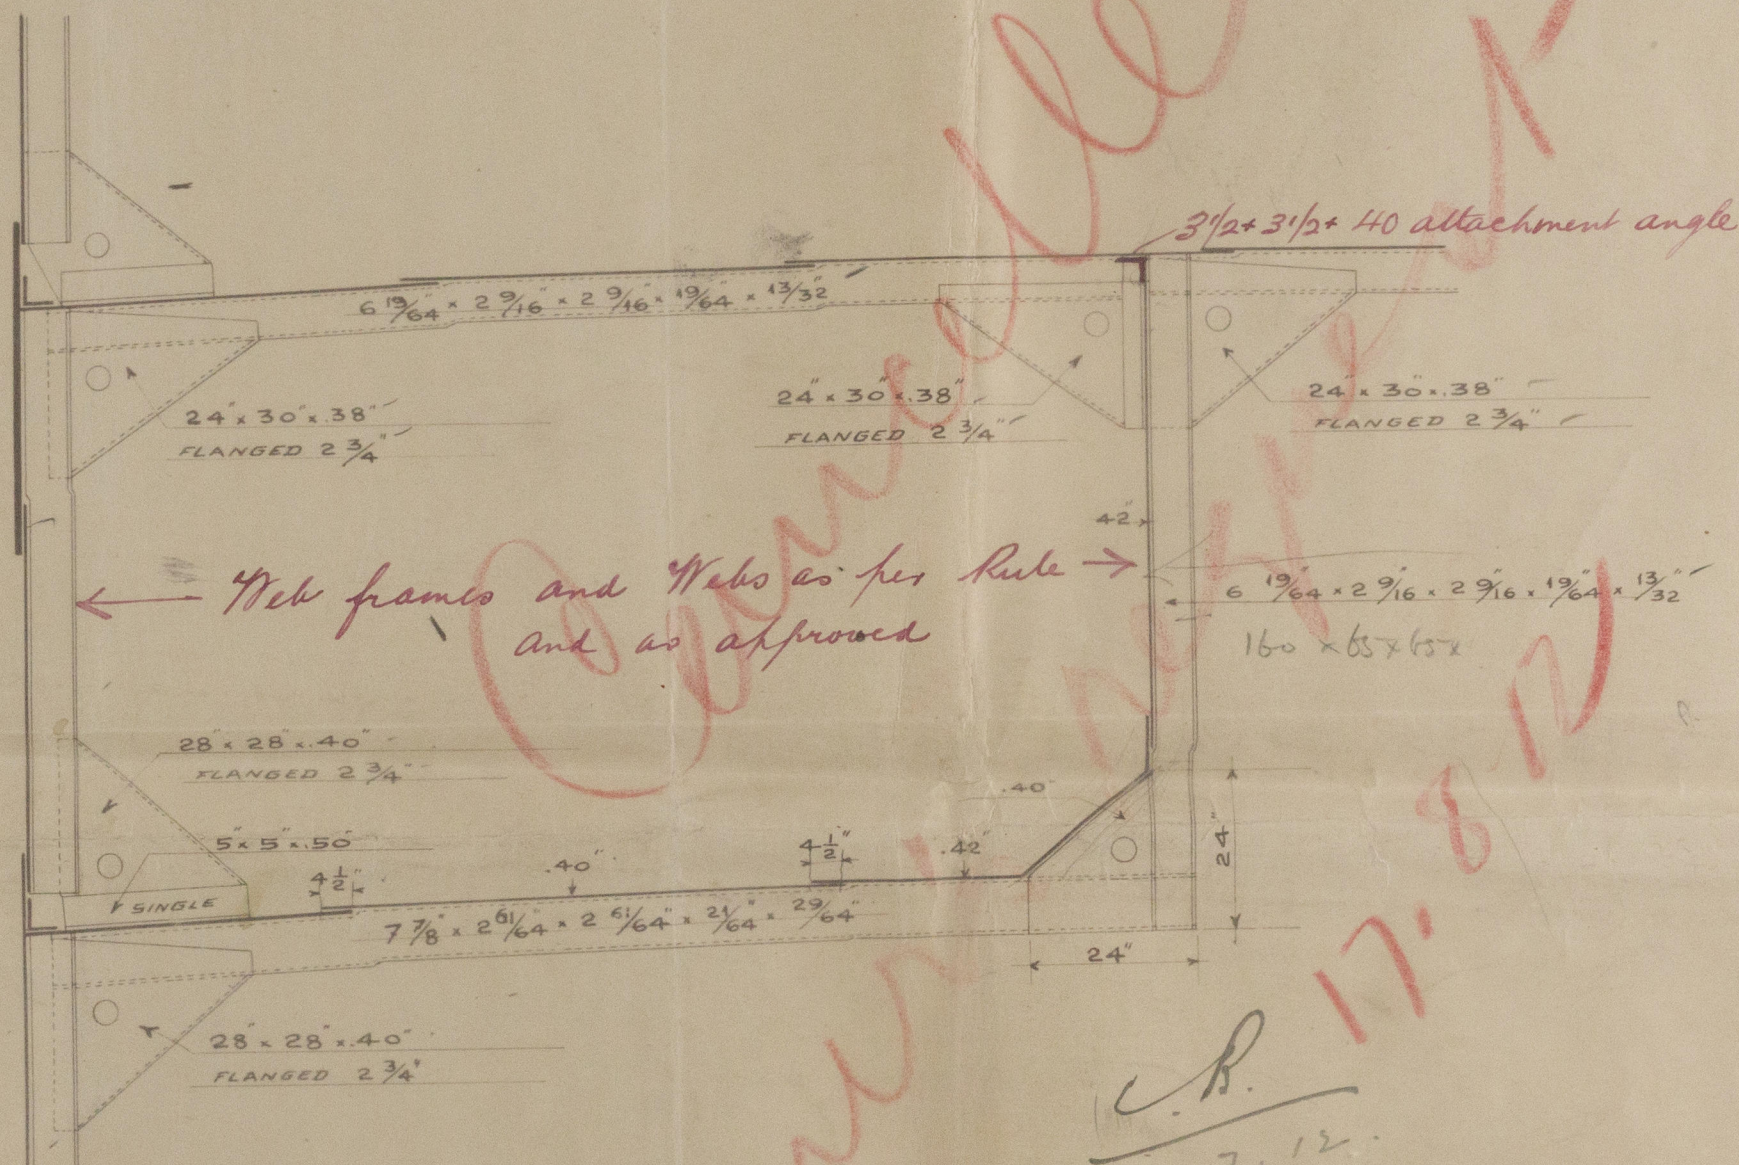

37565

10-6-1912



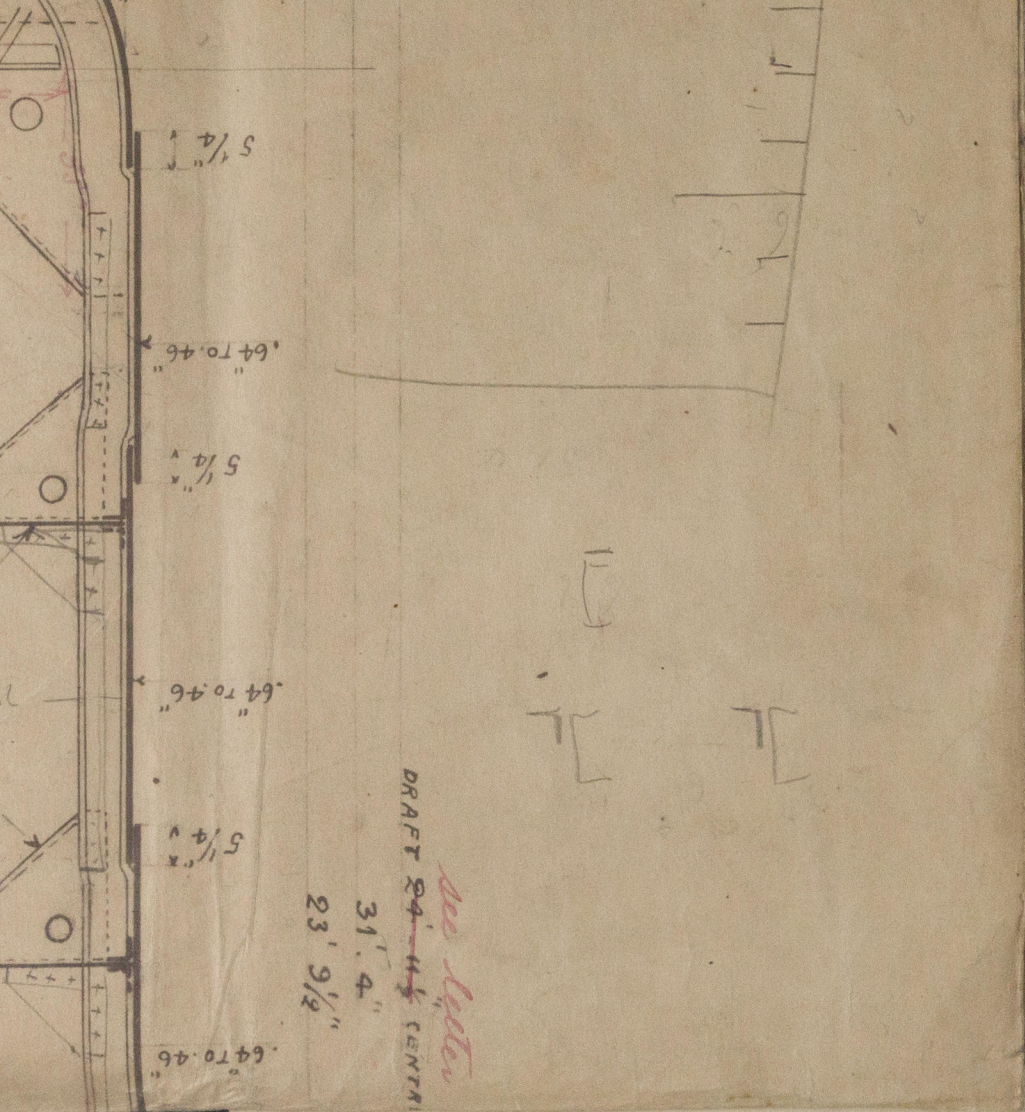

Modification of  
Expansion Tank Rules

N<sup>o</sup>. 2169 217

(ODERO. FOCE)



© 2020

Lloyd's Register  
Foundation