
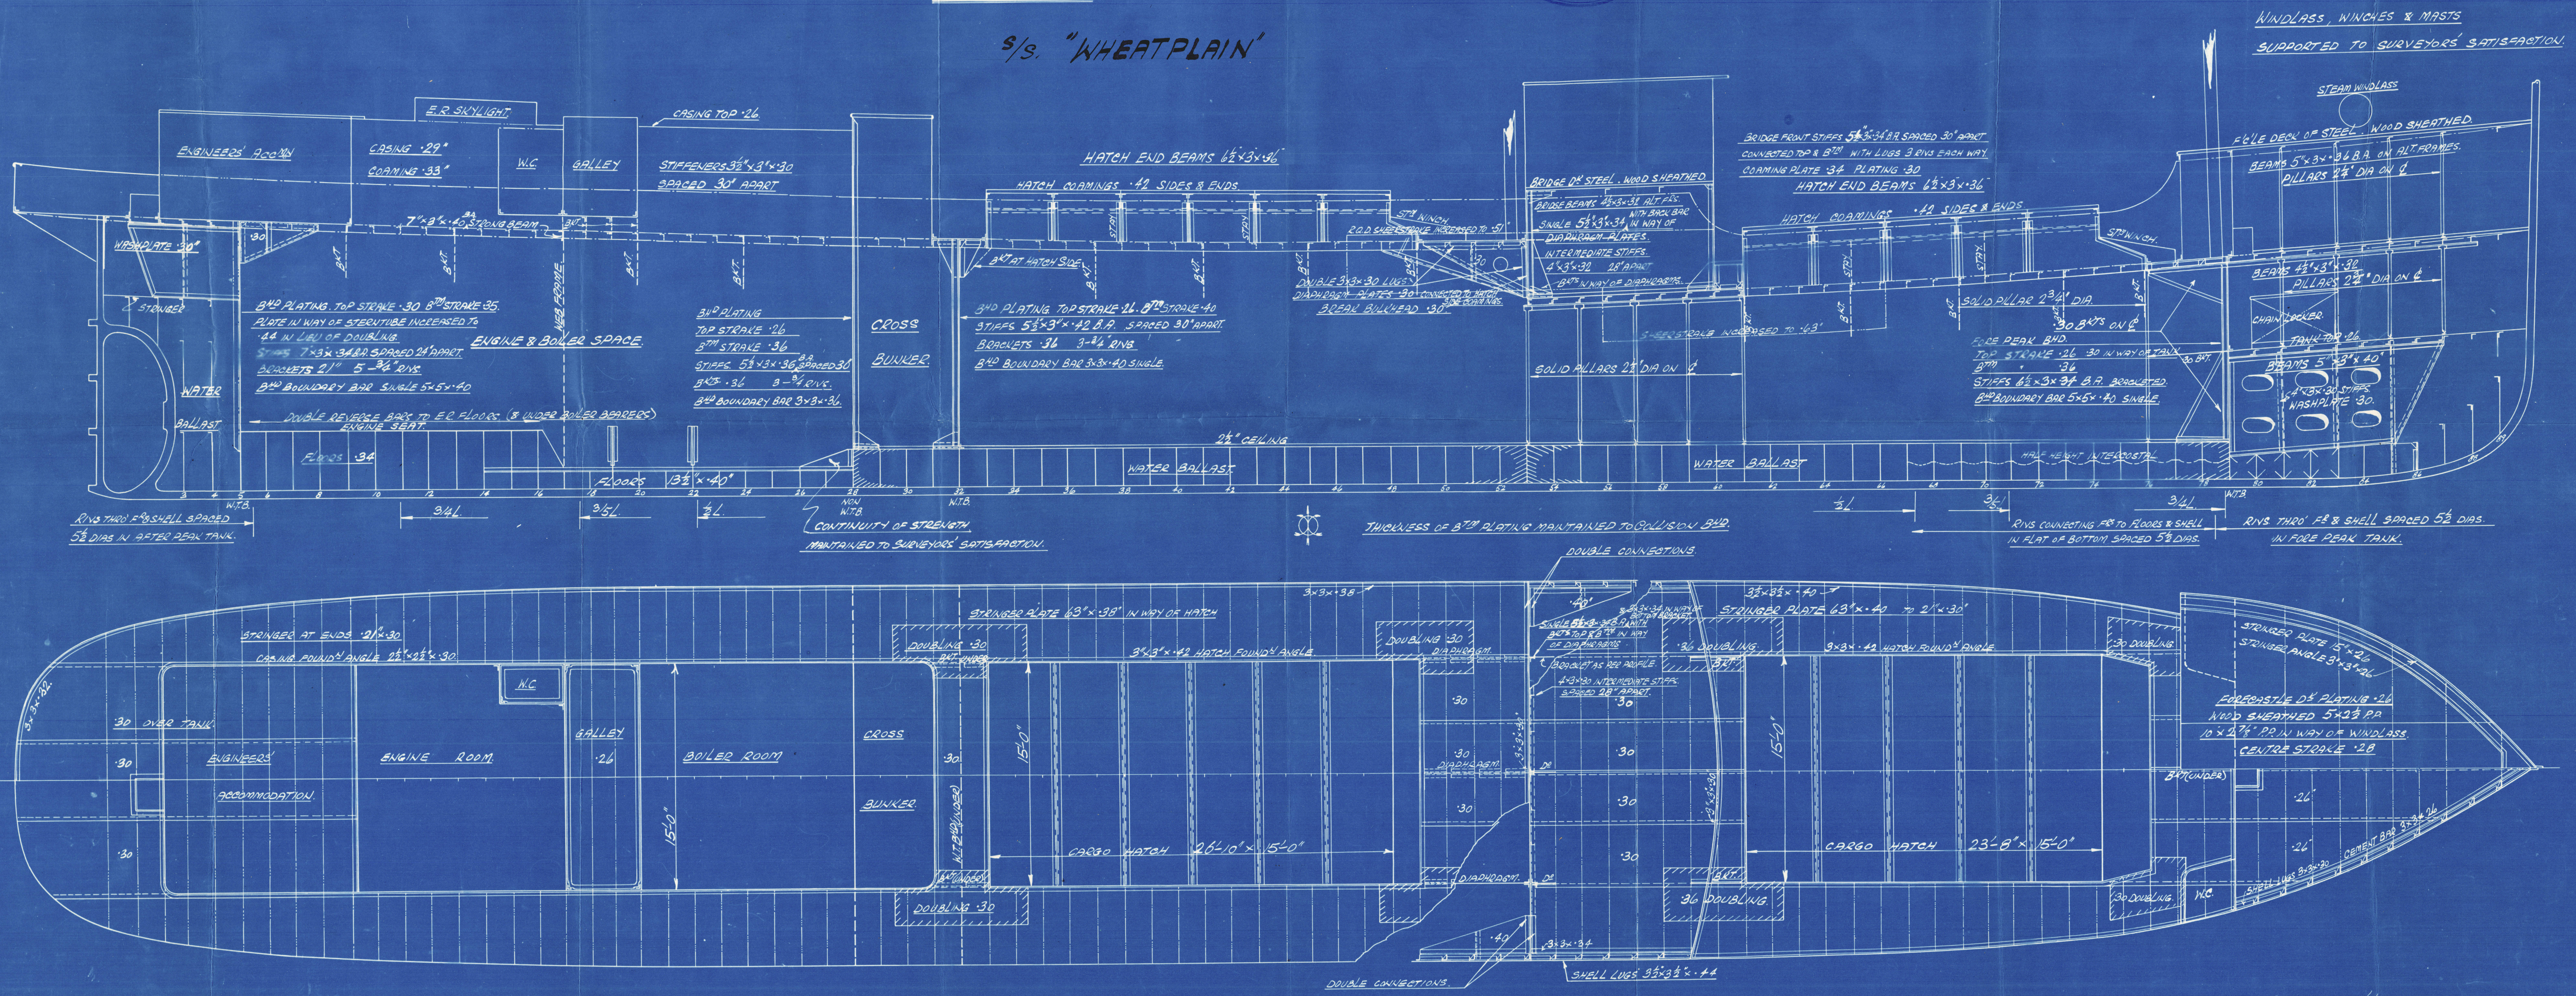


SHIP No. 8 & 10
PROFILE & DECK PLAN

DIMENSIONS:- 162'-0" B.P. x 25'-6" x 12'-0" MLD

SCALE 1/4" = 1 FOOT

S/S. "WHEATPLAIN"

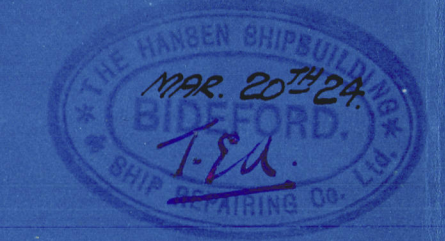

KINDLASS, WINCHES & MASTS
SUPPORTED TO SURVEYORS' SATISFACTION


APPROVED BY LLOYDS. 10.3.23

S/S Wheatplain Builders No 10

Profile & Deck.

"Wheatplain" apl. 3300.

RETAIN

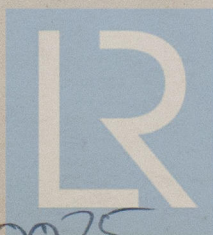

© 2020

Lloyd's Register
Foundation

W598-0075