


BREWER DRY DOCK CO.
Mariner Harbor S.I. N.Y.

DIMENSIONS

LENGTH	9 METERS, = 29.5 Ft.
BREADTH	3.5 " = 11.5 Ft.
DEPTH	1.3 " = 4.25 Ft.

Hull 71 to 74.

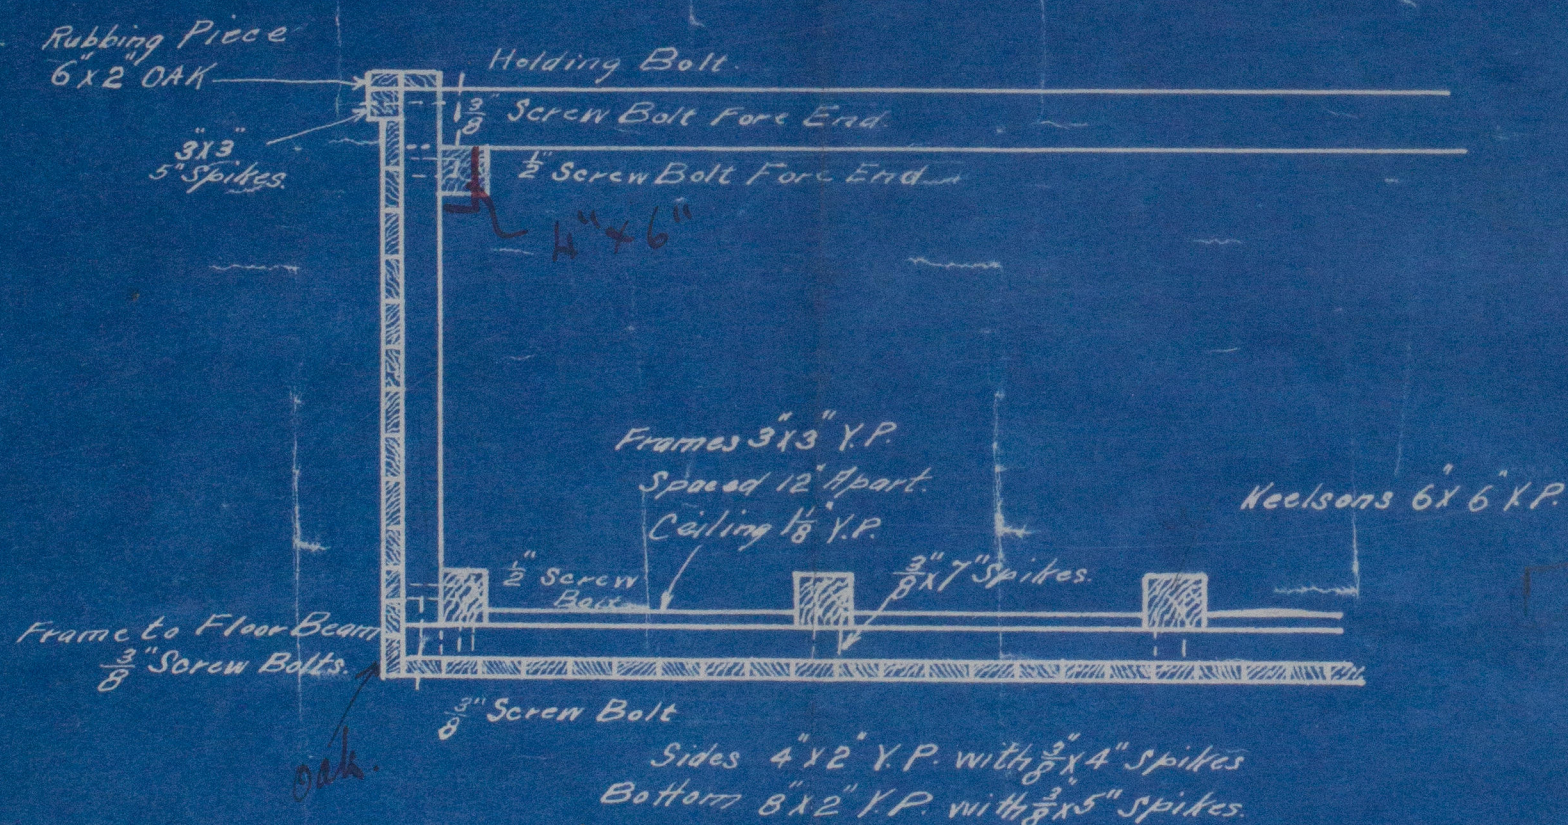

Equipment
One - 150 lb. anchor
Two ft - $\frac{3}{8}$ " slow link chain

LR

W578-0024




RETAIR

W598-0124



© 2020

Lloyd's Register
Foundation