

Reverse frames 65 x 50 x 6 m
Reverse frames to the upper turn of
bilge and every second to extend
to deck.

double reverse bars to be fitted as indicated on the profile plan:

13^m/m ends 10^m/m
or doubling plate to be fitted.

W598-0190


#

M.V.
"Cargo Shipper"

London Apr. 89173.

CARGO SHIPPER.

CARGO SHIPPER.
Midship's Section

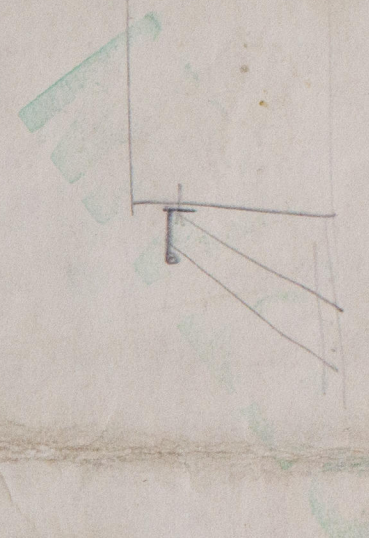

W598-0190



© 2020

Lloyd's Register
Foundation