





26.1.11
20.3.11
30.3.11
27.5.11
21.6.11
29.9.11


PROFILE & DECK PLANS
LENGTH 374' 10" BP. 51' 8" BREADTH MLD. 30' 9" DEPTH MLD.
ISHERWOOD SYSTEM (PATENT)
SCALE 1/8" = ONE FOOT.

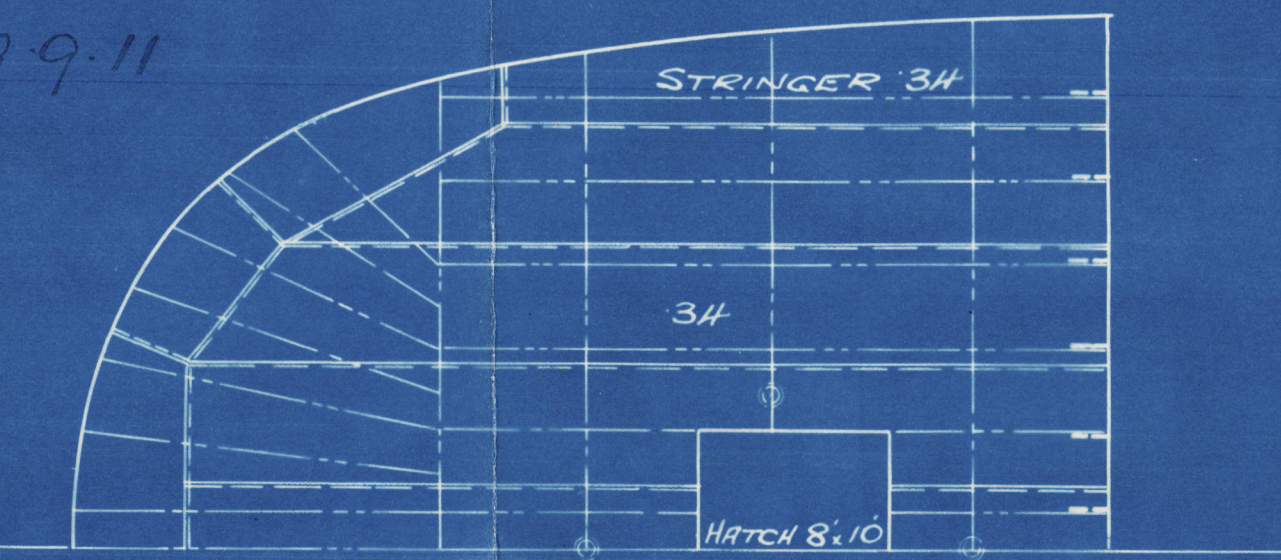


POOP DECK

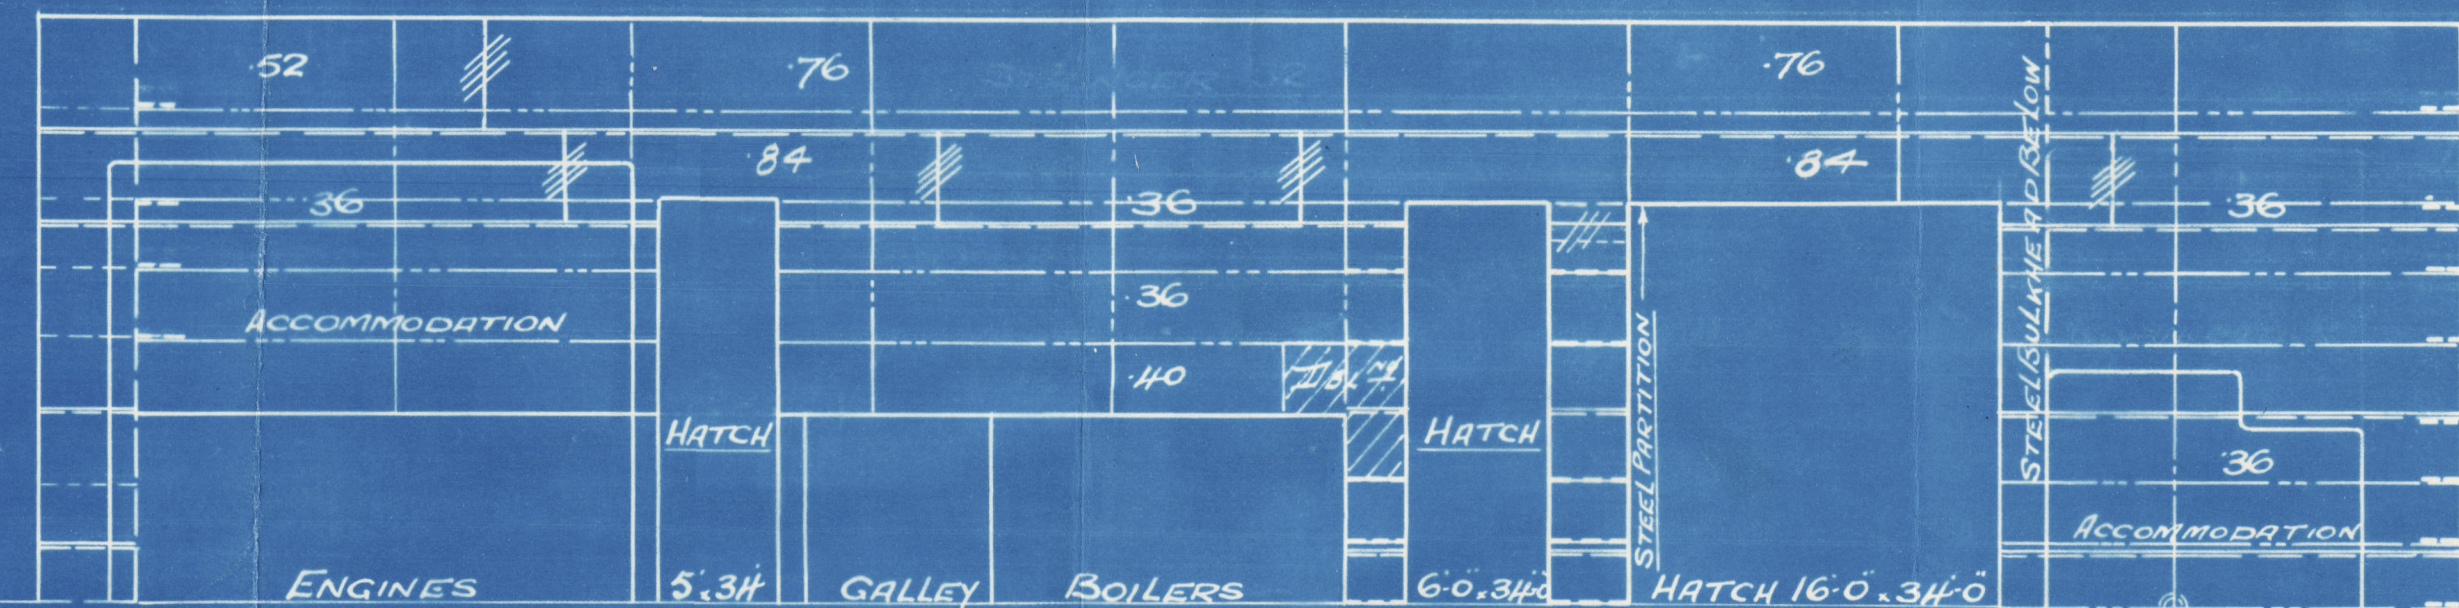

BRIDGE DECK

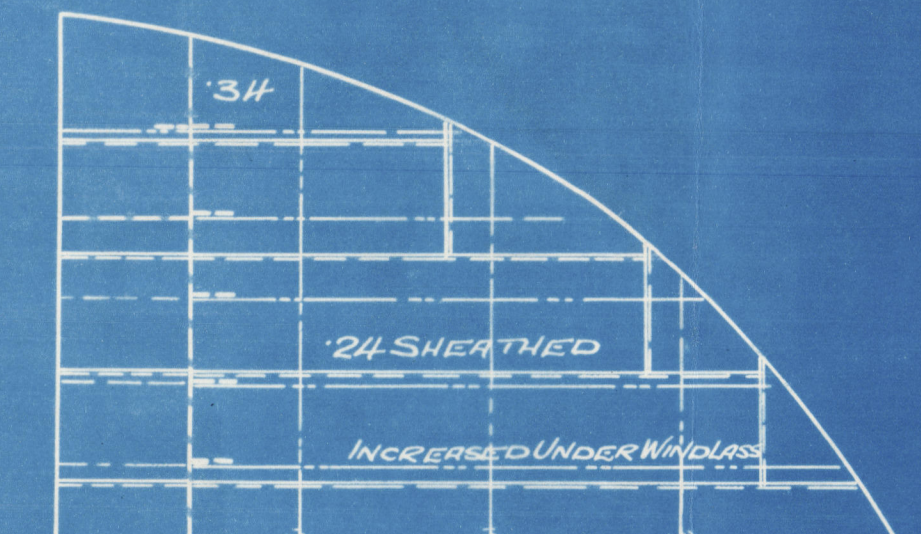

FORECASTLE DECK

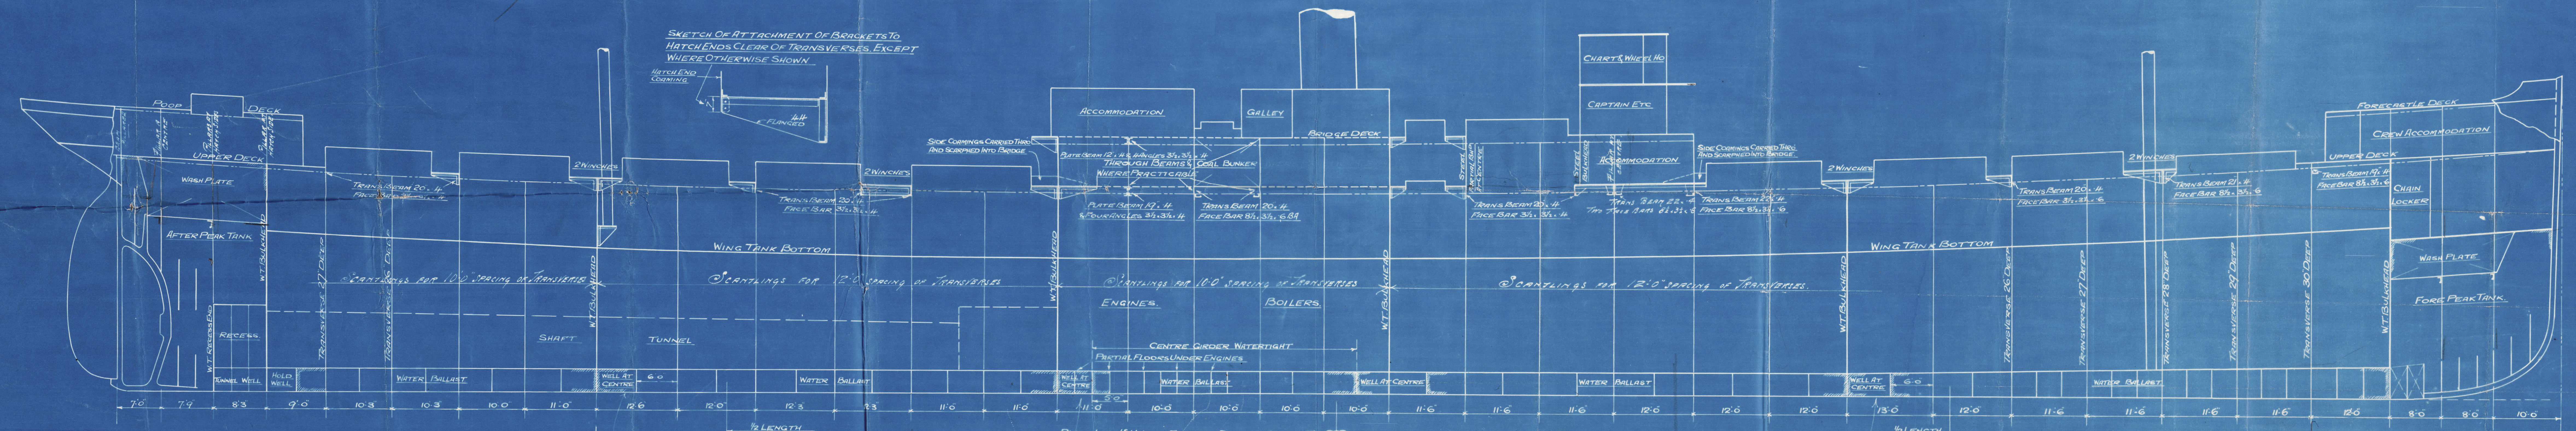

SKETCH OF ATTACHMENT OF BRACKETS TO HATCH ENDS CLEAR OF TRANSVERSES EXCEPT WHERE OTHERWISE SHOWN

SKETCH OF ATTACHMENT OF BRACKETS TO HATCH ENDS CLEAR OF TRANSVERSES EXCEPT WHERE OTHERWISE SHOWN

CHARTS WHEEL HO

CAPTAIN ETC

FORECASTLE DECK

CREW ACCOMMODATION

UPPER DECK

CHAIN LOCKER

WASH PLATE

FORE PEAK TANK


CLEAR OF TANK WELL LONGITUDINAL BRACKET PLATES ARRANGED THUS TO REDUCE SPAN

CLEAR OF TANK WELL & ENGINE SEATING GIRDERS LONGITUDINAL BRACKET PLATES THUS TO REDUCE SPAN

CLEAR OF TANK WELL LONGITUDINAL BRACKET PLATES ARRANGED THUS TO REDUCE SPAN

Messrs Short Bros Ltd.
SUNDERLAND

No 367

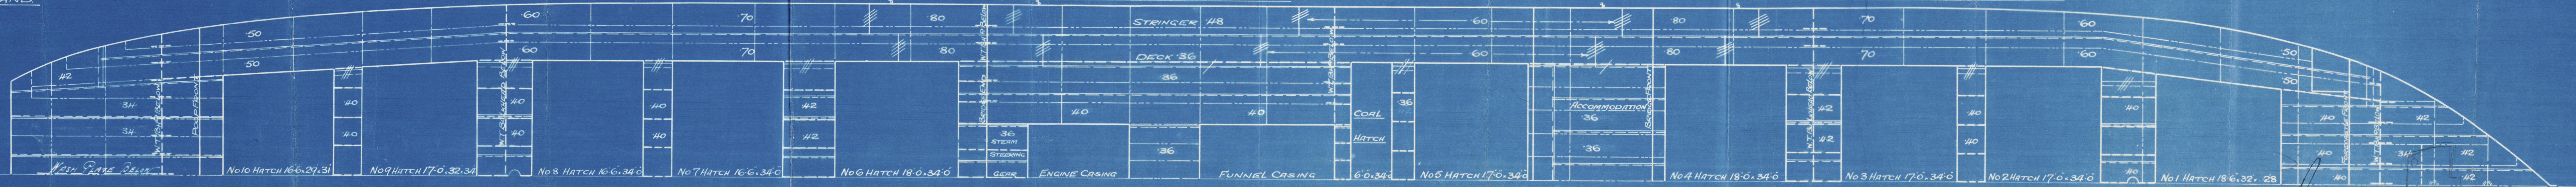

UPPER DECK

25.1.11

Amended Profiles & Deck Plan


Mass^{es} Short Bros.

No^s. 367 & 365

L.T. "WABANA"







Ld. Report No 25098.

25121
Ld. Vrb. 40099

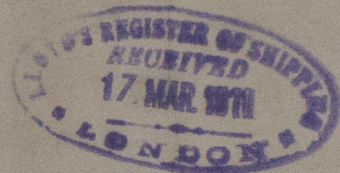

365 "MASKINONGE"

Ld. Report No. 25183.

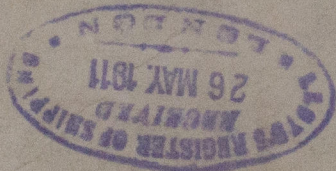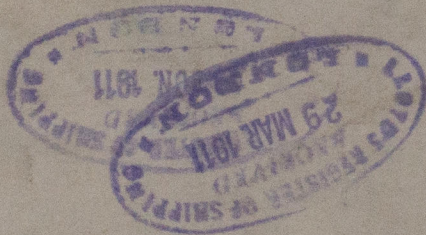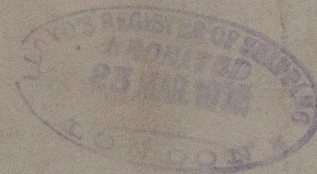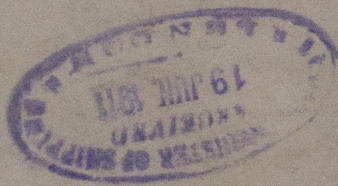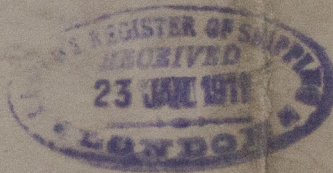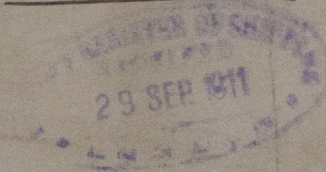

RETAIR



© 2021

Lloyd's Register
Foundation
W549-0186