

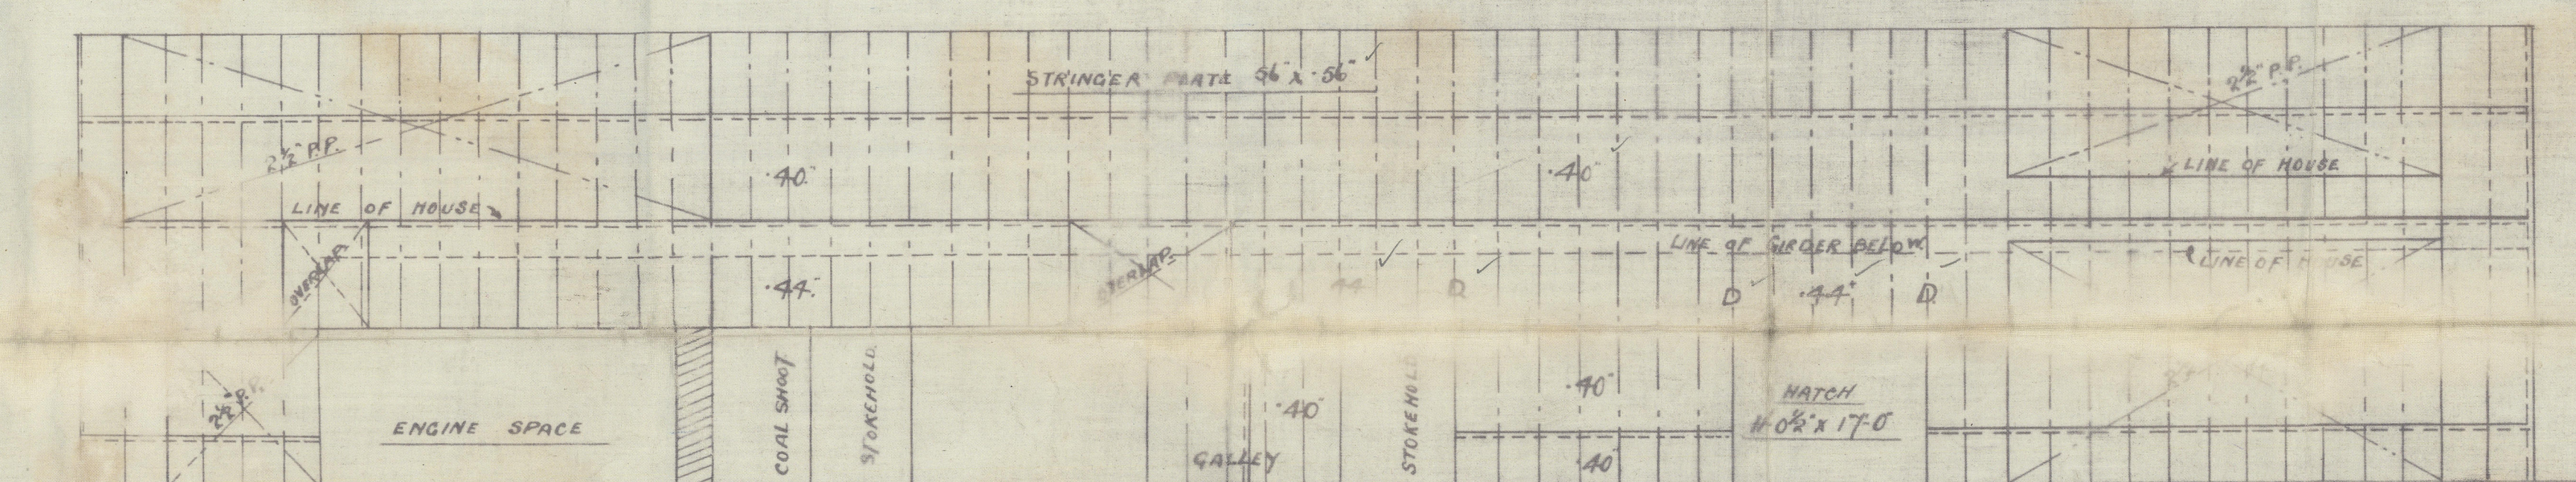
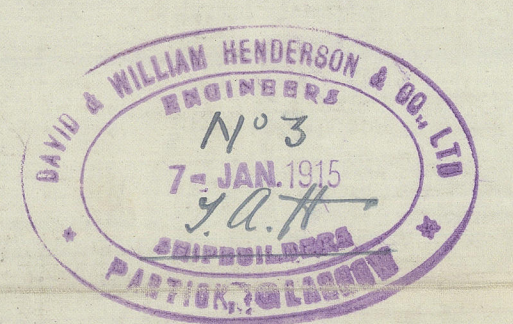
 
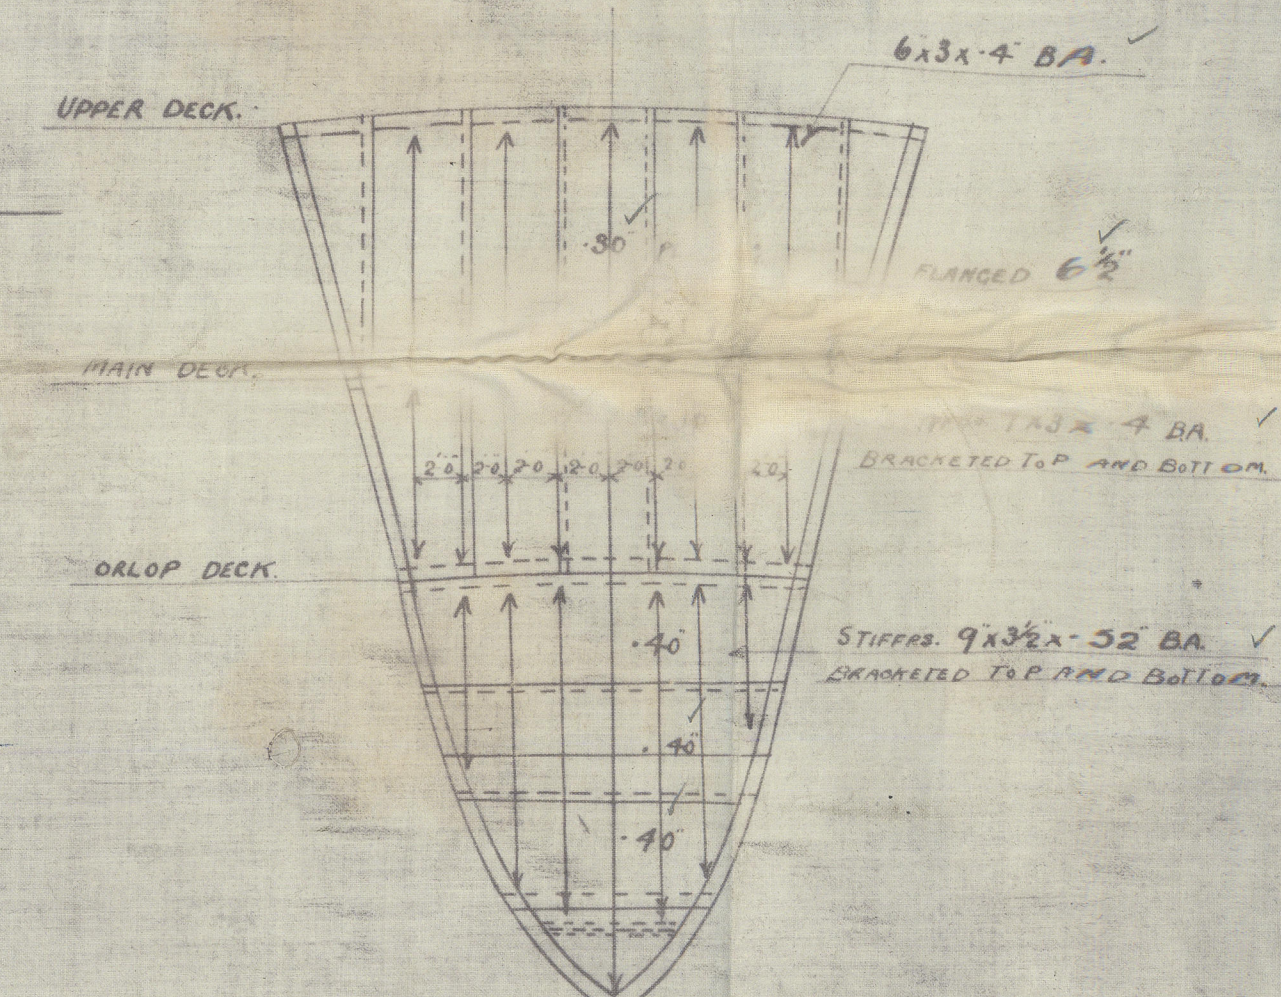


PROFILE & DECK PLANS

S.S. No 495
SCALE 1/8" = 1 FOOT.
DIMENSIONS 410 x 52 M² x 32' 7" M²

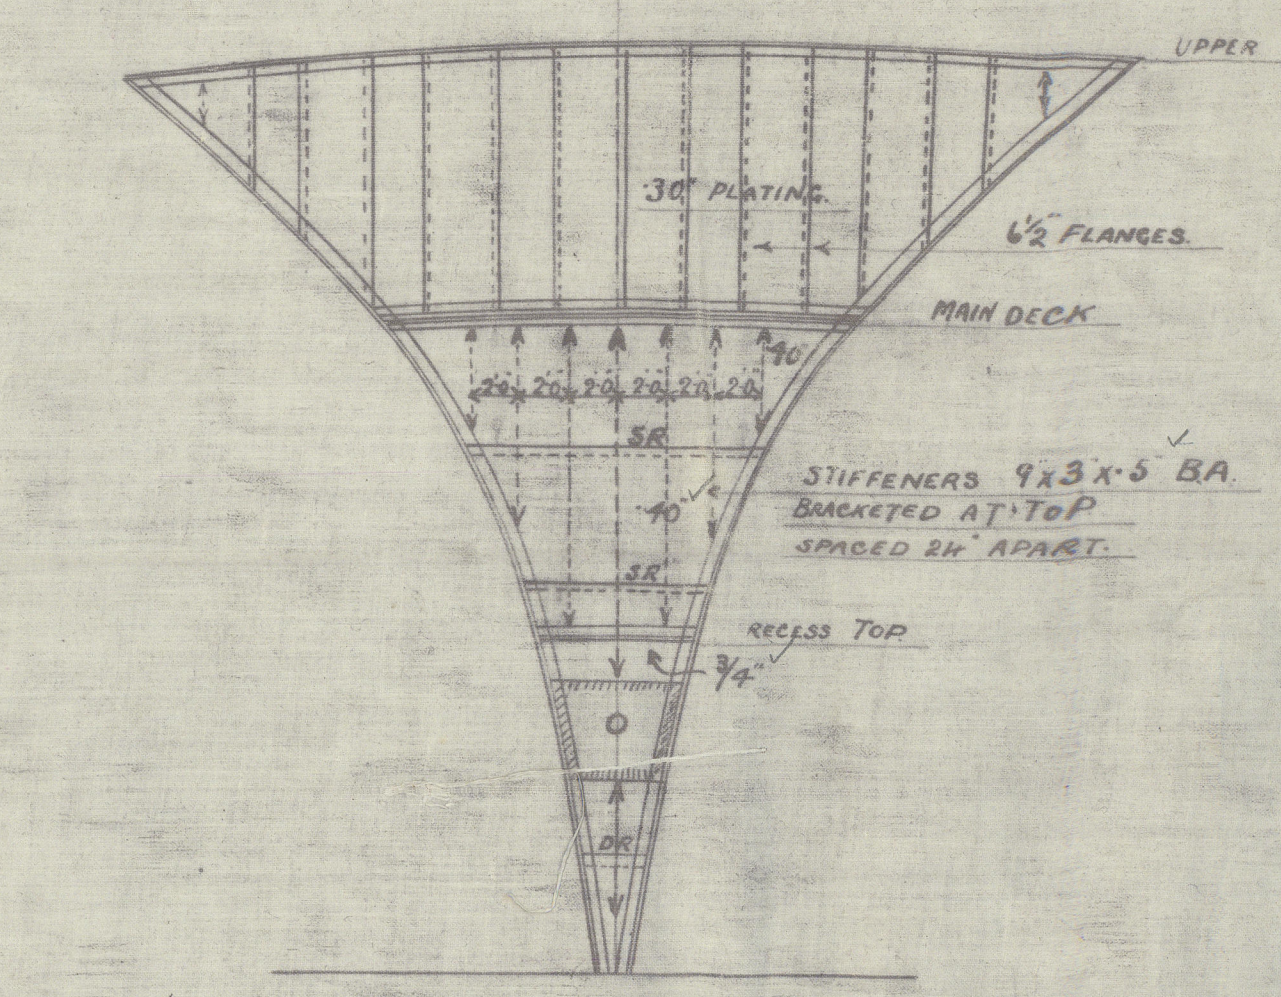




Sketch along additional strengthening in way of rekeying half for 11.1.16

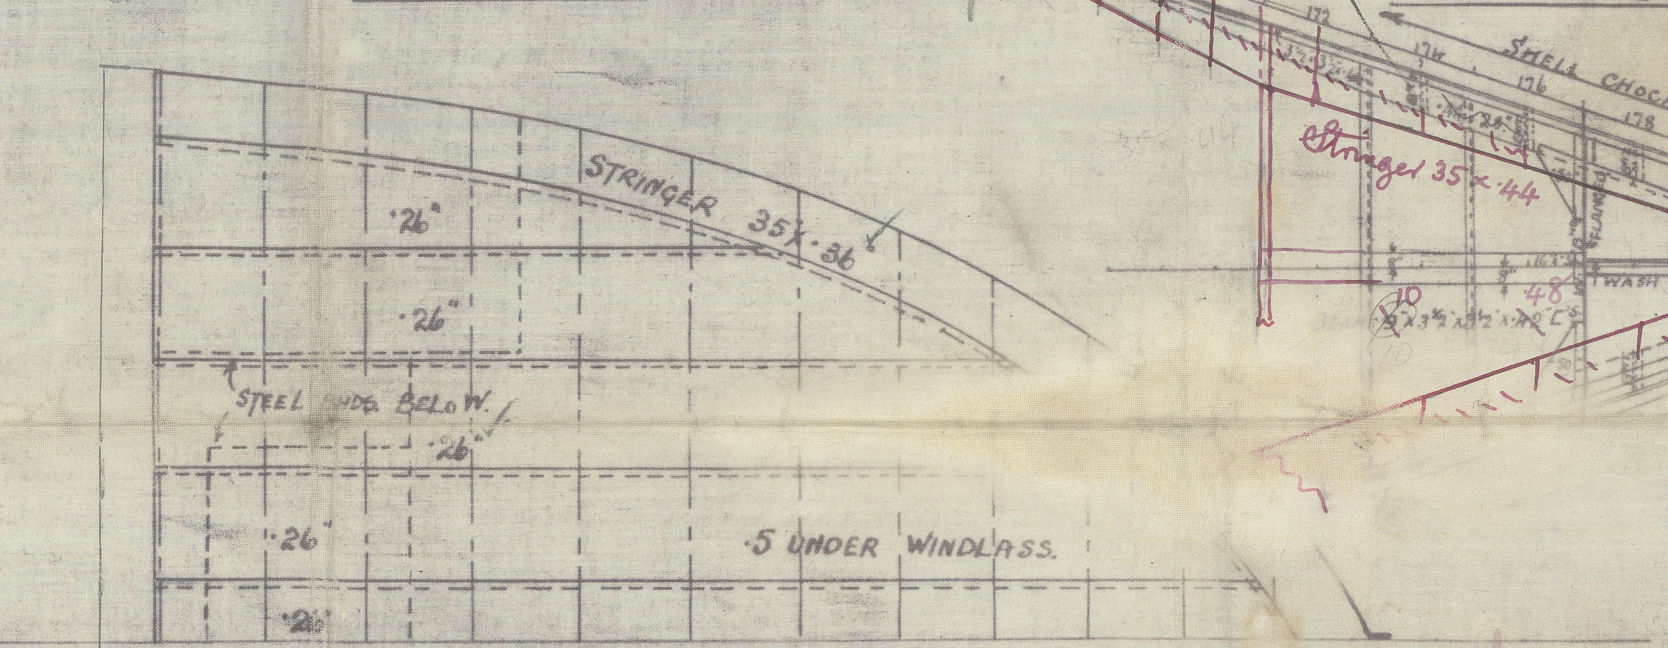

Profile & Deck Plans

Mr. Henderson & Co.

N^o 498/500

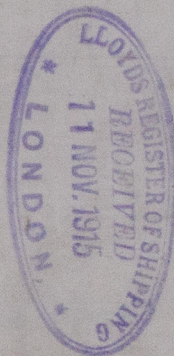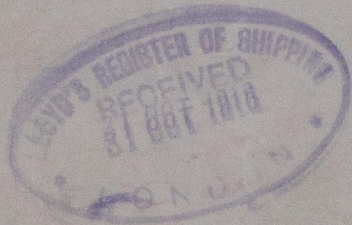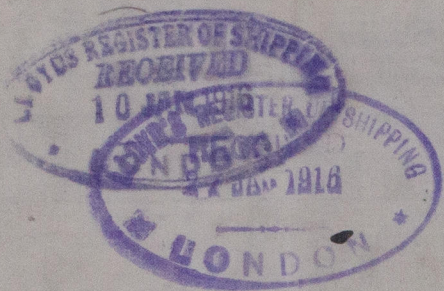

GLASGOW REPORT No. 37234

7/5 Actor.



GLASGOW REPORT No. 37948


7/5 Governor.

W60-0184



© 2020

Lloyd's Register
Foundation

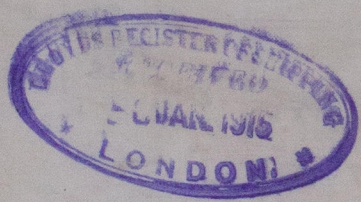

© 2020

Lloyd's Register
Foundation