

Received at

Office,

199

Lloyd's Register of British and Foreign Shipping.

Wania
(Report on Vessel No. 19699 Port *Glasgow.*)

No. *8324* SHIP FORGINGS OR CASTINGS.

I have to report that the undermentioned Iron or Steel Forgings or Castings,
manufactured by *The Dennytown Forge Co*

of *Dumbarton* for the Vessel No. *382*, being built
by *Messrs A McNeillan & Sons Dumbarton*

have been inspected by me as set forth below, and found to be, so far as can be seen,
Sound & efficient

The words FORGINGS or CASTINGS, IRON or STEEL, should be struck out as may be required.


Mark on Forgings.

Lloyd's
No. *8324*
W. H.

William Hamilton
Glasgow

	STERN FRAME.	RUDDER FRAME.	STEM.
Material* ...	<i>Scrap iron</i>		
How made ...	<i>Forged</i>		
Dimensions ...	<i>11 x 3</i>		
Progress on Inspection	<i>Forging & smithing</i>		
Date when Inspected	<i>25/6/07 to 12/8/07</i>		

SKETCHES OF FRAMES SHOWING POSITION AND DESCRIPTION OF WELDS OF FORGINGS, OR PARTICULARS OF TESTS APPLIED TO CASTINGS.

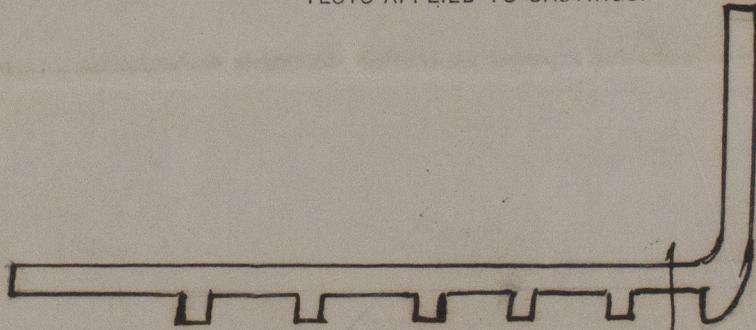

But weld 2020
Lloyd's Register
Foundation
W/601-0340

Fee (if any chargeable) £ : :
To be paid at x

* If of Iron, state whether scrap or puddled Iron.