


T.S.S. SPEEDONIA



LONGITUDINAL & DECK PLAN.

SCALE $\frac{1}{8}" = 1'-0"$

NOTE EXPANSION TRUNK SIDE, CARRIED UP TO UNDERSIDE OF DECKHOUSE

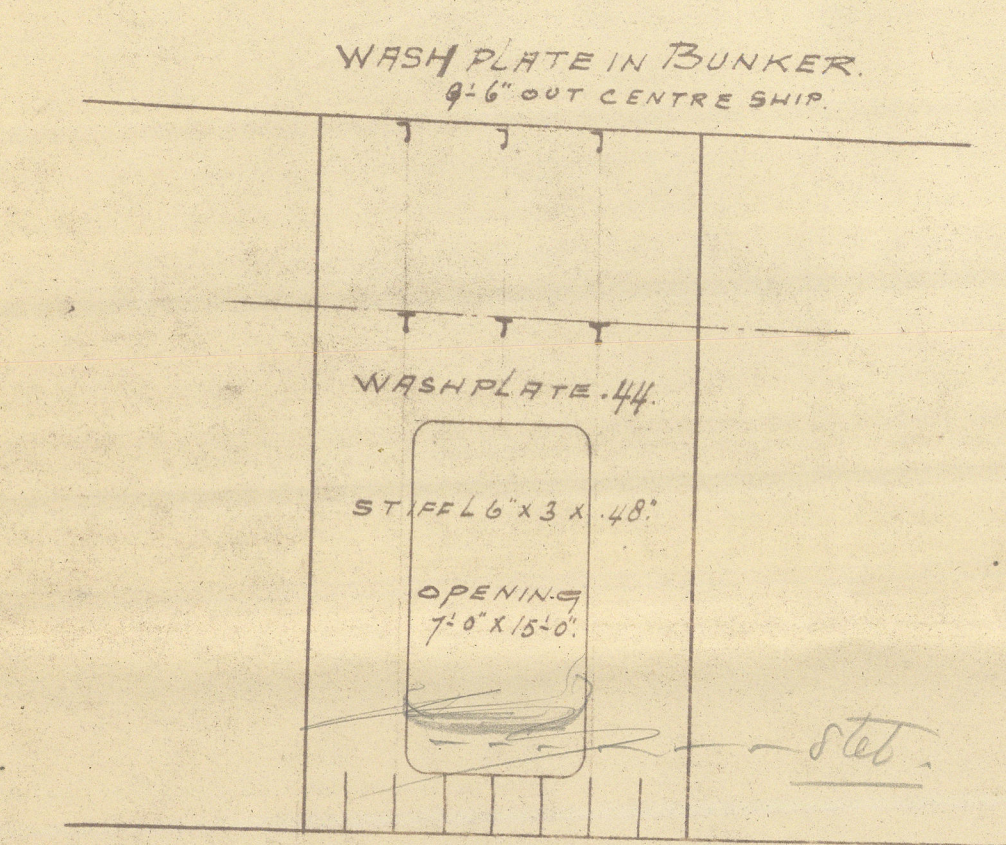

SHELL STRINGERS TO REMAIN AS AT PRESENT PLAN.

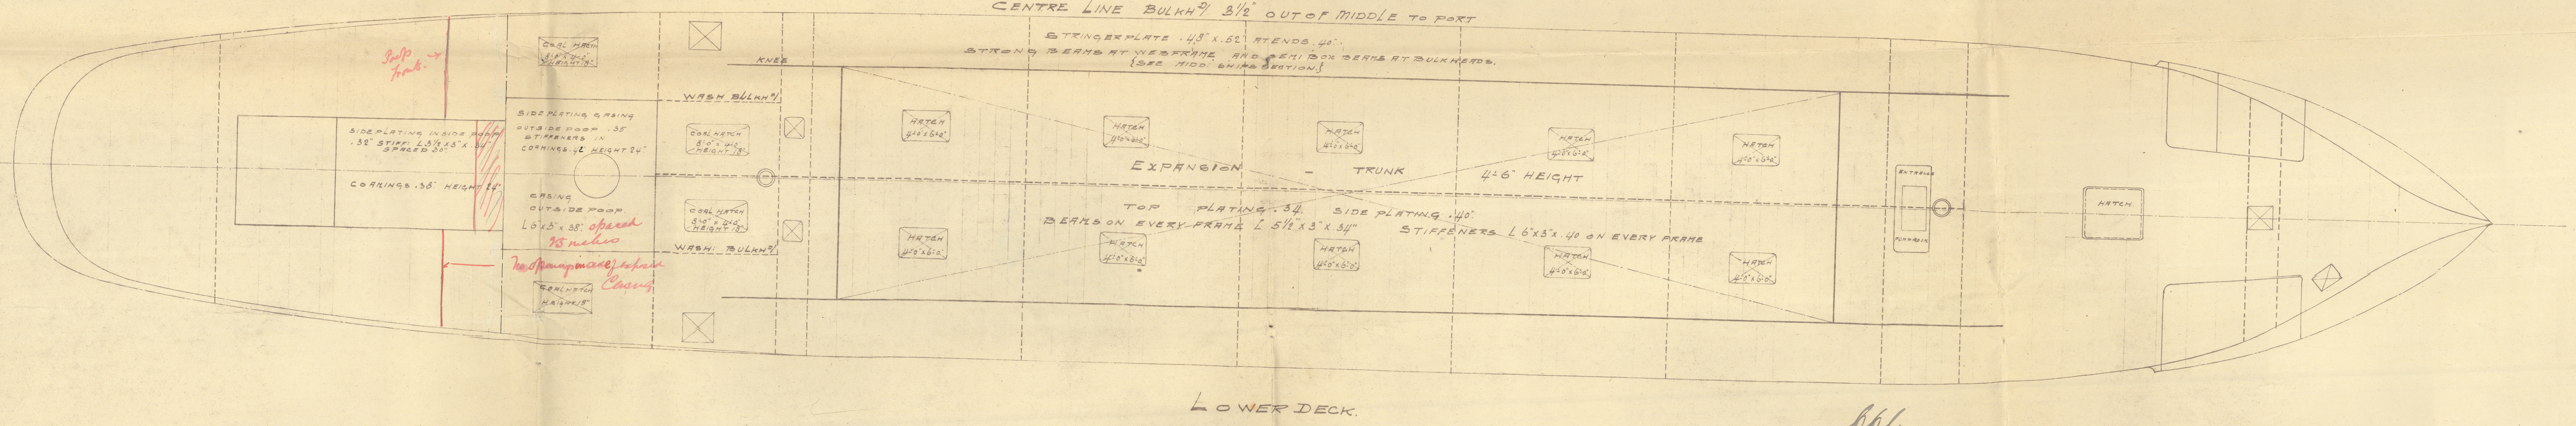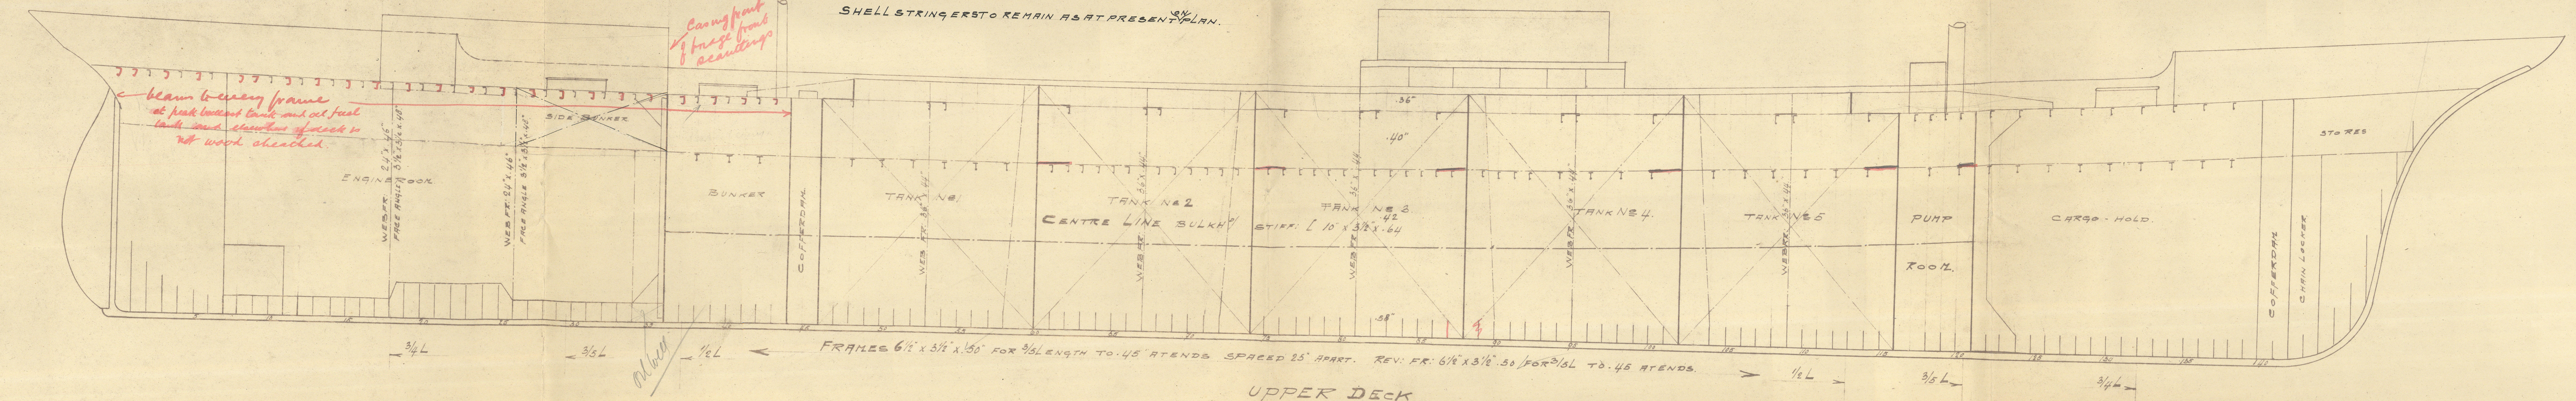

664
25.1.21.

BILLAGE
No. 475



N601-0347

W601-0347

RETAIN



© 2020

Lloyd's Register
Foundation