


ELEVATION
LOOKING OUTBOARD

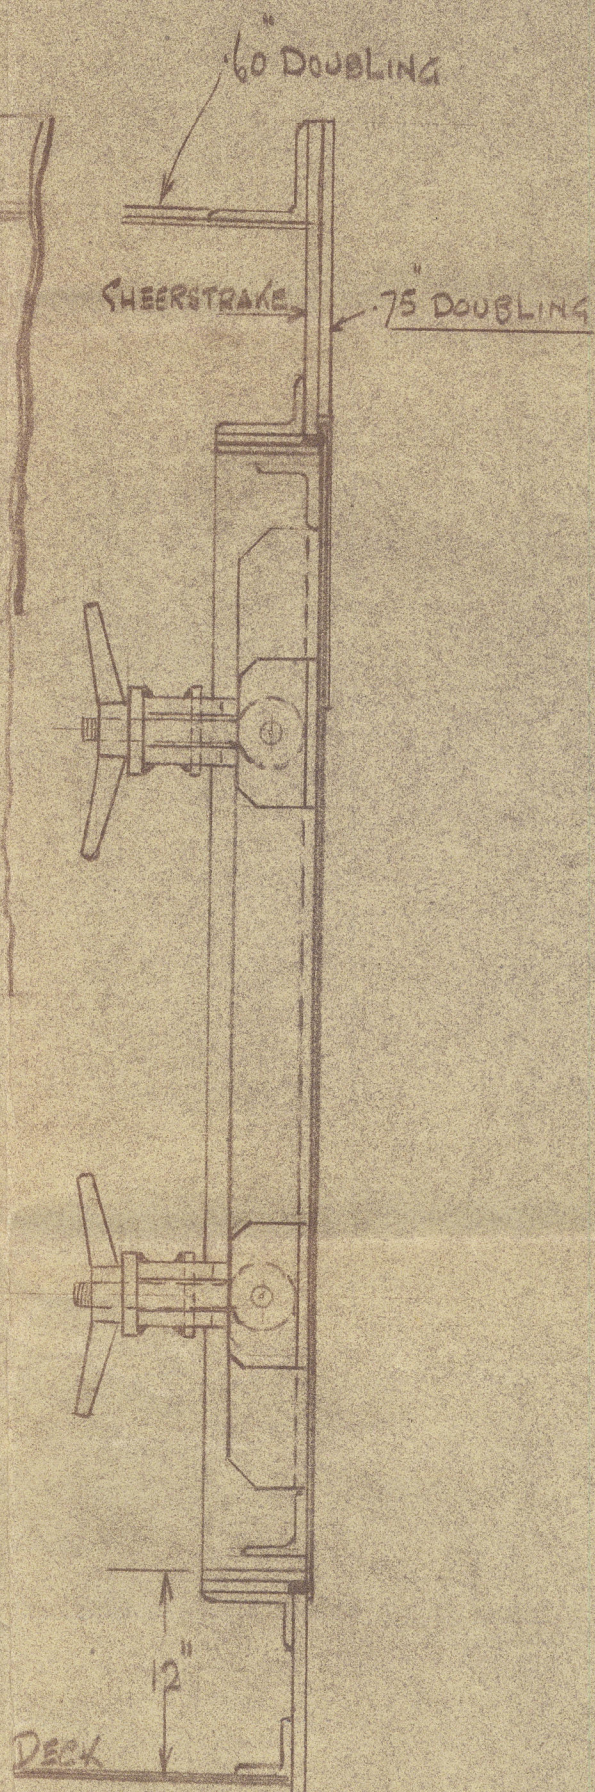

SECTION


S.S. "NARDANA"

EMBARKATION DOORS



Nº 224 SHELTER TW DECKS

PORT & STARD


SCALES - $\frac{1}{4}$ 1 & 3 = 1 FOOT

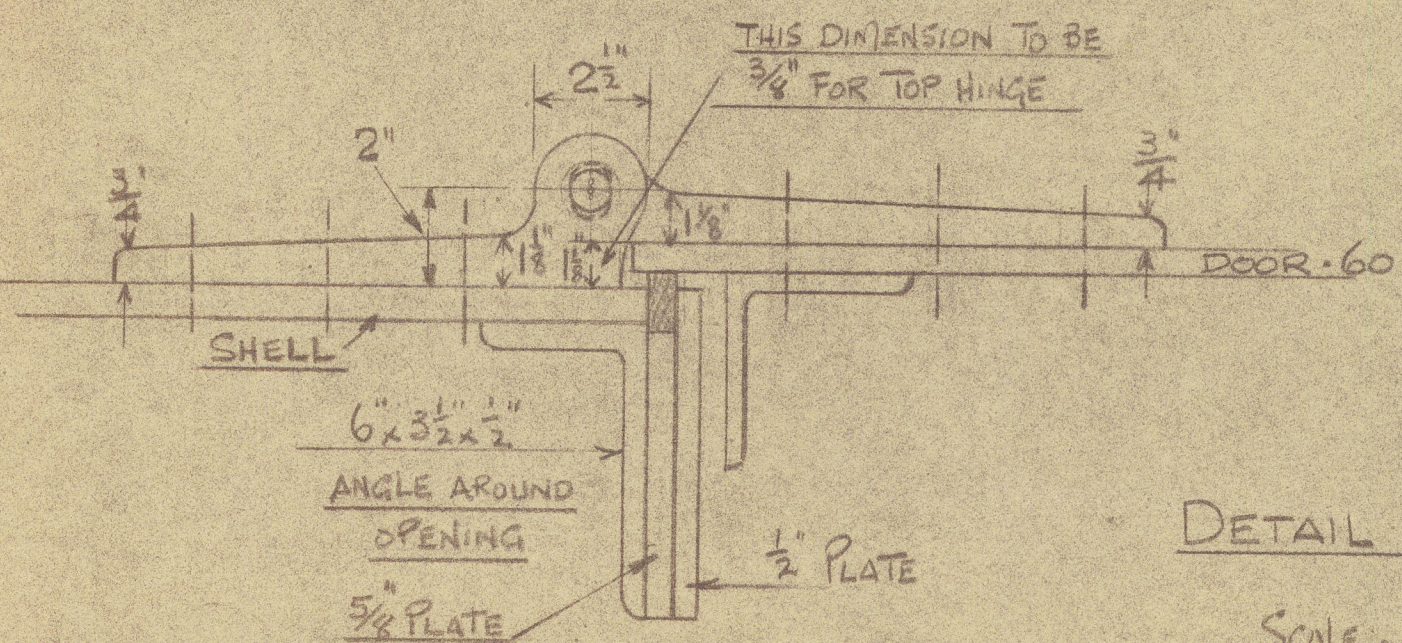

DETAIL OF HINGE
SCALE - 3" = 1 FOOT

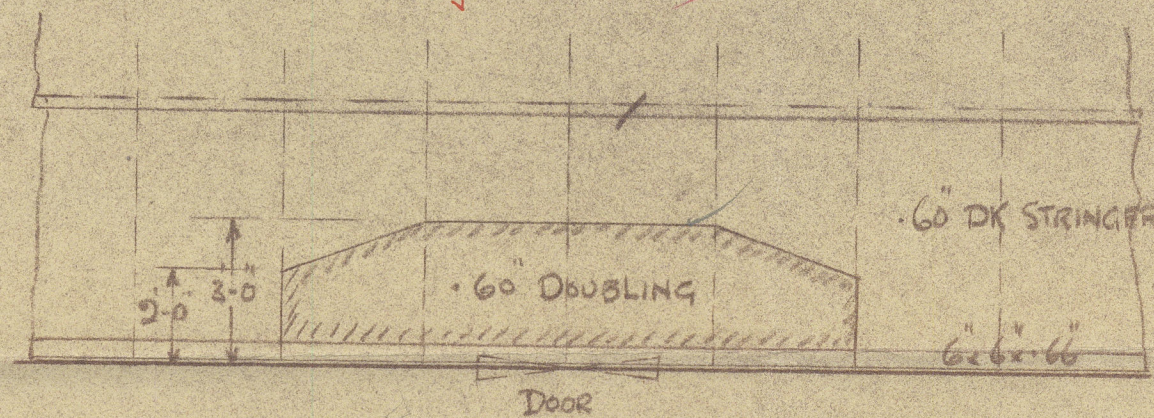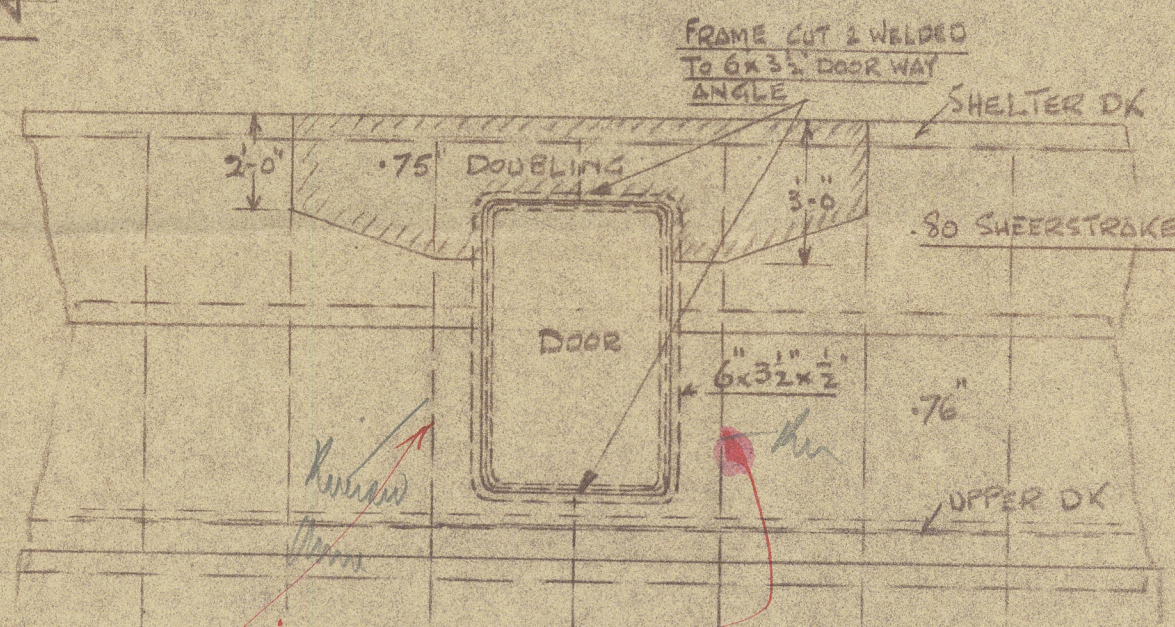


STIFFENING IN WAY OF DOORS

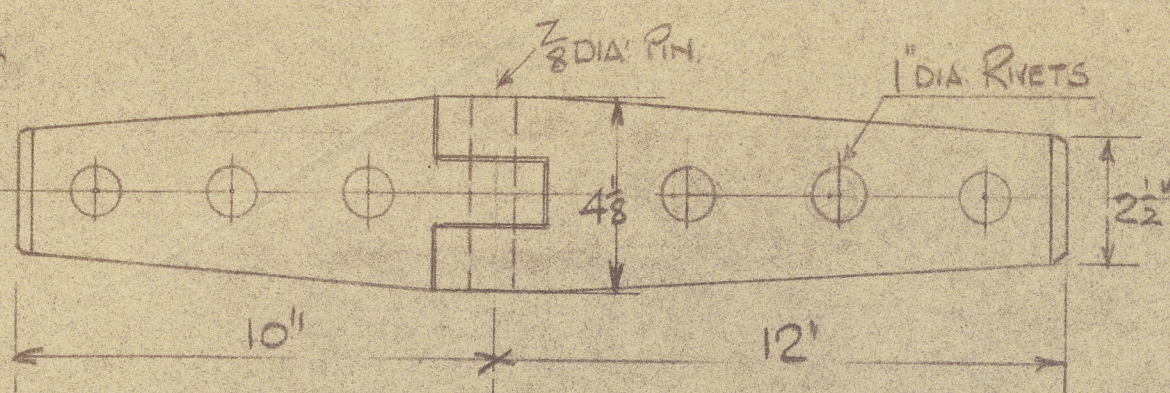

3'-6" CLEAR

20 3/8'

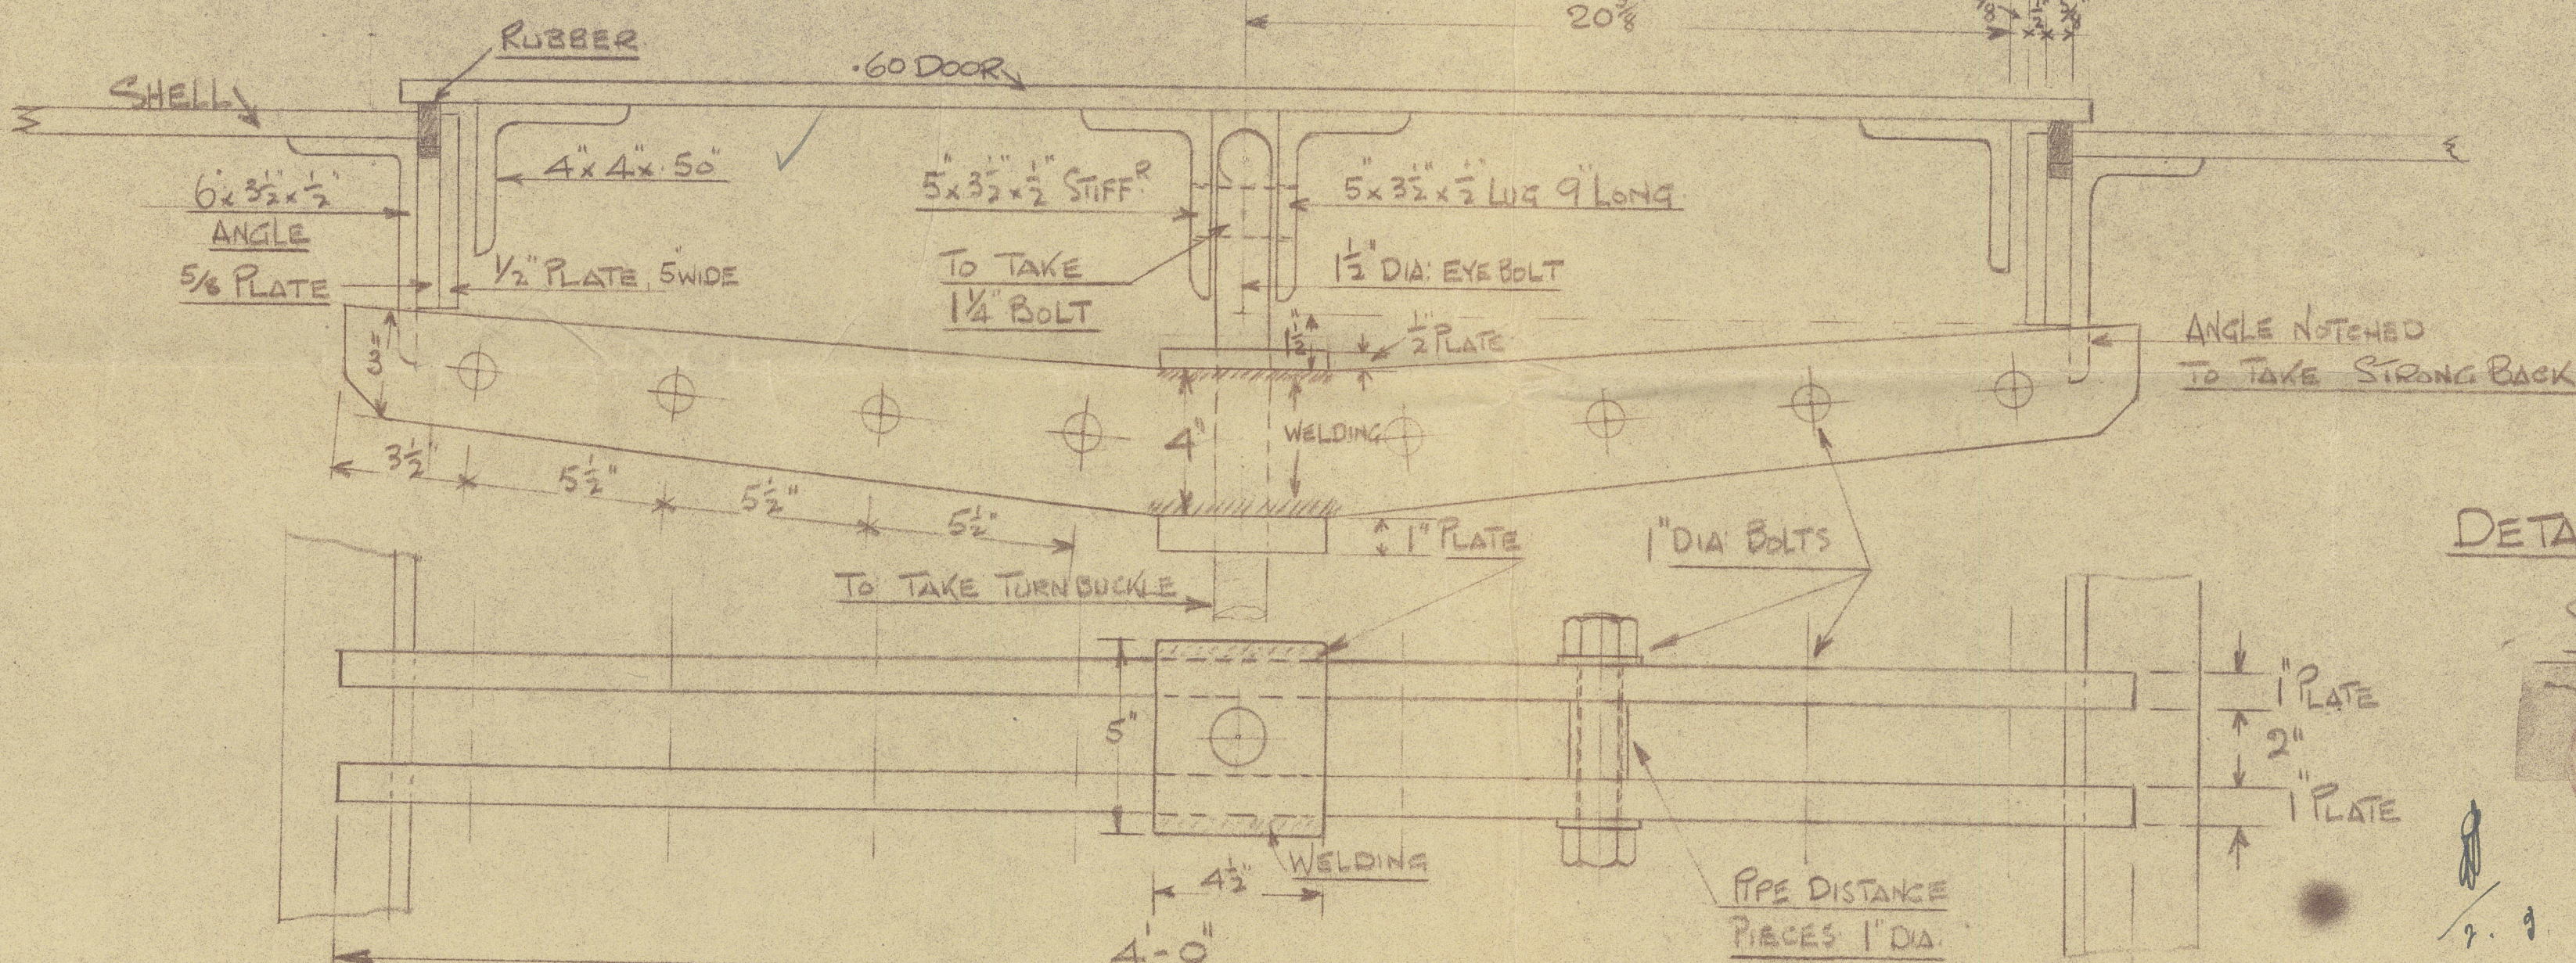

DETAIL OF STRONGBACK

SCALE - 3" = 1 FOOT



© 2021

Lloyd's Register
Foundation

S. S. "Nardana"

Amended plan of
proposed Embarkation Boats
No 2+4 Shelter Tween Decks
Port & starboard

W61-0023



© 2021

Lloyd's Register
Foundation