


Approved on the understanding that these doors are accessible at all times.

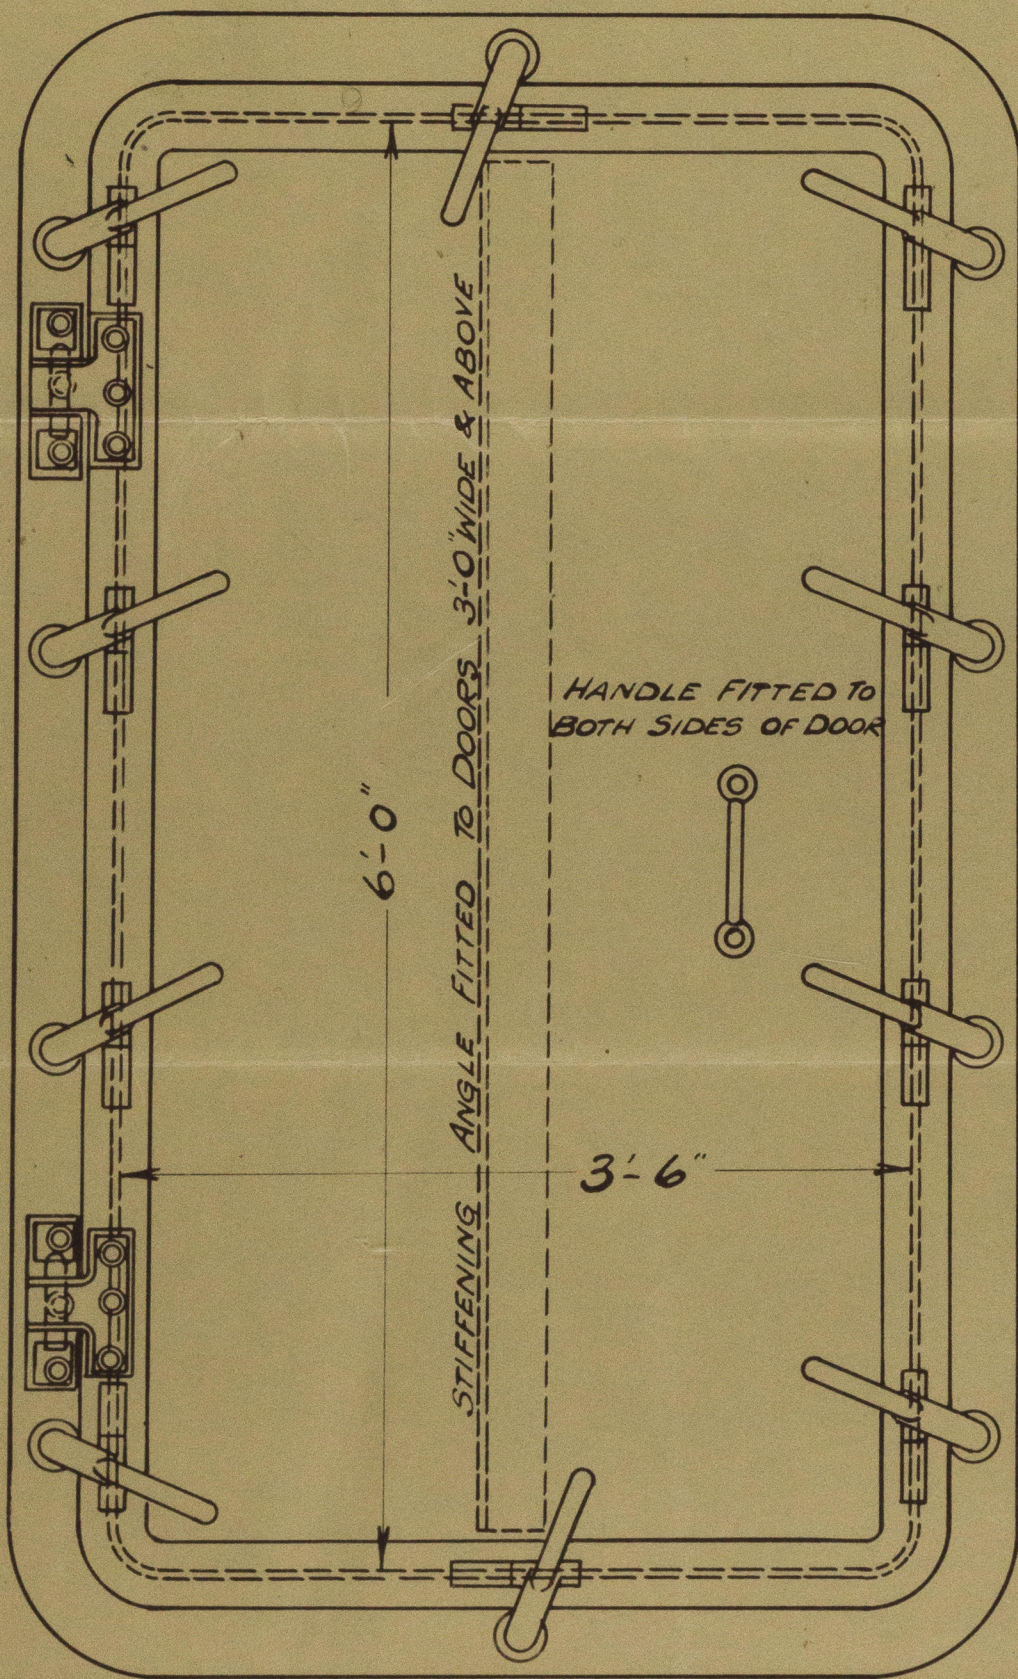

PROPOSED HINGED W. T. BULKHEAD
DOORS IN LOWER TWEEN DECK (MECHAN'S TYPE G)
BETWEEN NOS 1-2, 2-3, 4-5 & 5-6 HOLDS.

S. S. "NARDANA"

S. S. "Nardana"

Proposed Hinged W. I.

Buckhead doors in

Lower Tween Decks.

W61-0024



© 2021

Lloyd's Register
Foundation