


Approved on the understanding that these doors
are accessible at all times.

24.2.37
LLOYD'S REGISTER OF SHIPPING

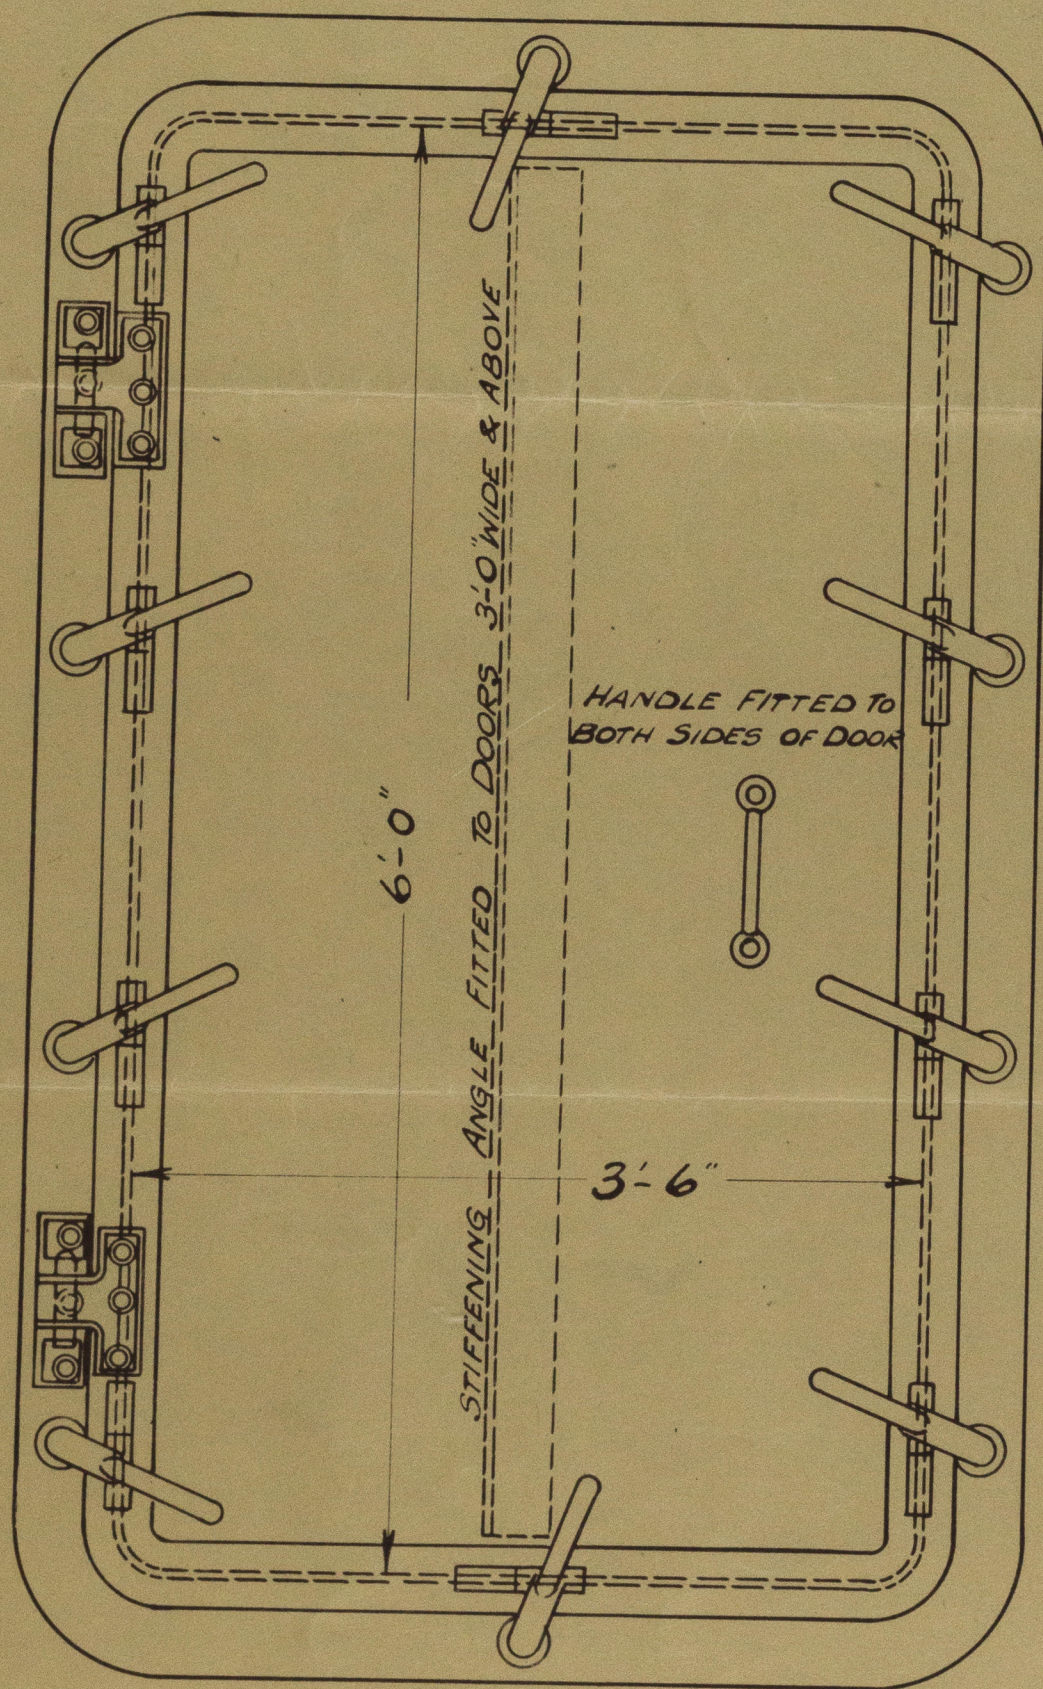

24.2.37

PROPOSED HINGED W.T. BULKHEAD
DOORS IN LOWER TWEEN DECK (MECHAN'S TYPE C)
BETWEEN NOS 1-2, 2-3, 4-5 & 5-6 HOLDS.

S. S. "NARDANA."

ENGINEERS & SHIPBUILDERS
COX & CO. ENGINEERS
27/137
FALMOUTH, ENGLAND
BOILER MAKERS, FOUNDERS, ETC.

S. S. "Nardana"

Proposed Hinged W.T.
Bulkhead doors in
Lower Tween Decks.

W61-0025



© 2021

Lloyd's Register
Foundation