

 


11.9.11
9.10.11
20.10.11



 


No 15
Main & Lower Decks
Scale 1" = 10'

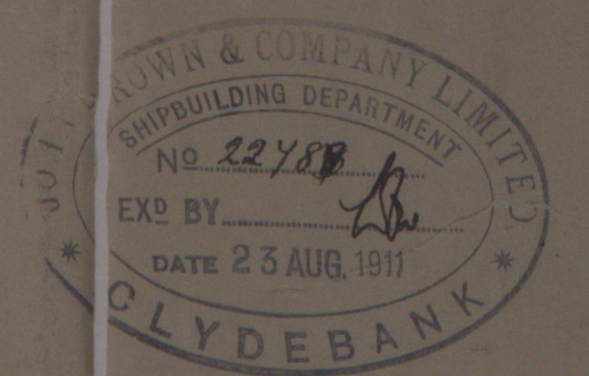


John Brown & Co


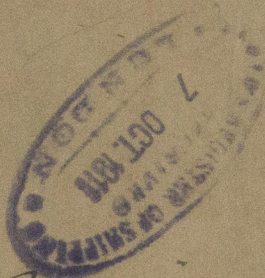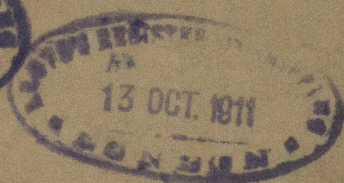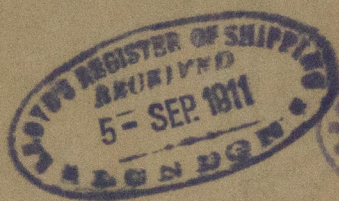

“
Niagara
”

GLASGOW REPORT No. 32426.

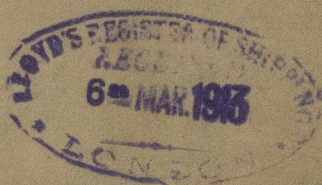

W61 - 0164



© 2021

Lloyd's Register
Foundation