


11.9.11  
9.10.11  
9.2.12  
25.9.12  
22.10.12


Lloyds

T<sup>R</sup> S S N<sup>o</sup> 415  
SECTIONS IN OIL FUEL SPACES

SCALE 1/2" = 1 FOOT

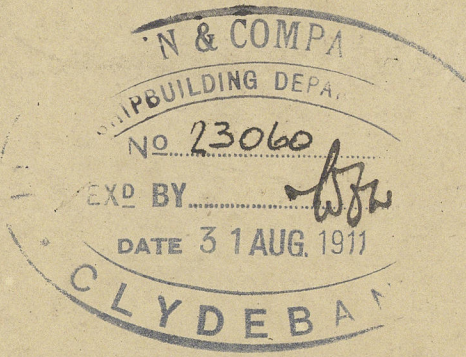

NOTE: BRACKETS WHERE FRAMES ARE CUT AT DECK ARE SHOWN OF REDUCED SIZE  
ON ACCOUNT OF SPACING OF WEBS - SEE PROFILE

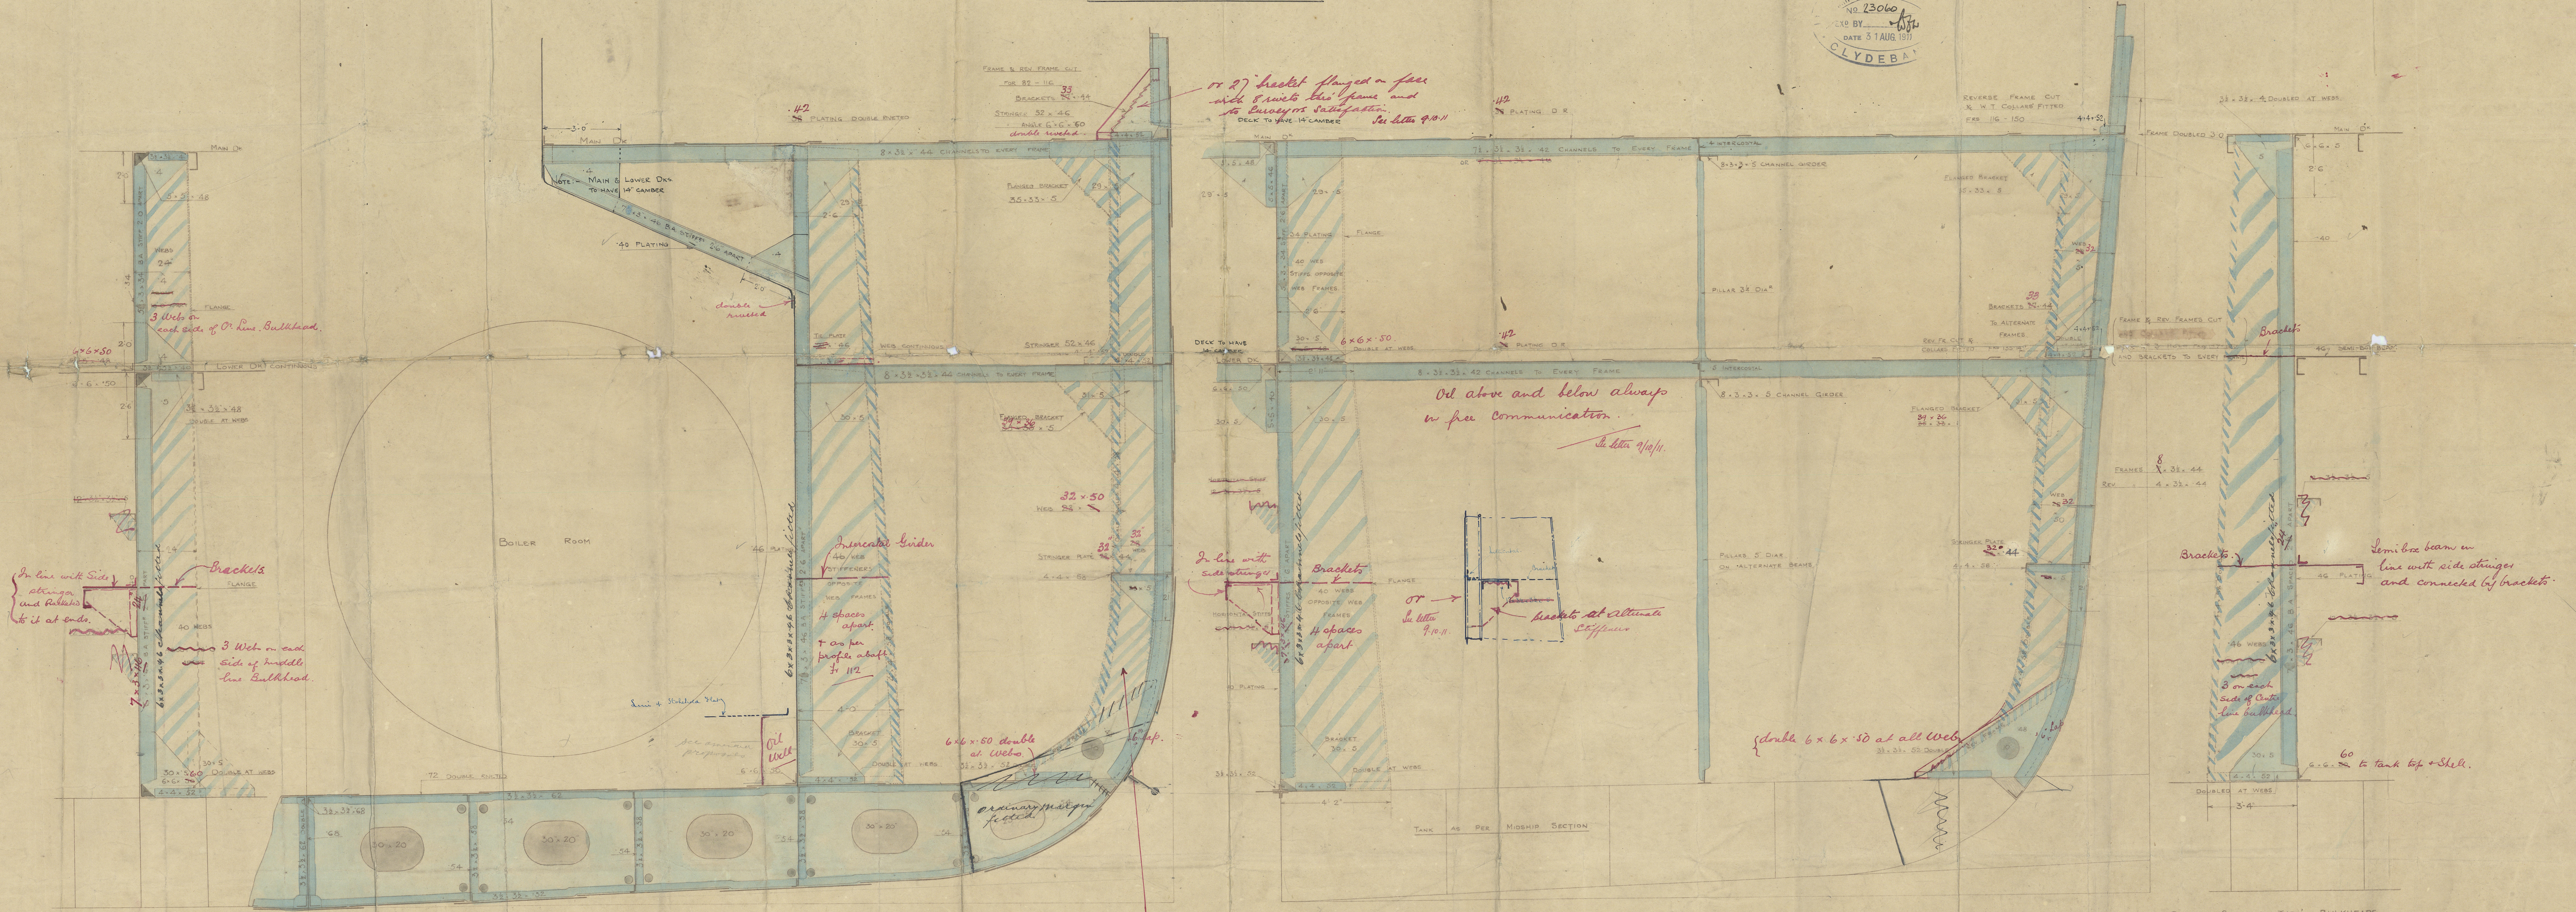

GENERAL SECTION THRO BULKHEADS  
BROKEN AT LOWER DE.


SECTION AT FRAME 114.

SECTION AT FRAME 140

GENERAL SECTION THRO BULKHEADS  
FROM TANK TO MAIN DE.  
CONTINUOUS

These webs to be increased to  
36 x 54 between bulkheads.  
33 x 112 in view of their spacing.

Oil above and below always  
in free communication.  
See letter 9/10/11.

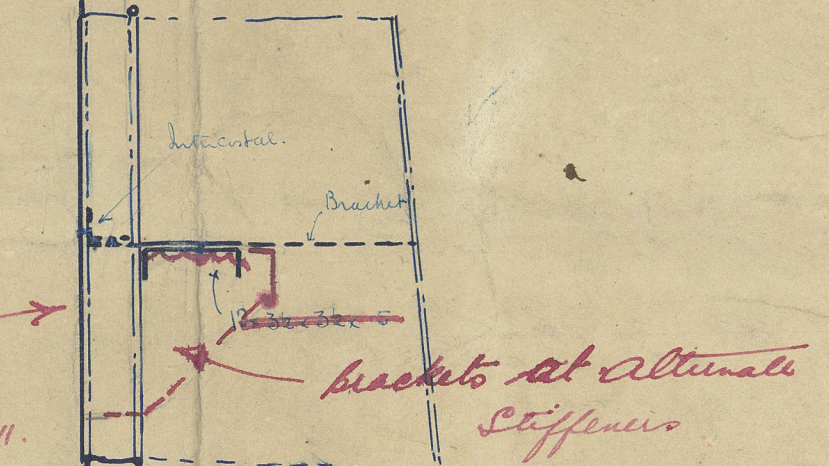


C.F.

C.B.  
11.9.11.  
9.10.11



John Brown & Co


9-415

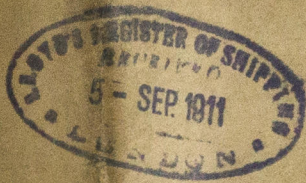

Sections in way of  
Oil Fuel & Bulkheads



"Niagara"

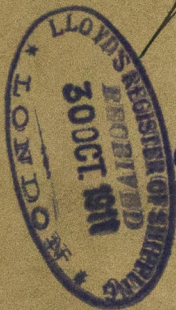

GLASGOW REPORT No. 32426



W61-0168



© 2021

Lloyd's Register  
Foundation