


Nº 415.

OUTLINE SECTION SHEWING ALTERATIONS TO RISE OF FLOOR, INNER BOTTOM AND "d"

SCALE $\frac{1}{4}" = 1 \text{ FOOT.}$

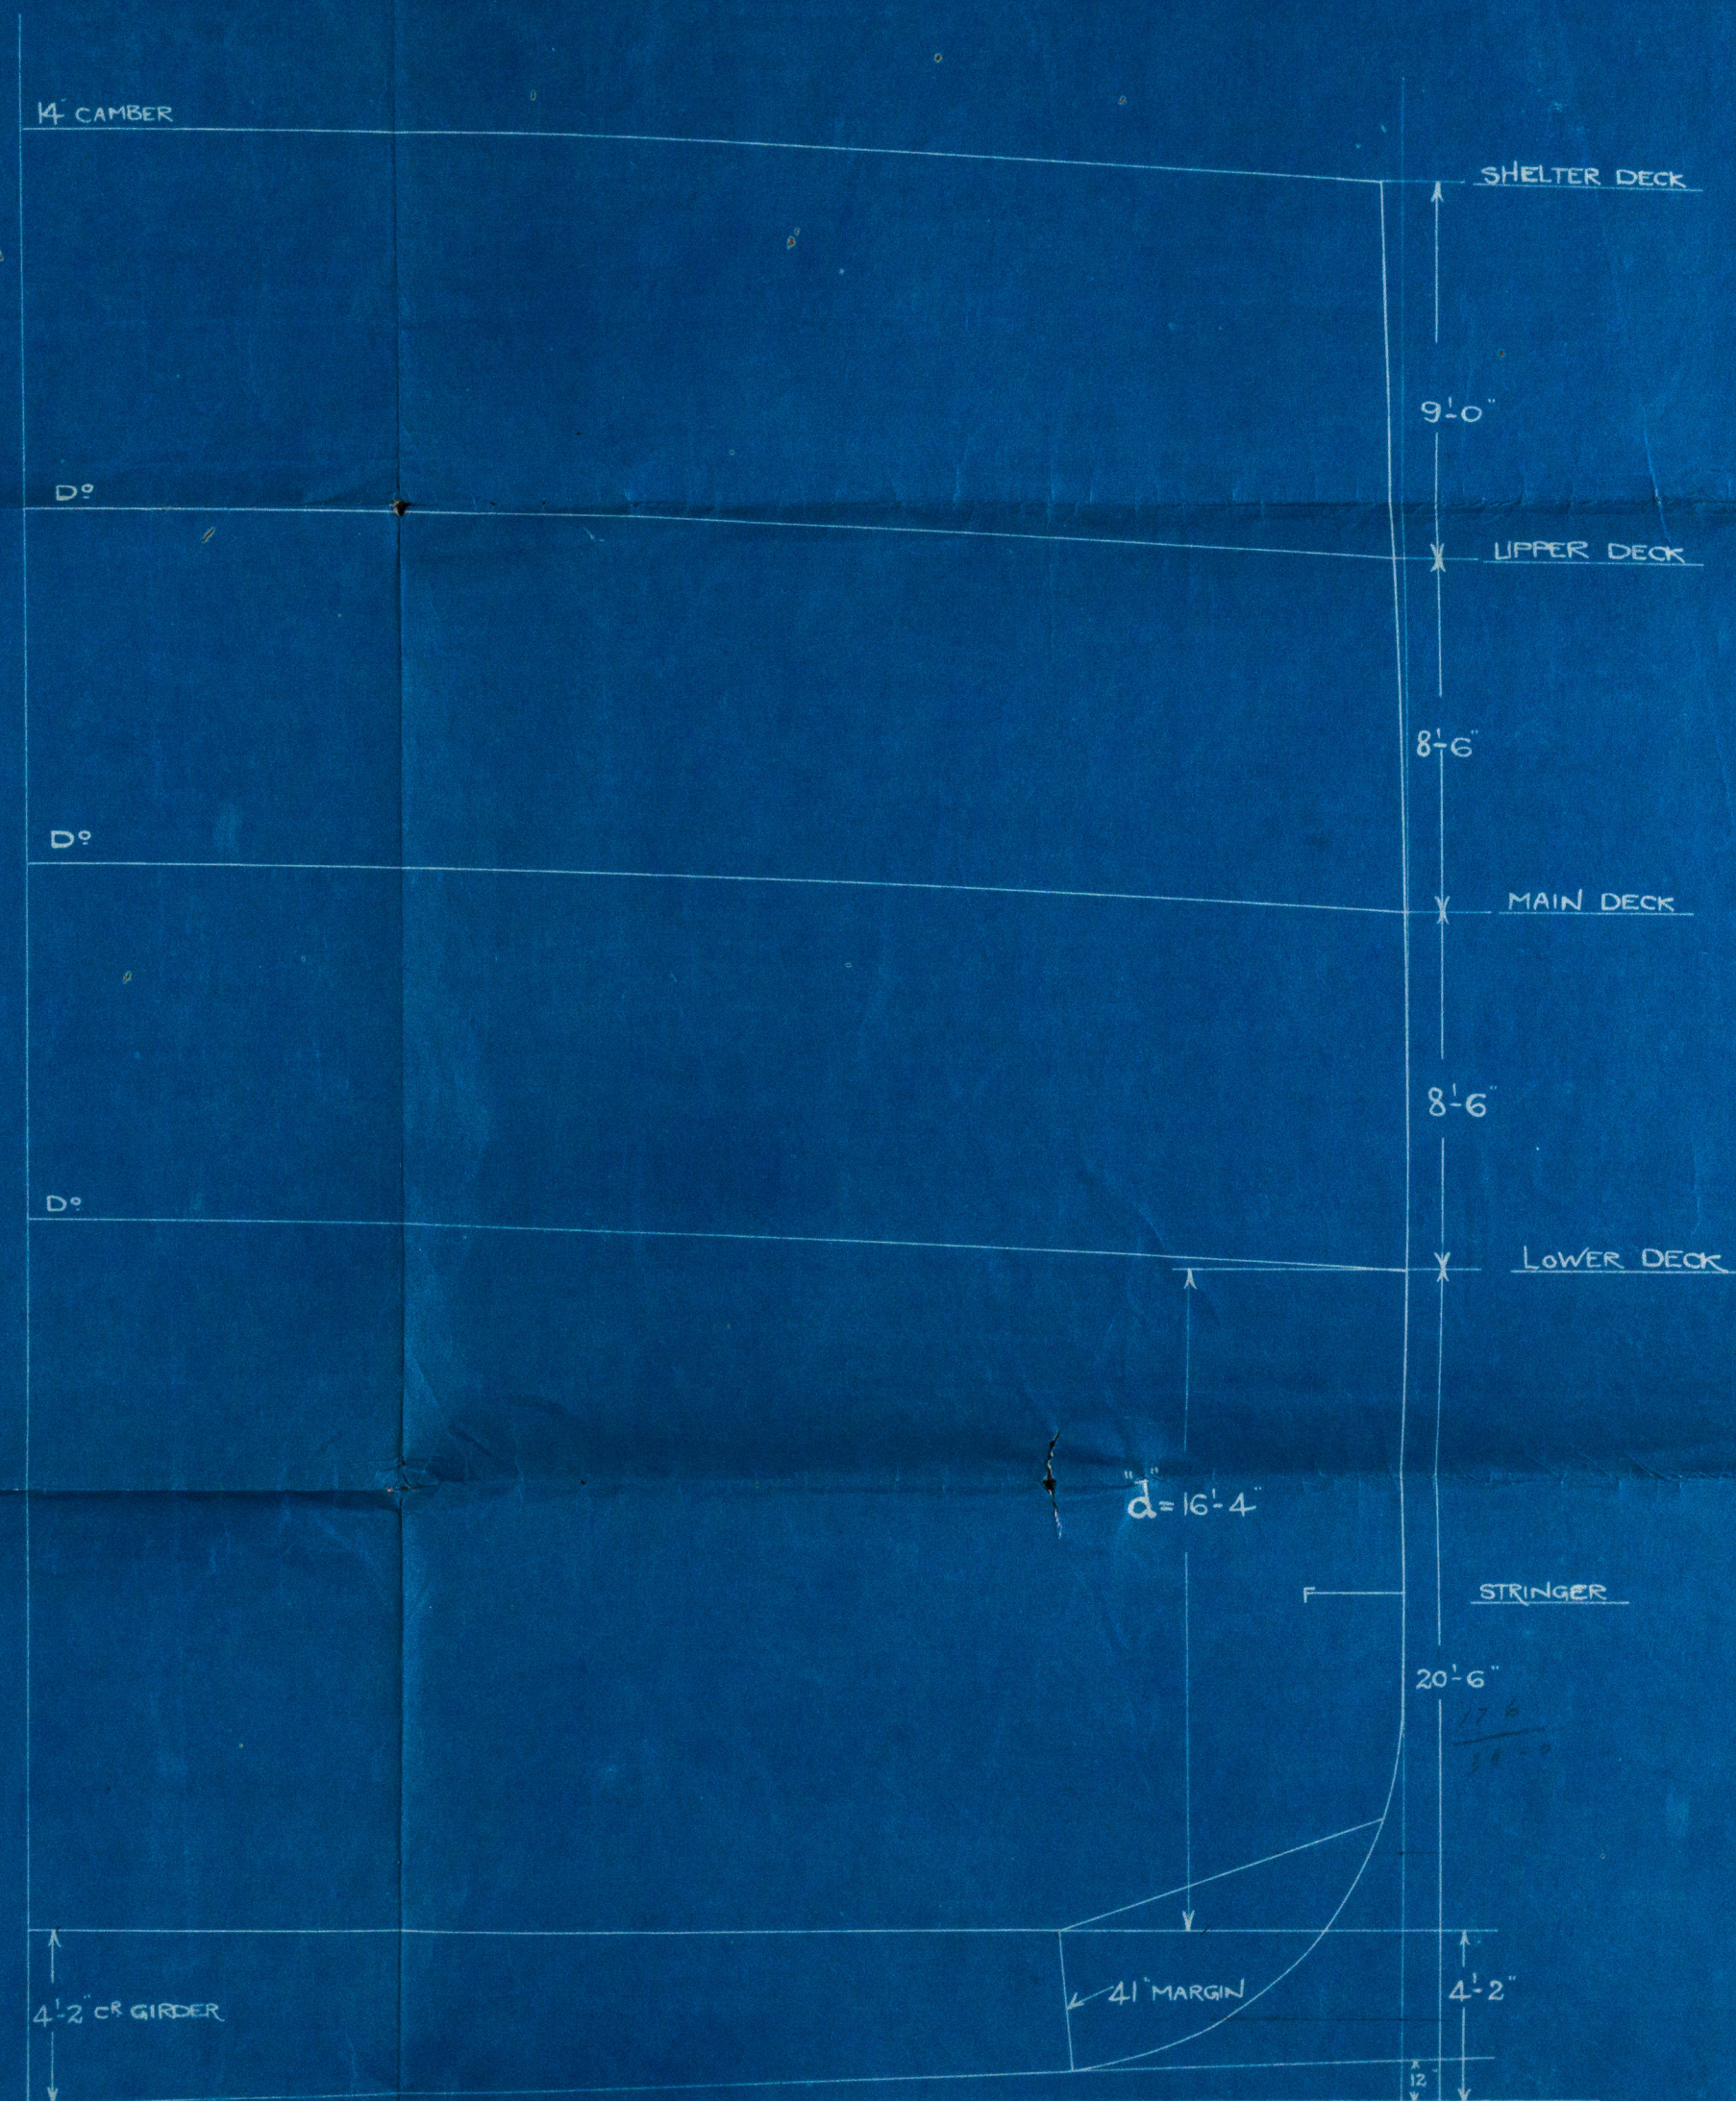


Lloyd's Register
Foundation

1610-1910

John Brown & Co


No 415

Outline Machinery
Section showing
alteration to rise
of floor.

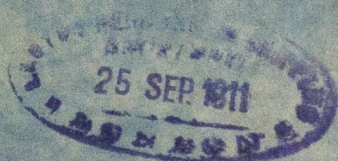

"Niagara"

GLASGOW REPORT No 32426.

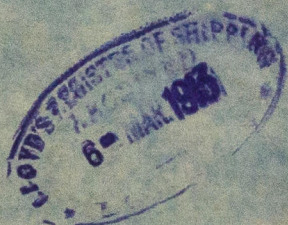

W61-0169



© 2021

Lloyd's Register
Foundation