
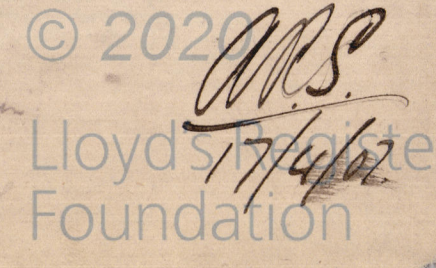


PROFILE N° 151.

SCALE 1/8" = 1 FOOT

DIMENSIONS - 410.0 x 52.0 EXT. x 30.6 MLD

24.4.07
17.9.07
26.3.08
9.7.08
22.6.08
7.12.08

 




W. H. W. & Co.
S. S. No. 157 456 7

PROFILE

410'-0" x 52'-0" x 30'-6" Mch.

Shuttle Deck



APR 26 1907

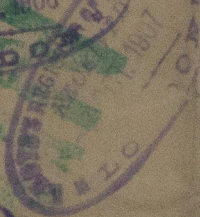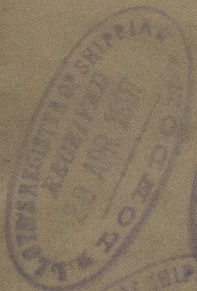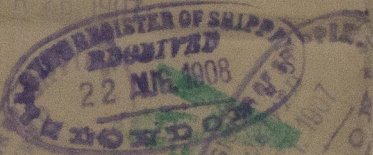

S. S. S. ANNAH

Newcastle Report

No 56732

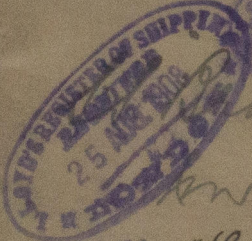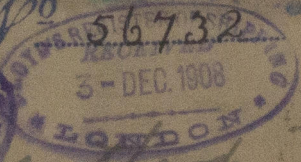

Manford

no 56732

S. S. "Galileo"

Newcastle Report

No 55377

© 2020



Lloyd's Register
Foundation

W619-0050