

MIDSHIP SECTION.


S.S. N° 221-222.

SCALE 1/2" = 1 FOOT.

SHIP'S DIMENSIONS: LENGTH 420'0" BREADTH EXTREME 53'6" DEPTH 30'6"
LODGE DIMENSIONS: LENGTH 419'42" BREADTH 53'16" DEPTH 30'5"

NUMERALS	
BREADTH MID	53'16"
DEPTH MID	30'5"
TWEEN DECKS	5
TRANSVERSE NUMBER	24'16"
LENGTH SP	419'42"
LONGITUDINAL NUMBER	35298
ERECTOR	2705
CASINGS, ETC.	461
EQUIPMENT NUMBER	38464
LENGTH - DEPTH TO SHEET DECK	10'76"
d	18'0"
Due To Increased Depth of T.O.B.	

EQUIPMENT	
2 BOW ANCHORS BLOCKS 66 CWT EACH	
1 Stream	Ex. Stock 58 1/2
1 KID	8
270 TONS 2 1/2" STAINLESS STEEL CABLE	
90	5
120	5 1/2
24 90	3 1/2
90	3 1/4
24 90	3
24 90	8
24 90	7
MANILA	

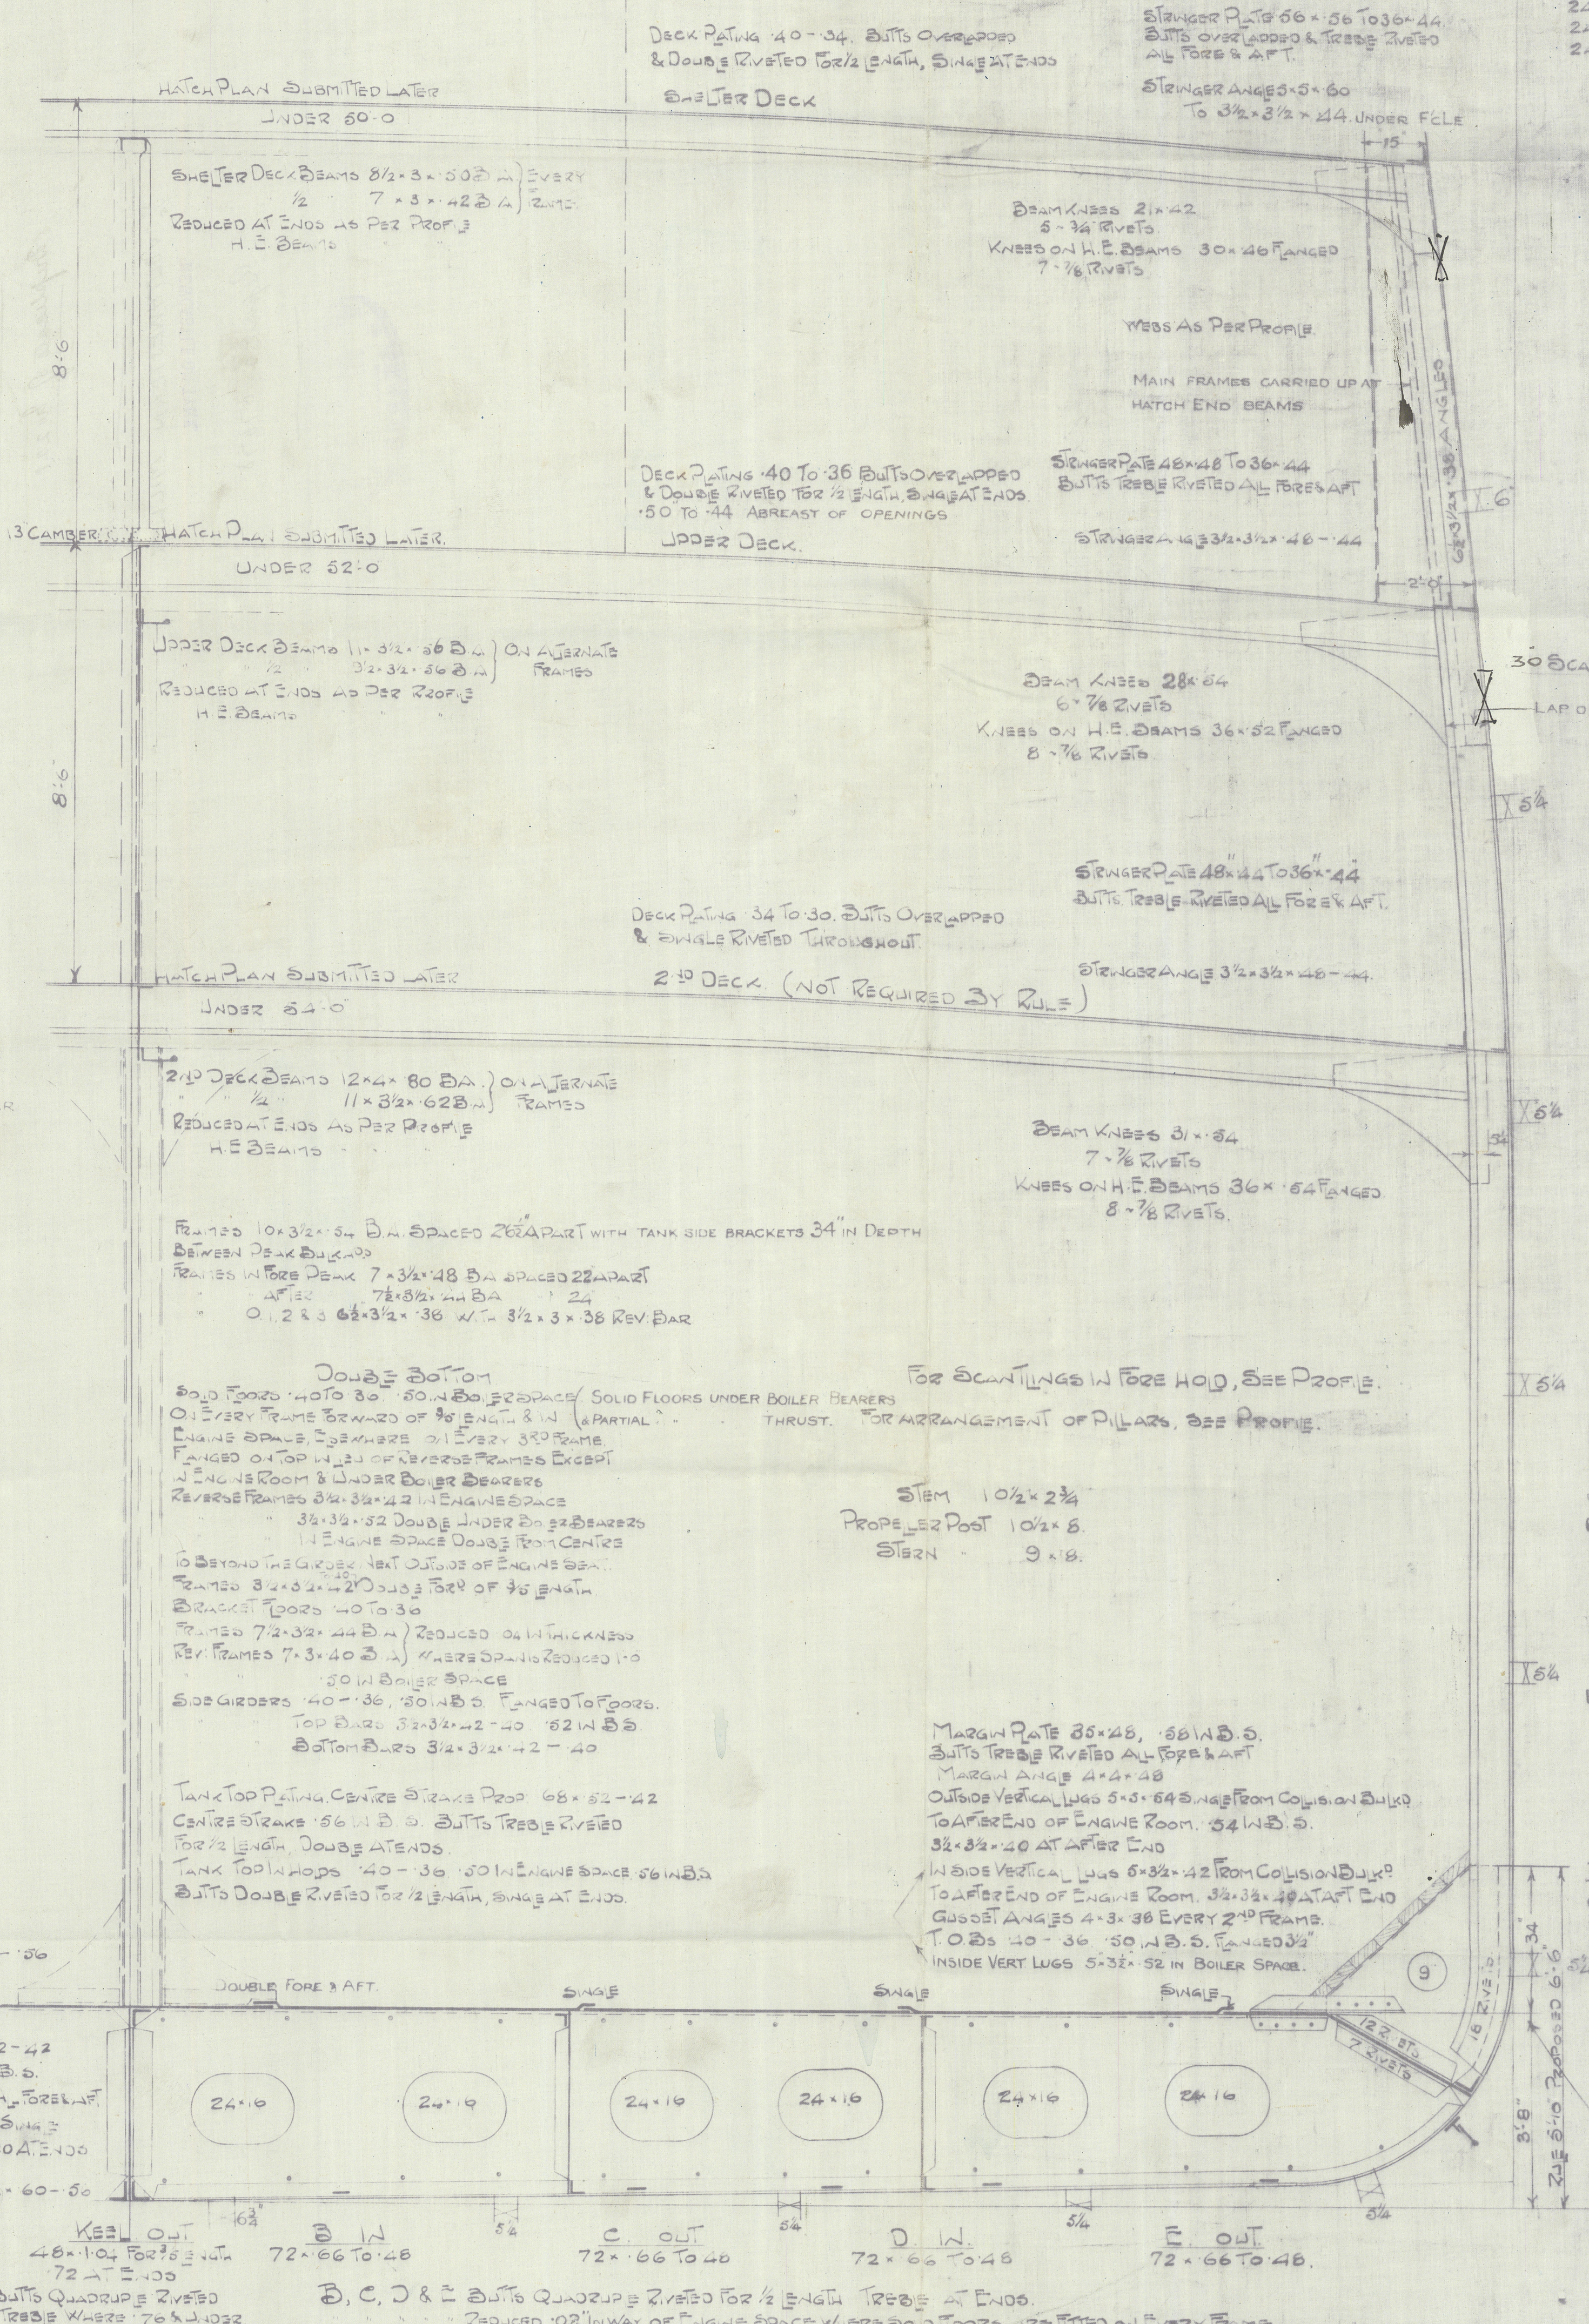

88 M. W.
76 x 66 to 48 x 46 in peaks
Butts overlapped & quadruple riveted
treble where 68 & under.

L. OUT
76 x 66 to 48 x 46 in peaks
Butts overlapped & quadruple riveted
for 1/2 length, treble at ends.

K. IN
72 x 66 to 48 x 46 in peaks
Butts treble riveted all fore & aft.
Quadruple if exceeding rule width


J. OUT
72 x 66 to 48 x 46 in peaks
Butts treble riveted all fore & aft.

H. W.
72 x 66 to 48 x 46 in peaks
Butts treble riveted all fore & aft.

G. OUT
72 x 66 to 48 x 46 in peaks
Butts treble riveted all fore & aft.

F. IN
69 x 66 to 48 x 46 in peaks
Butts quadruple riveted for 1/2 length
treble at ends

If Brackets are made
rule height = 26. Then
frames to be 10 x 3 1/2 x 56.

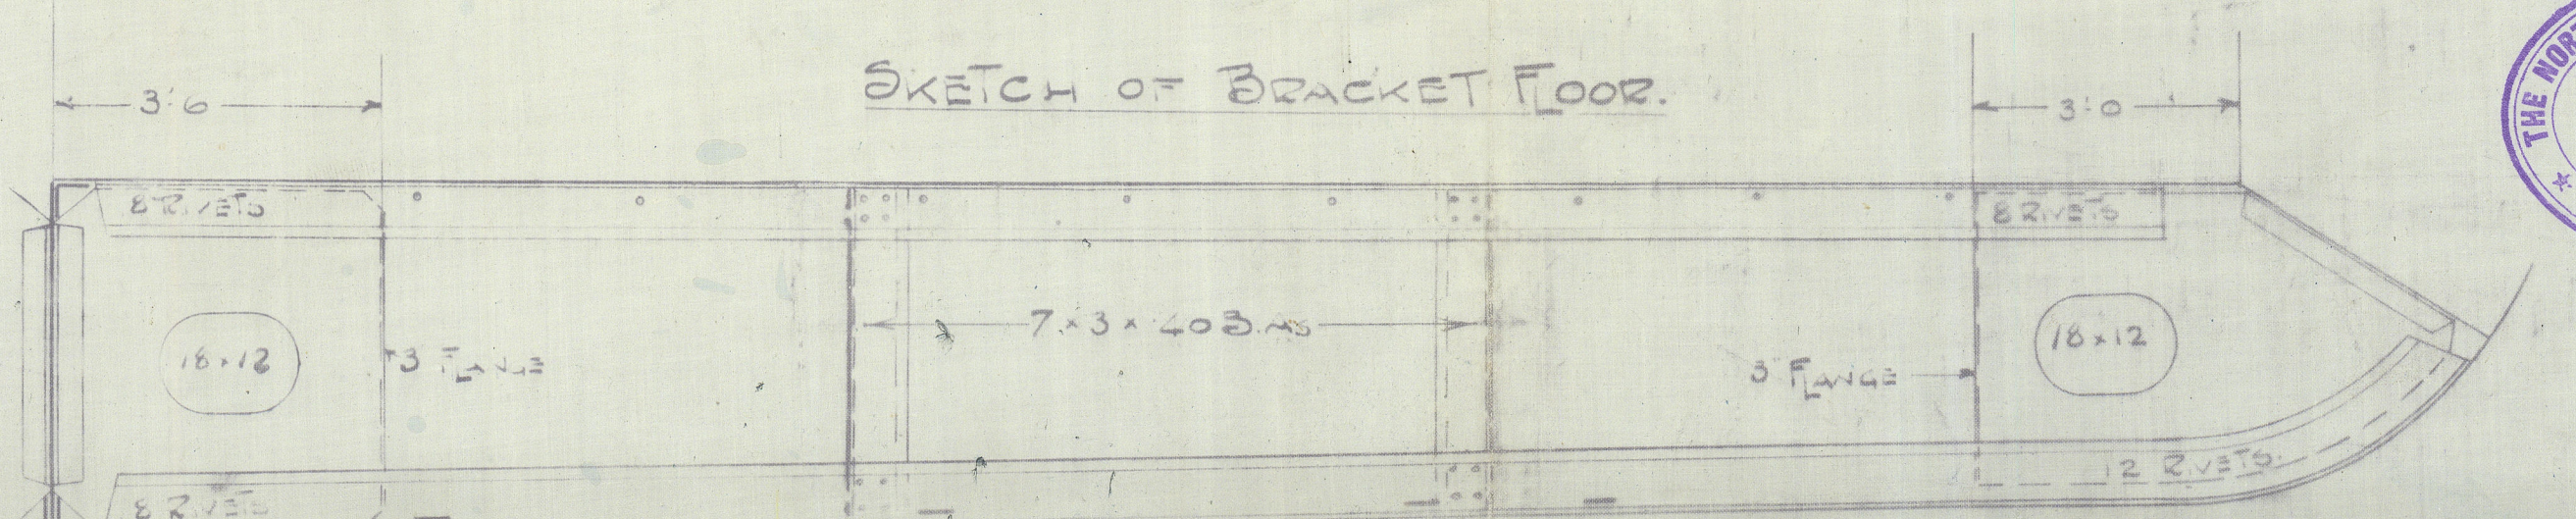

Northumberland S. Co

SS 222

Midship Section

Duplicate of No 221

$\frac{3}{8}$ " SOUTHWESTERN MILLER
NEWCASTLE-ON-TYNE

Report No 67678



RETAIN



© 2020

Lloyd's Register
Foundation

W 22-01-70