

Received
2/14/13
CLASSIFIED

10. 4. 13

LOYDS NUMERALS	
BREADTH UNBULDED	52.5
DEPTH UNBULDED	29.25
B.T.D. = TRANSVERSE NO. 81 Y.S.	
L x B.T.D. = 380.0 (52.5 x 29.25)	
LONGITUDINAL NO. = 31065	
L TO UPPER DECK = 12.99	

S.S.N. 355
MIDSHIP SECTION
DIMS: 380'0" x 52'6" x 29'3" MLD TO UPPER DECK.
ISMERWOOD SYSTEM — SCALE 1/2" = 1 FOOT.

Bracket attachments to be flanged as follows:-
all bracket attachments to flat of bottom and
to upper turn of bilge
all other bracket attachments which require at
least 10 rivets in them i.e. of 3'-3" breadth upwards

EQUIPMENT NUMBERS	
POD 92.5 x Y. 15	485
BRIDGE 25 x Y. 15	144
BRIDGE 25 x Y. 15	222
BRIDGE 25 x Y. 15	244
BRIDGE 25 x Y. 15	9

S.S. N^o 355.

Amended


Midship Section.

Messrs.


The York & North York Co. Ltd.



per Cassin
Greenock F. & Report N^o 16634.

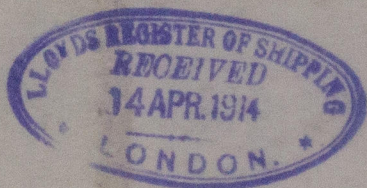

RETRIA

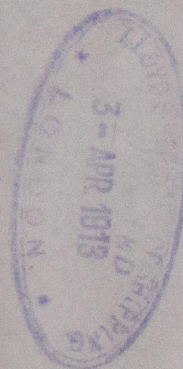

W 627-0103



© 2020

Lloyd's Register
Foundation