

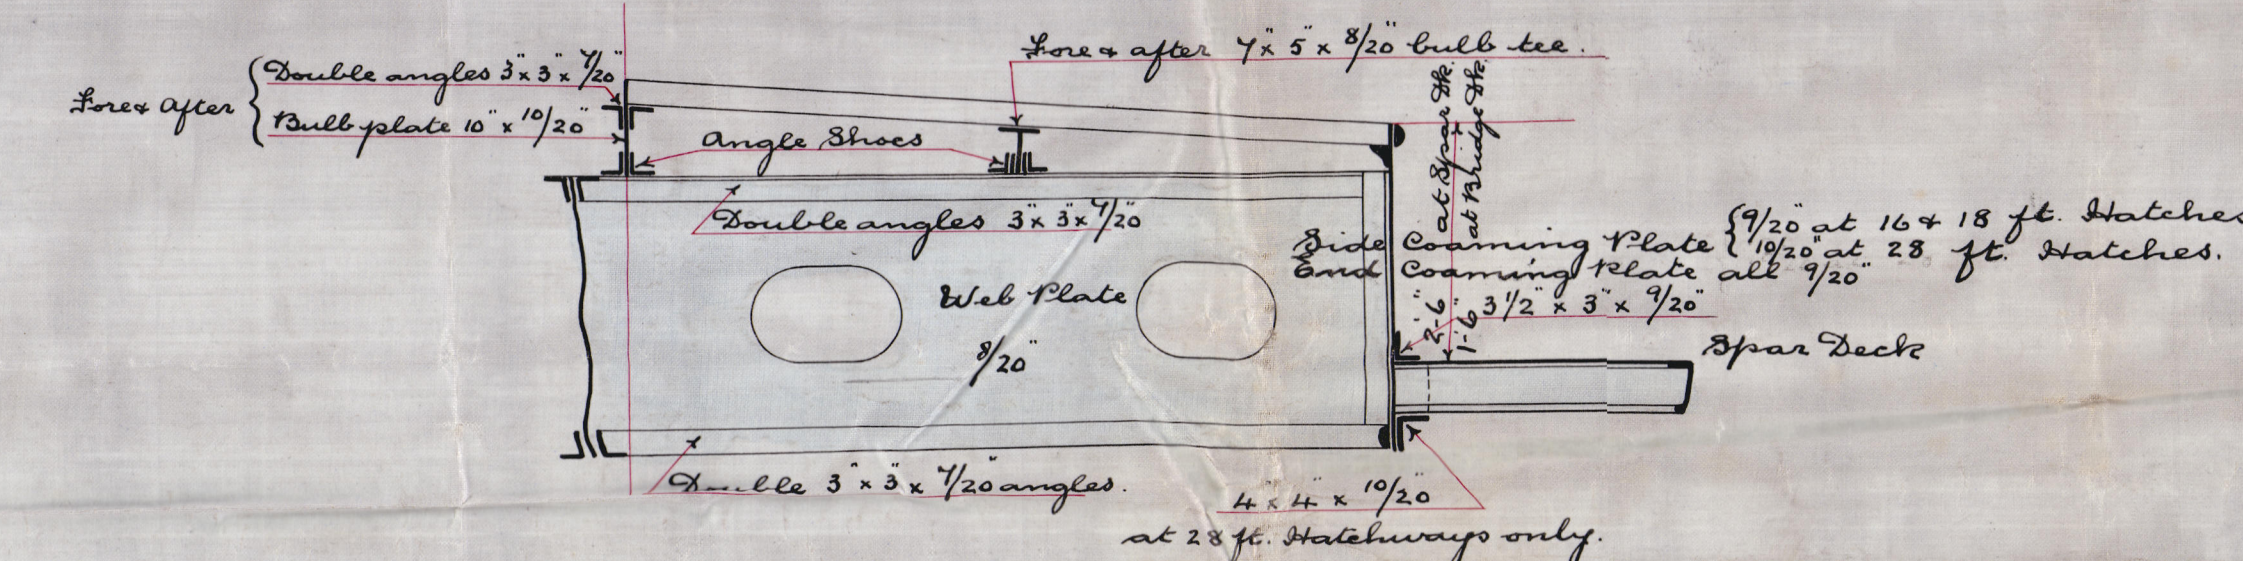


Scale $\frac{1}{8}$ " = One Foot

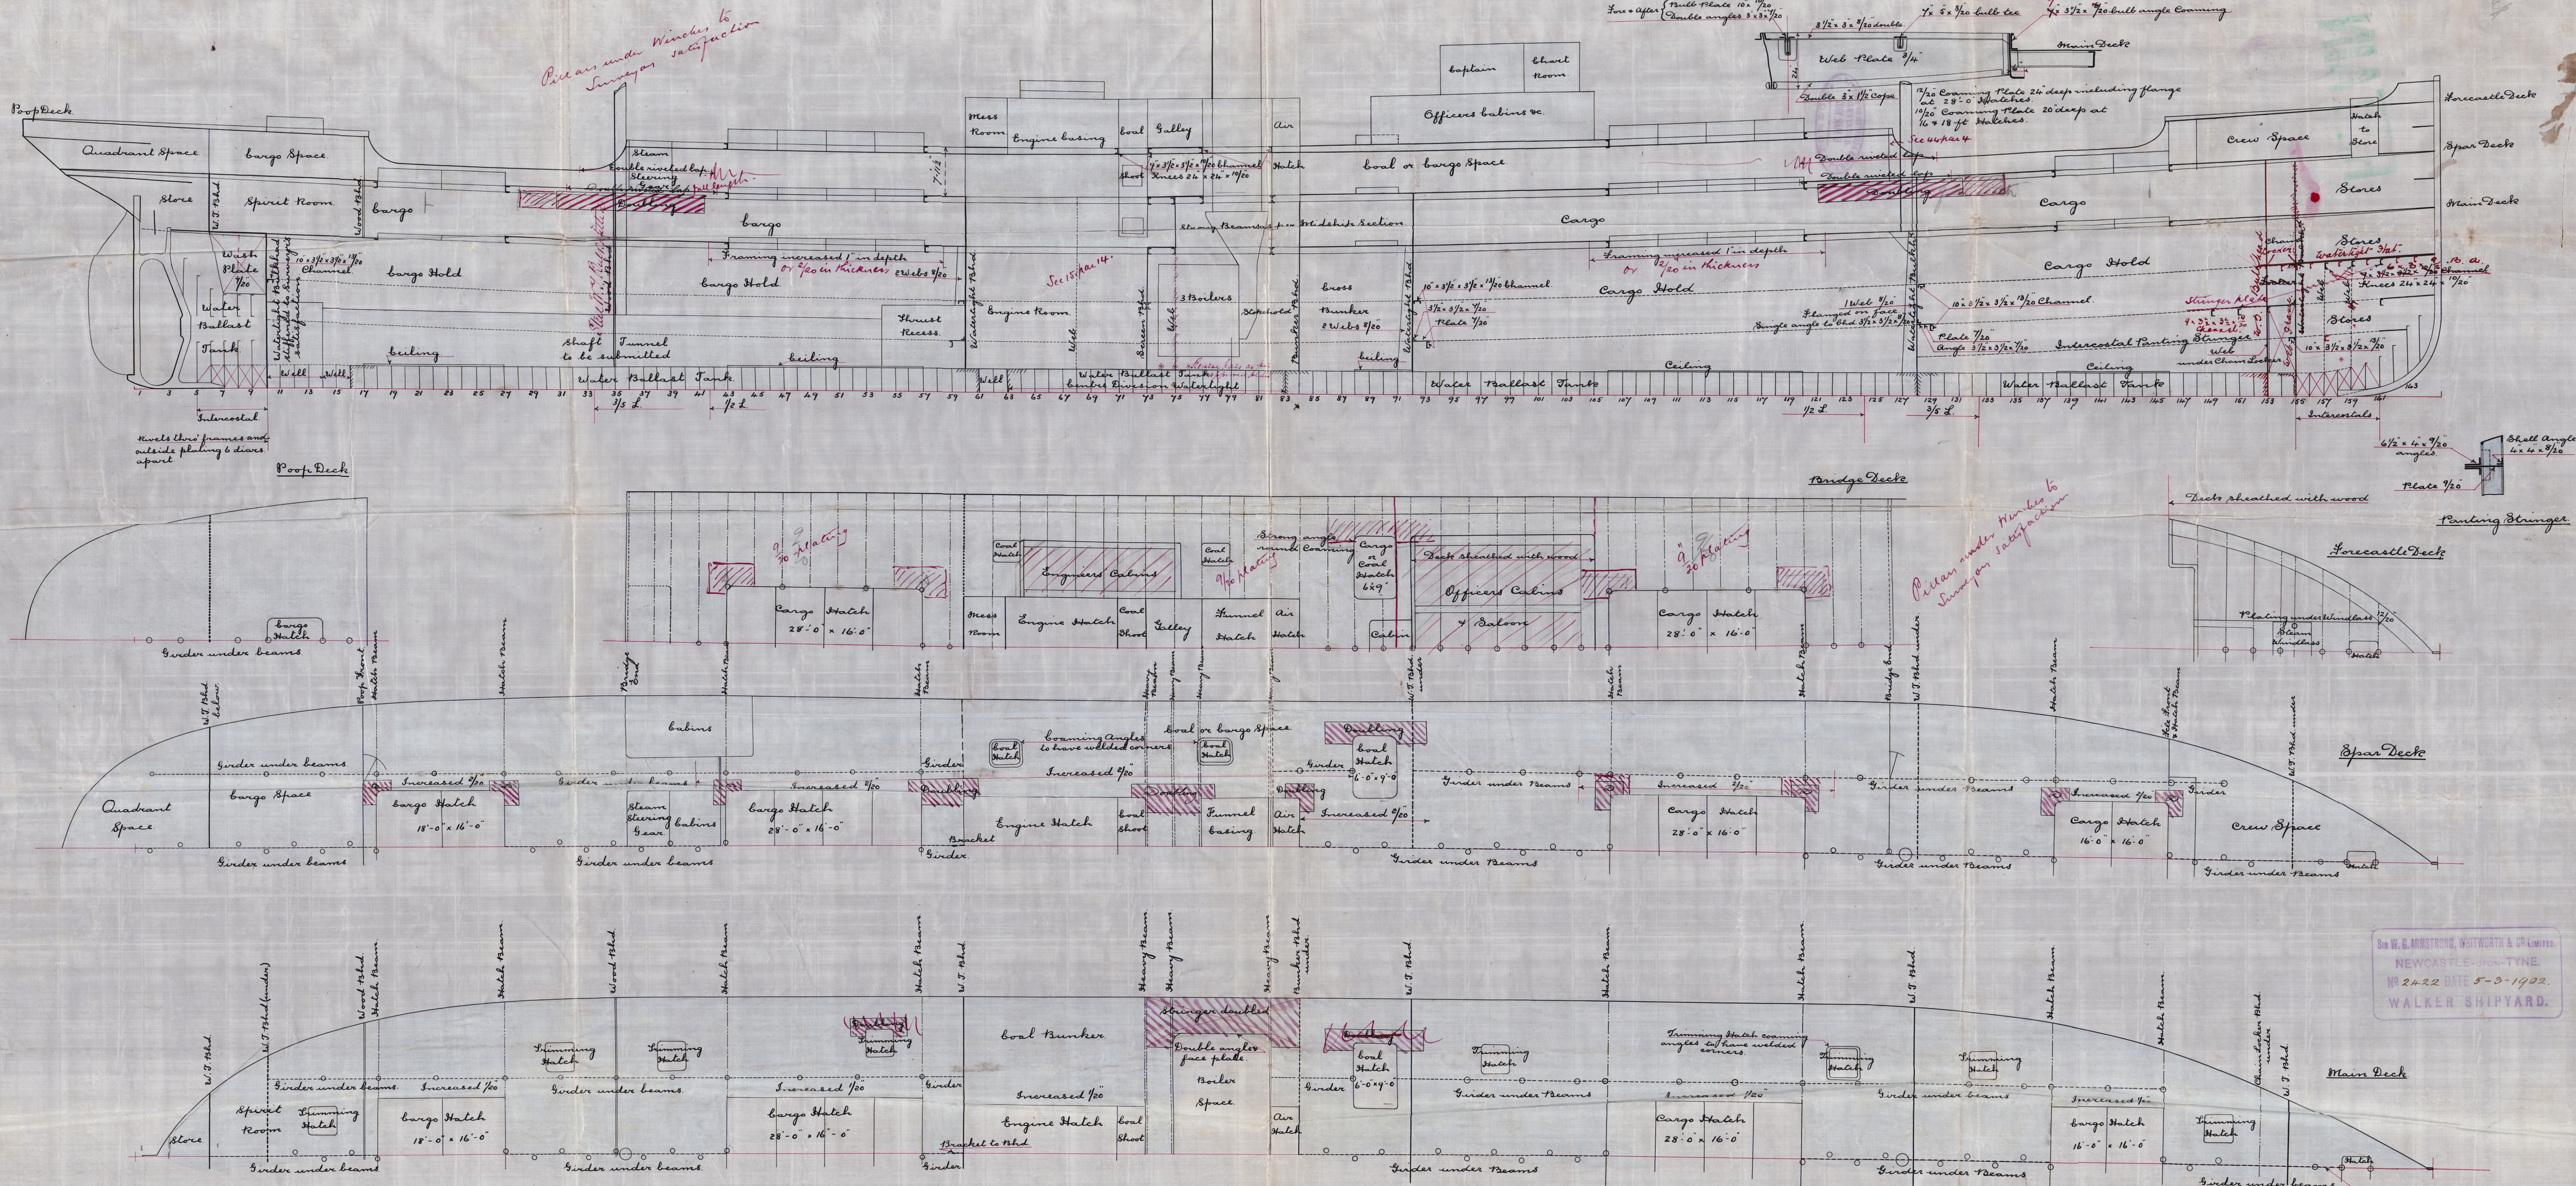

Cross Section thro. Hatchways.

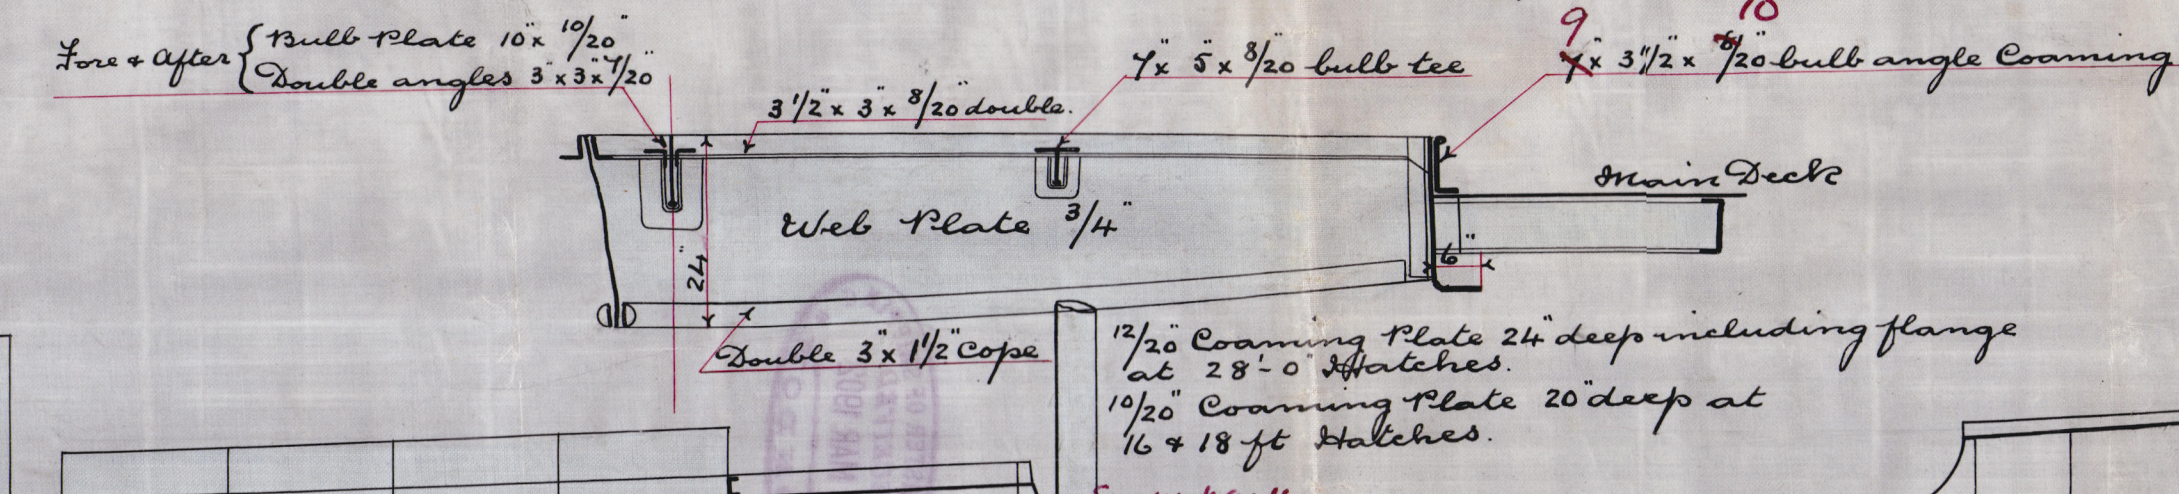

SIR W. G. ARMSTRONG, WHITWORTH & CO. LIMITED
NEWCASTLE-UPON-TYNE.
No 2422 DATE 5-3-1902.
WALKER SHIPYARD.

Grigua N^o 430

⁴⁴⁵⁻⁸⁴
S. S. Amatonga N^o 731
Swc. Fdbb Rpt No. 44, 631.

J. L. Amato
No. 731

192 Newcastle Report

Sp^o 44786

4V630-0066

© 2021
Lloyd's Register
Foundation