


NORTH EASTERN MARINE ENGINEERING CO. LTD.
DRAWING OFFICE
5 - MAY. 1902
WALSLEY
N° 6168

NOTE ALL PLATES STAYS TO BE OF STEEL EXCEPT OTHERWISE SHOWN
TENSILE STRENGTH OF SHELL PLATES TO BE NOT LESS
THAN 29 TONS PER SQUARE INCH

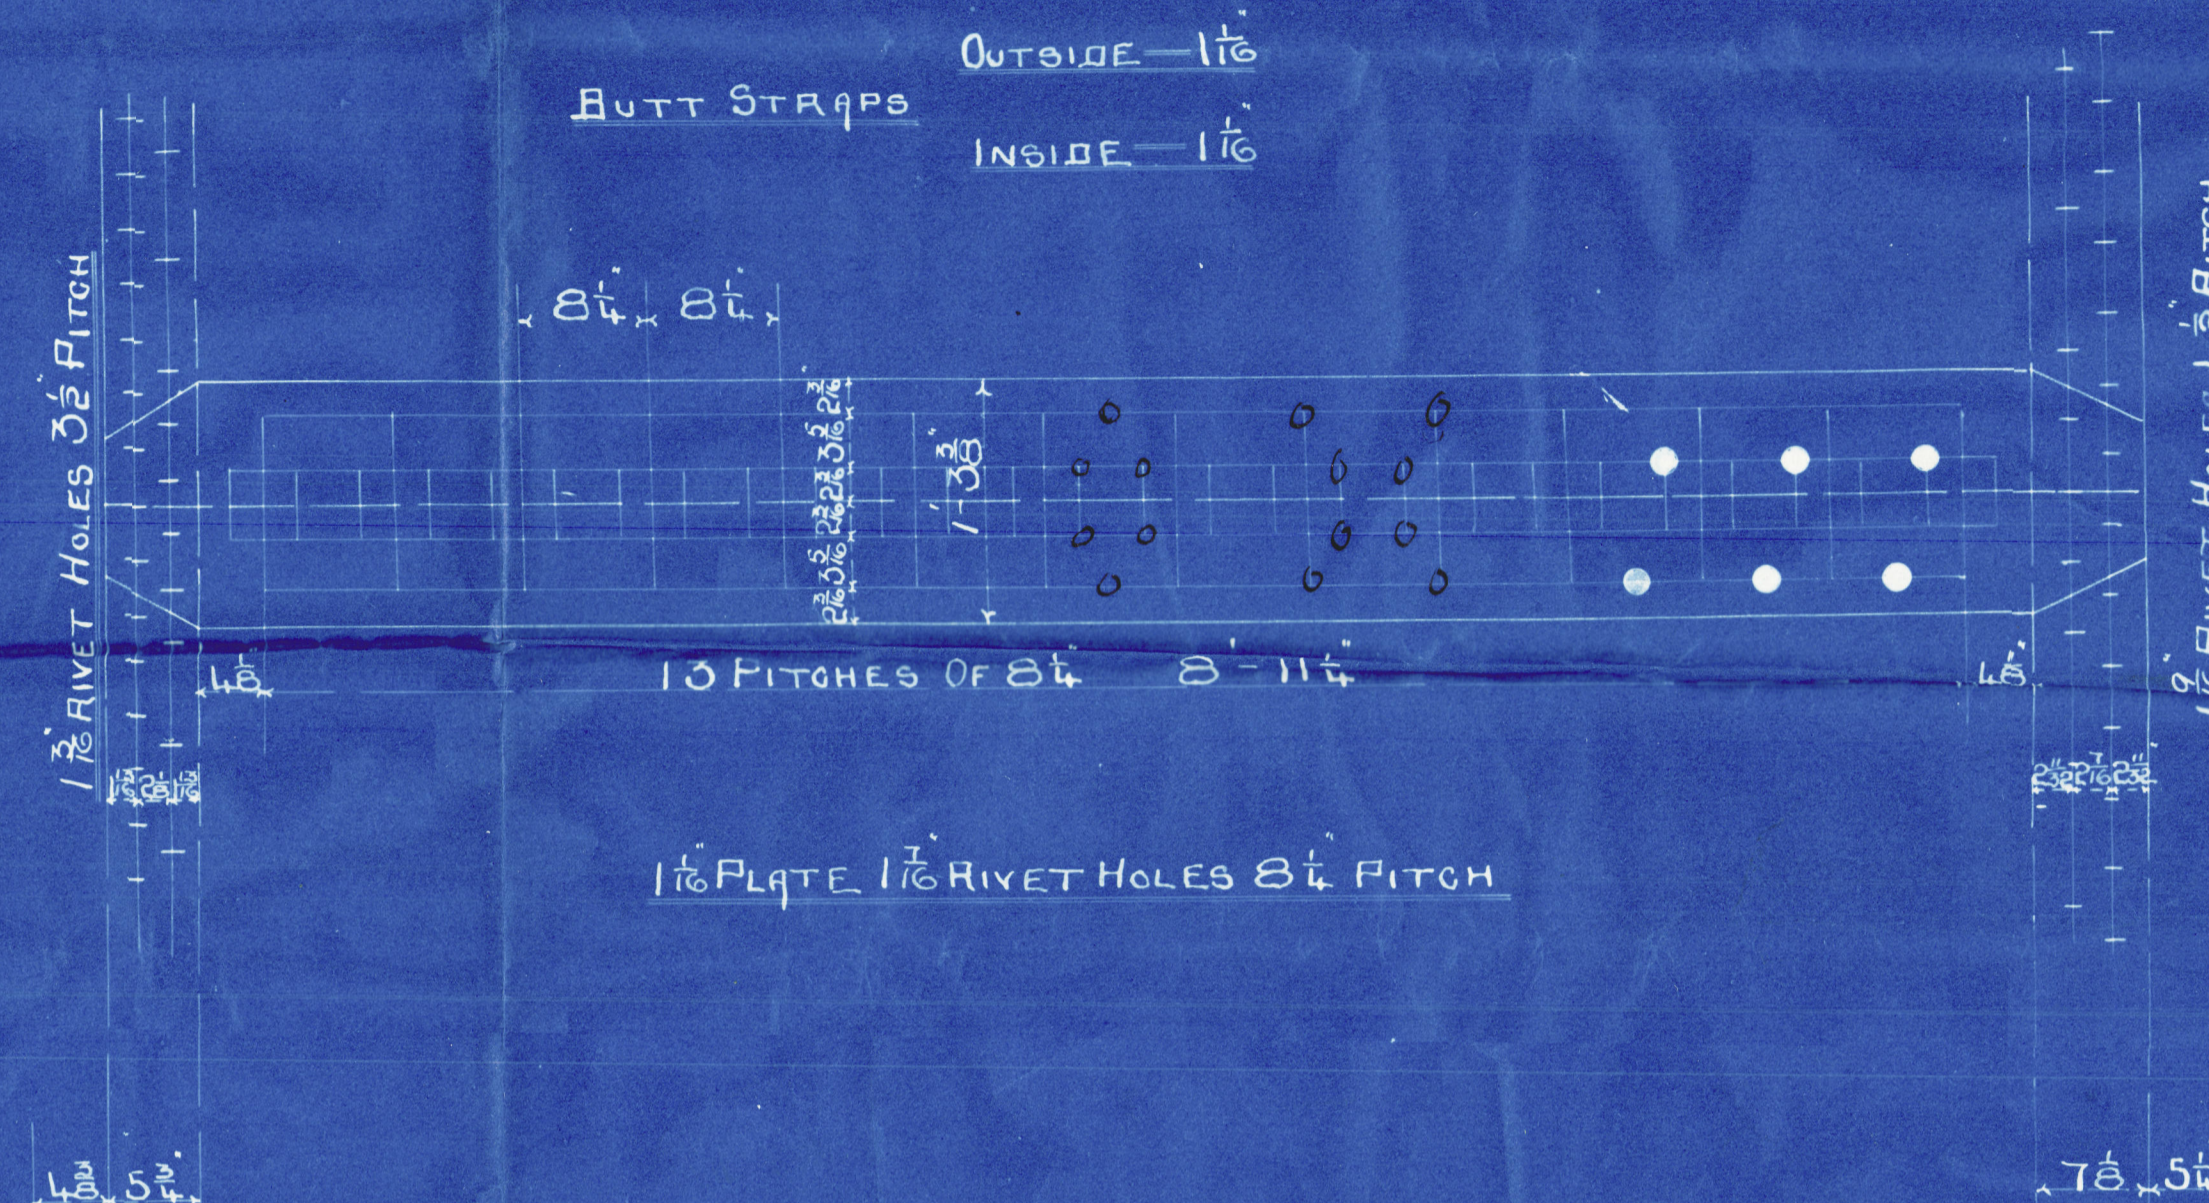

POSITION OF MANHOLES
VIEW LOOKING ON BACK OF BOILERS

IRON SCREWED STAYS THUS \bigcirc 24 Dia⁸ 6 THREADS
ALL OTHERS IRON \bigcirc 24 Dia⁹ 9 THREADS
NOTE ALL STAYS SCREWED AND FITTED WITH NUTS
FOR POSITION OF MGN HOLES
SEE SKETCH ABOVE.

2 THUS
1 OPPOSITE HAND

CONTRACT 1435-6

N.E. Marine Eng Co

C. Nos 1435, 1436

for

Armatiny Whithorn


S/s 730 & 731

35E

W.P. 180

No 6412
Lloyd's List
360 lbs
G.A.H. 3/10/02

No 6454
Lloyd's List
360 lbs
G.A.H.
1.12.02

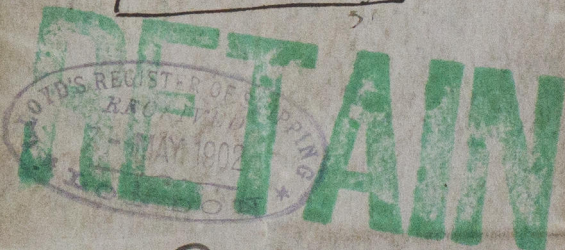

J.G. Armatonga

No 731

Newcastle Report

Lloyd's Register

No 44786

Foundation

W630-0066