


7.4.11

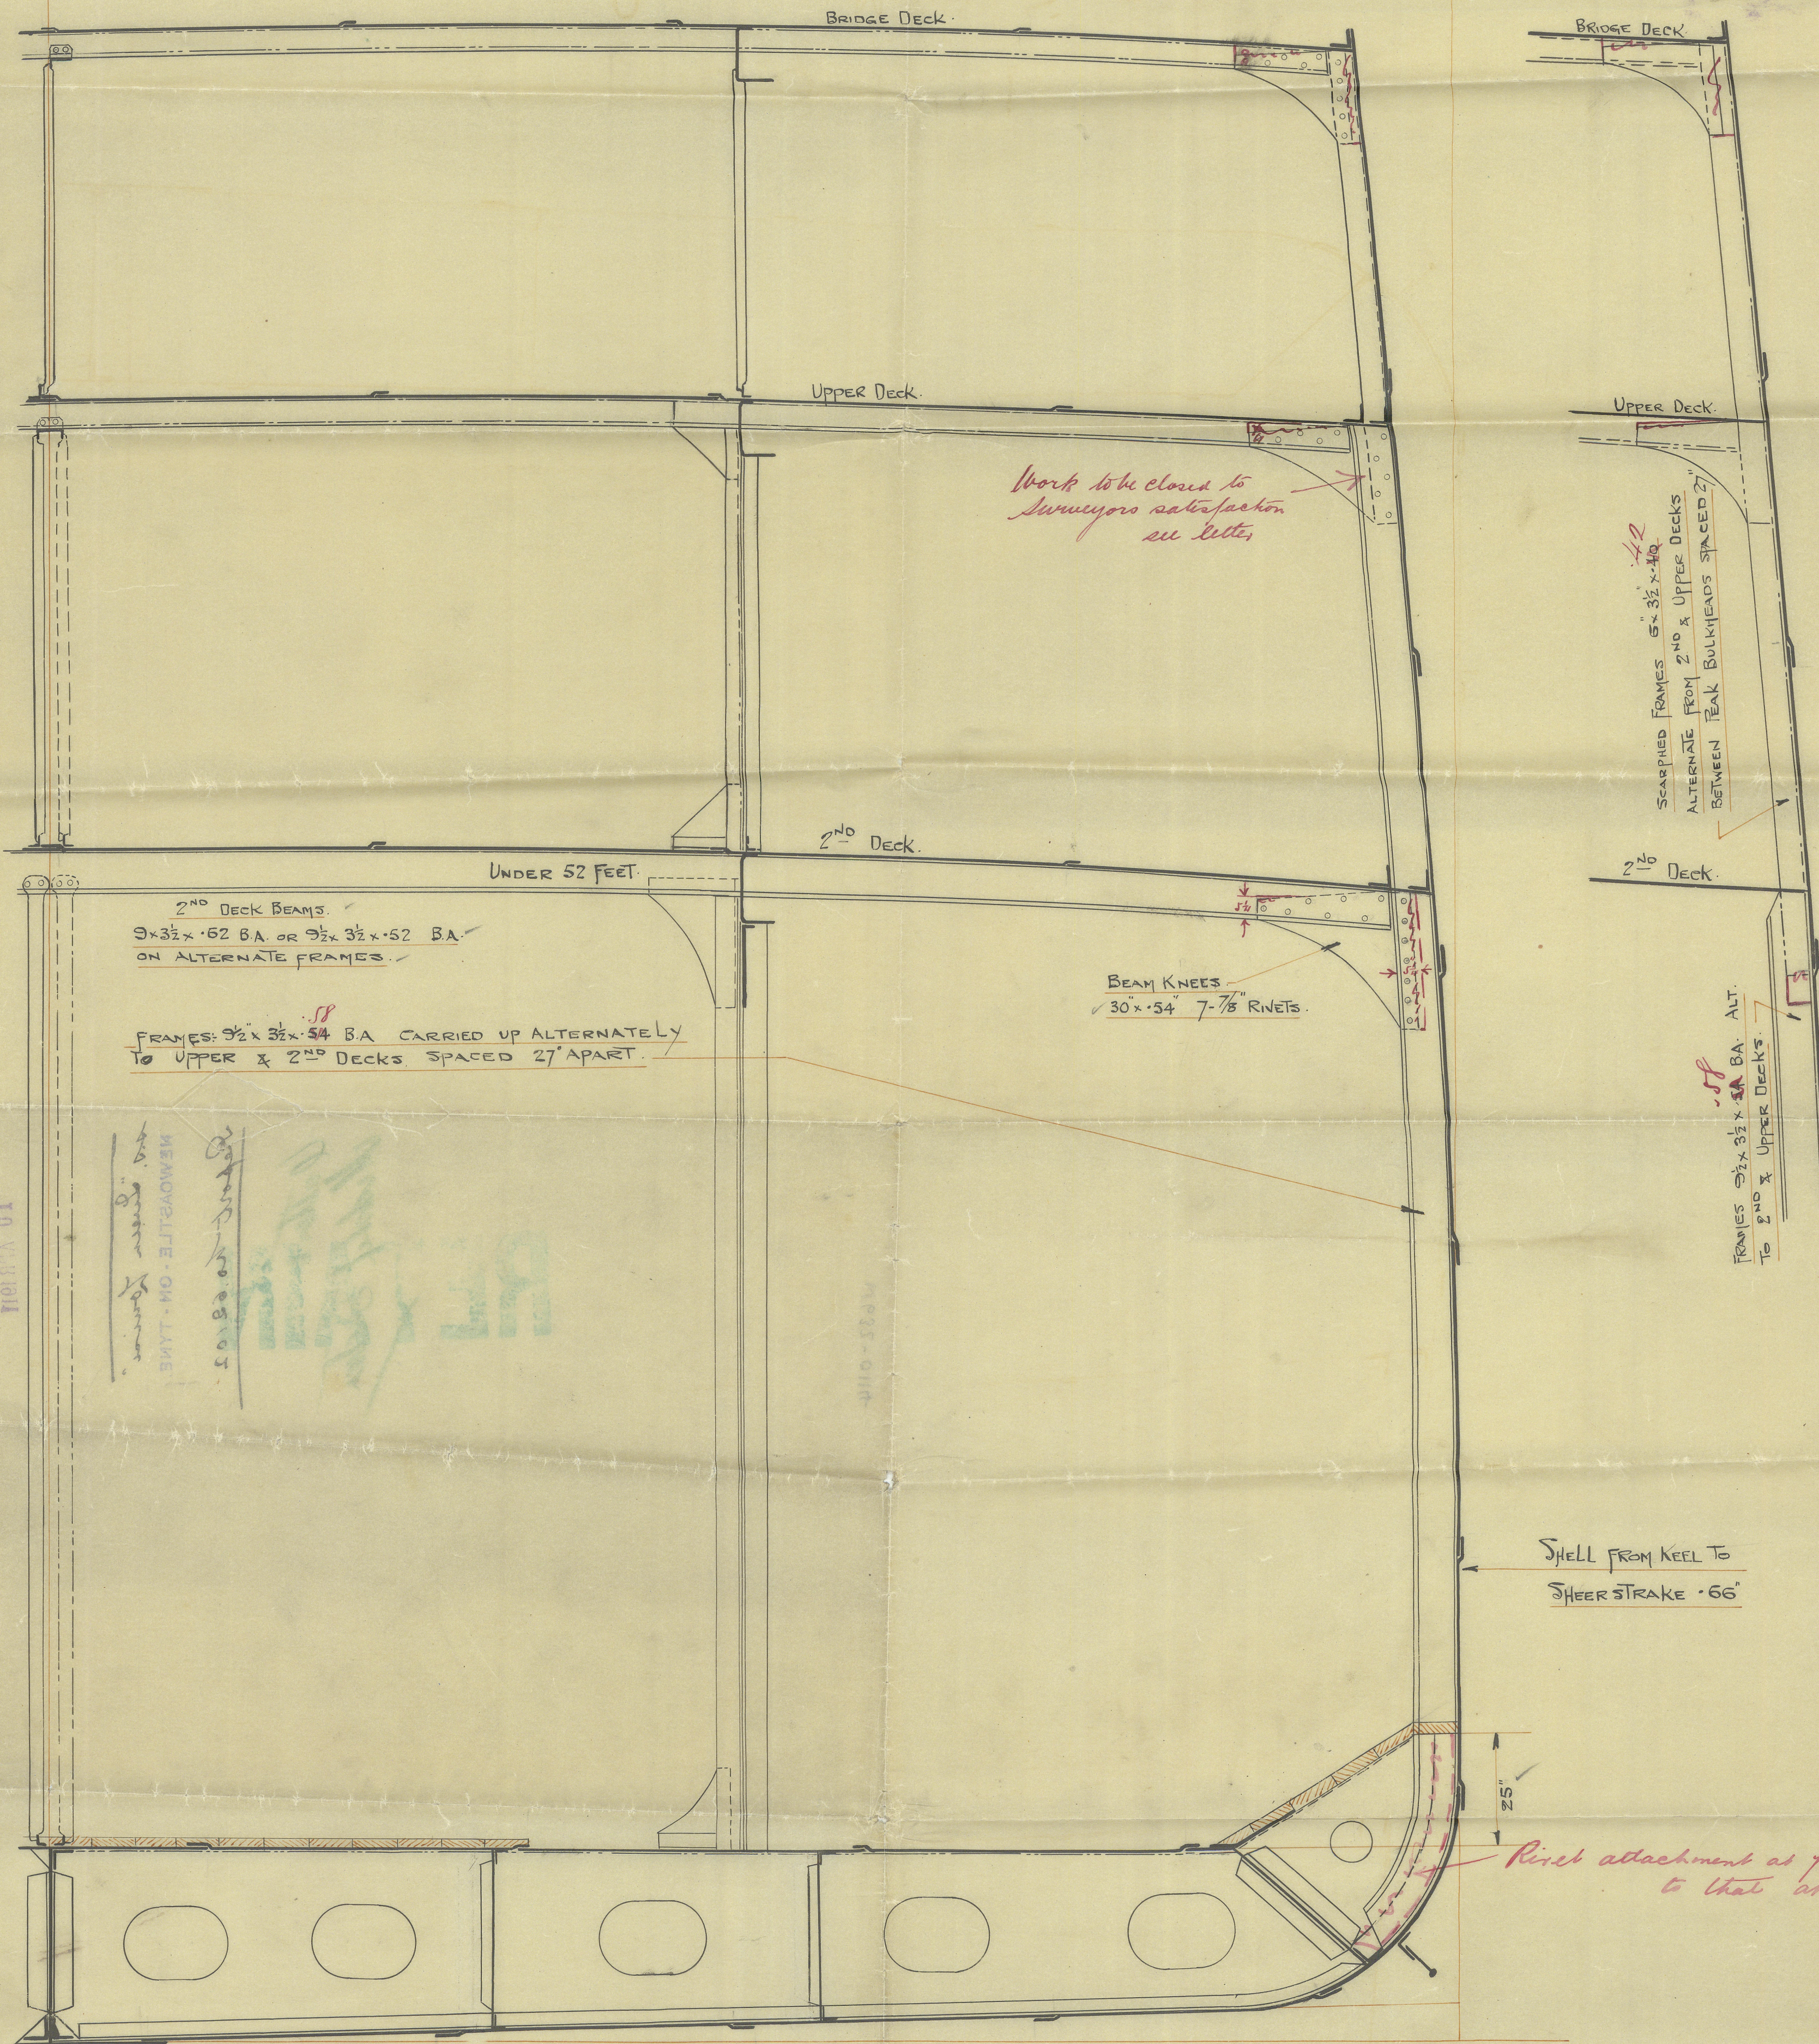


S. S. No 191-

— OUTLINE MIDSHIP SECTION —

— SCALE $\frac{1}{2}$ - 1 FOOT. —


C.F.
 7.4.11

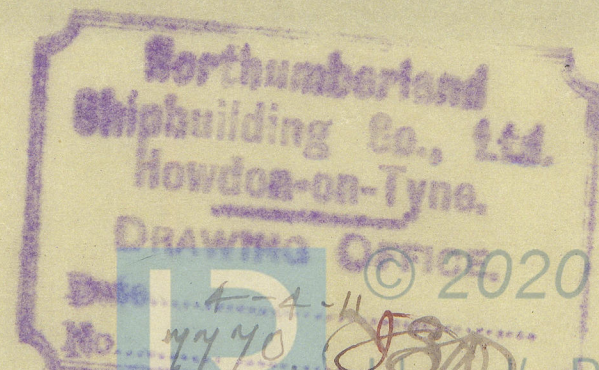

W632-0114

Lloyd's Register
 Foundation

191

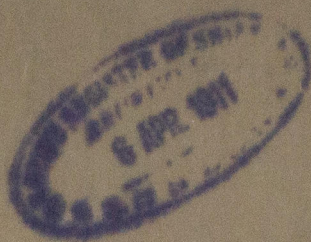


s.s. "Queen Louise"
NEWCASTLE - ON - TYNE

Report no. 62102

*Walter
Middleton*

© 2020

Lloyd's Register
Foundation

