
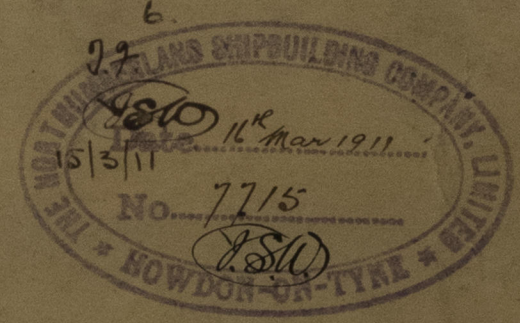


N^o 191 1208
PROFILE & DECK PLANS

LENGTH B.P. 404'-10" BREADTH M.L.D. 52'-9" DEPTH M.L.D. 29'-9"

SCALE 8" = 1 FOOT

23-3-11
31-3-11
11-4-11
26-5-11
1-6-11
15-6-11
6-9-11
8-9-11
14-9-11
7-11-11
20-11-11
(No. 308) 7-5-12
25-1-12

 

24 FEB. 1911
LONDON

LOYD'S REGISTER OF SHIPPING
RECEIVED
8 - SEP 1911
LONDON

LOYD'S REGISTER OF SHIPPING
RECEIVED
30 MAR 1911
LONDON

LOYD'S REGISTER OF SHIPPING
RECEIVED
26 OCT 1912
LONDON

LOYD'S REGISTER OF SHIPPING
RECEIVED
17 MAR 1911
LONDON

LOYD'S REGISTER OF SHIPPING
RECEIVED
18 MAY 1911
LONDON

LOYD'S REGISTER OF SHIPPING
RECEIVED
6 JUN 1911
LONDON

LOYD'S REGISTER OF SHIPPING
RECEIVED
12 MAR 1911
LONDON

8 APR 1911
W. J. D. D. D.

LOYD'S REGISTER OF SHIPPING
RECEIVED
4 - NOV 1911
LONDON

LOYD'S REGISTER OF SHIPPING
RECEIVED
19 MAY 1911
LONDON

LOYD'S REGISTER OF SHIPPING
RECEIVED
15 APR 1911
LONDON

LOYD'S REGISTER OF SHIPPING
RECEIVED
6 - OCT 1915
LONDON

LOYD'S REGISTER OF SHIPPING
RECEIVED
17 APR 1912
LONDON

LOYD'S REGISTER OF SHIPPING
RECEIVED
12 SEP 1911
LONDON

LOYD'S REGISTER OF SHIPPING
RECEIVED
25 NOV 1912
LONDON

LOYD'S REGISTER OF SHIPPING
RECEIVED
6 APR 1912
LONDON

LOYD'S REGISTER OF SHIPPING
RECEIVED
12 SEP 1911
LONDON

LOYD'S REGISTER OF SHIPPING
RECEIVED
20 APR 1912
LONDON

LOYD'S REGISTER OF SHIPPING
RECEIVED
11 NOV 1910
LONDON


S. S. FRIMLEY
NEWCASTLE

LOYD'S REGISTER OF SHIPPING
RECEIVED
11 NOV 1910
LONDON

9100-229M



Lloyd's Register
Foundation

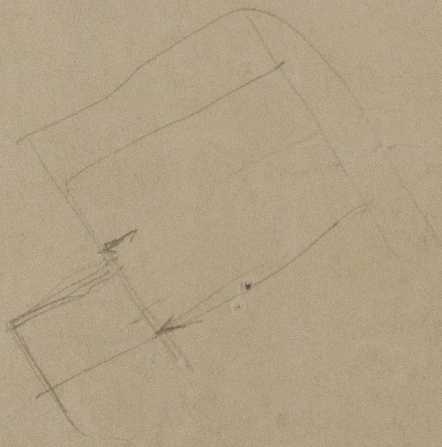

- STRING

WITHIN

BUTT




© 2020

Lloyd's Register
Foundation

HA

x.48

BUTT

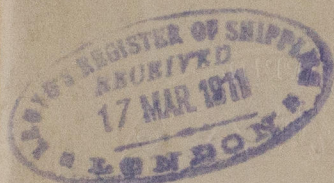

W632-0116



© 2020

Lloyd's Register
Foundation