




19.8.16

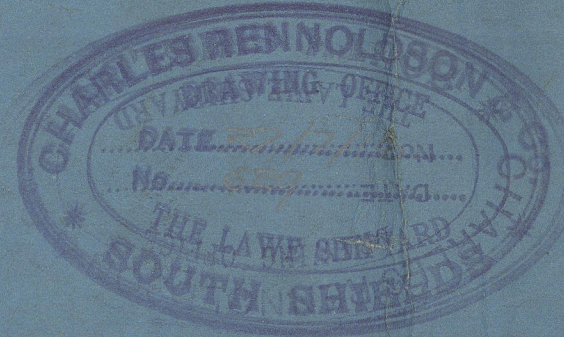

PROFILE & DECK PLANS
 LENGTH B.P. 265'-0" BREADTH MLD 36'-6" DEPTH MLD 18'-4"
 CLASS 100 A.I. LLOYS.
 SCALE 1/8" = 1 FOOT

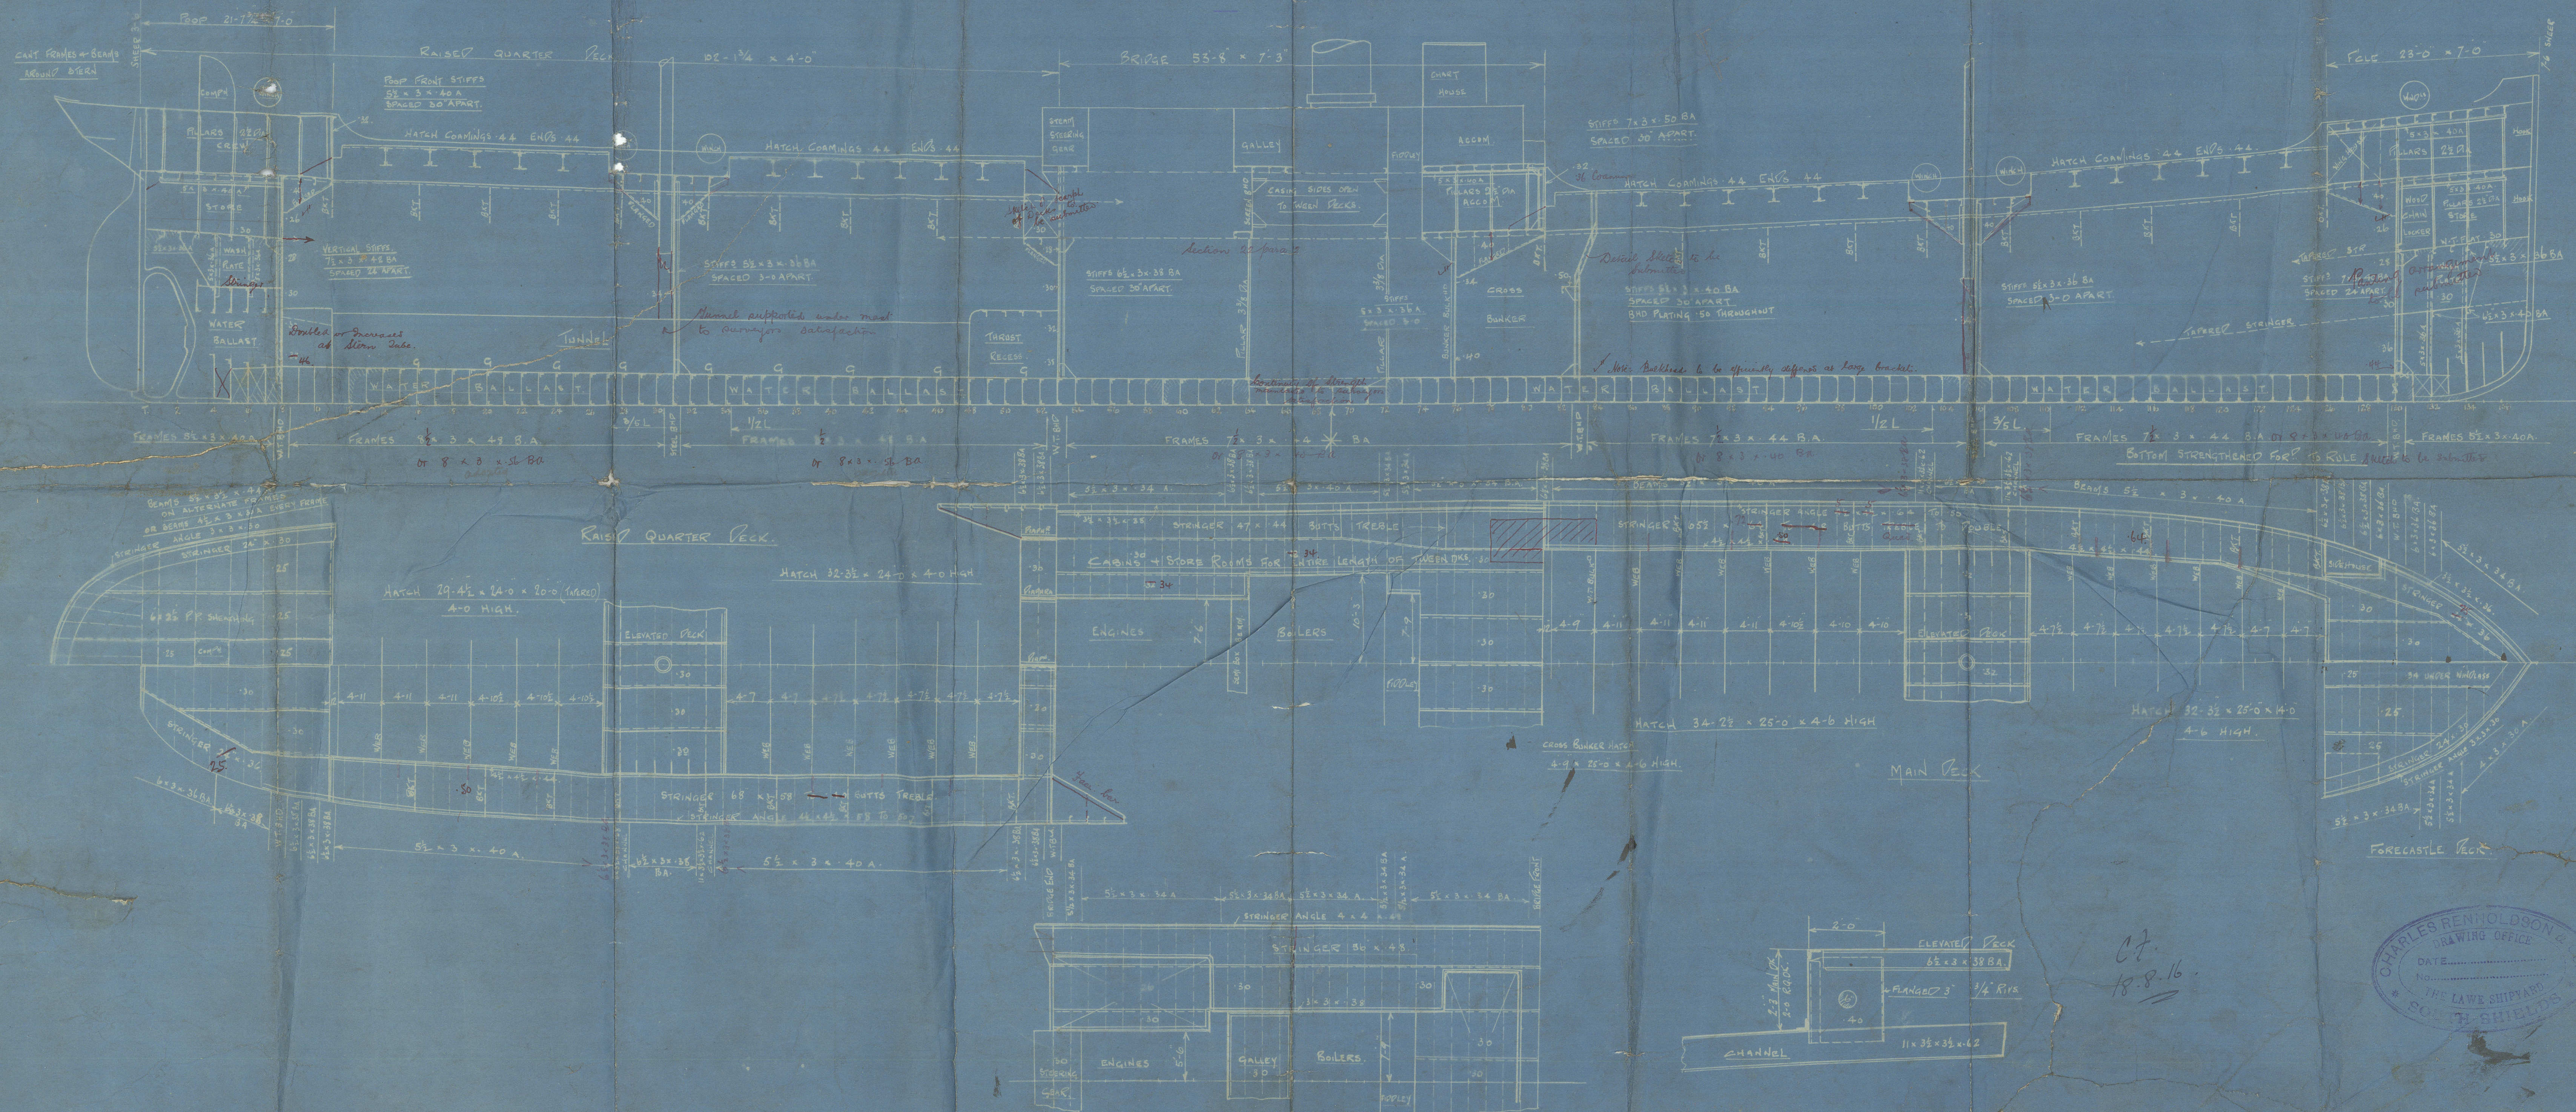

CT.
 18.8.16

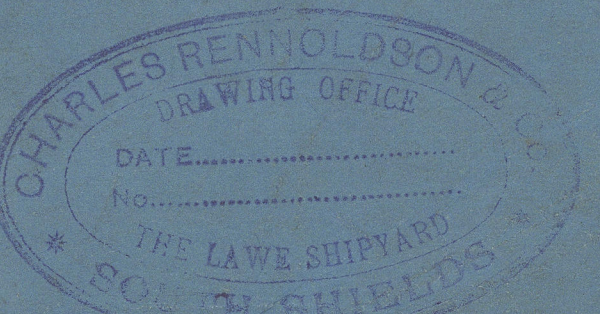

Profile + D.R.


S/S. Thibe

Nov. 71831.

Sellings

RETAIN

ap/rous Edm

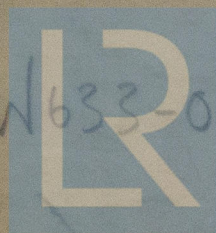

© 2020

W633-0204

Lloyd's Register
Foundation

Approved Profine



182



© 2020

Lloyd's Register
Foundation