


LONGITUDINAL SECTION.


MINIMUM SCANTLINGS REQUIRED

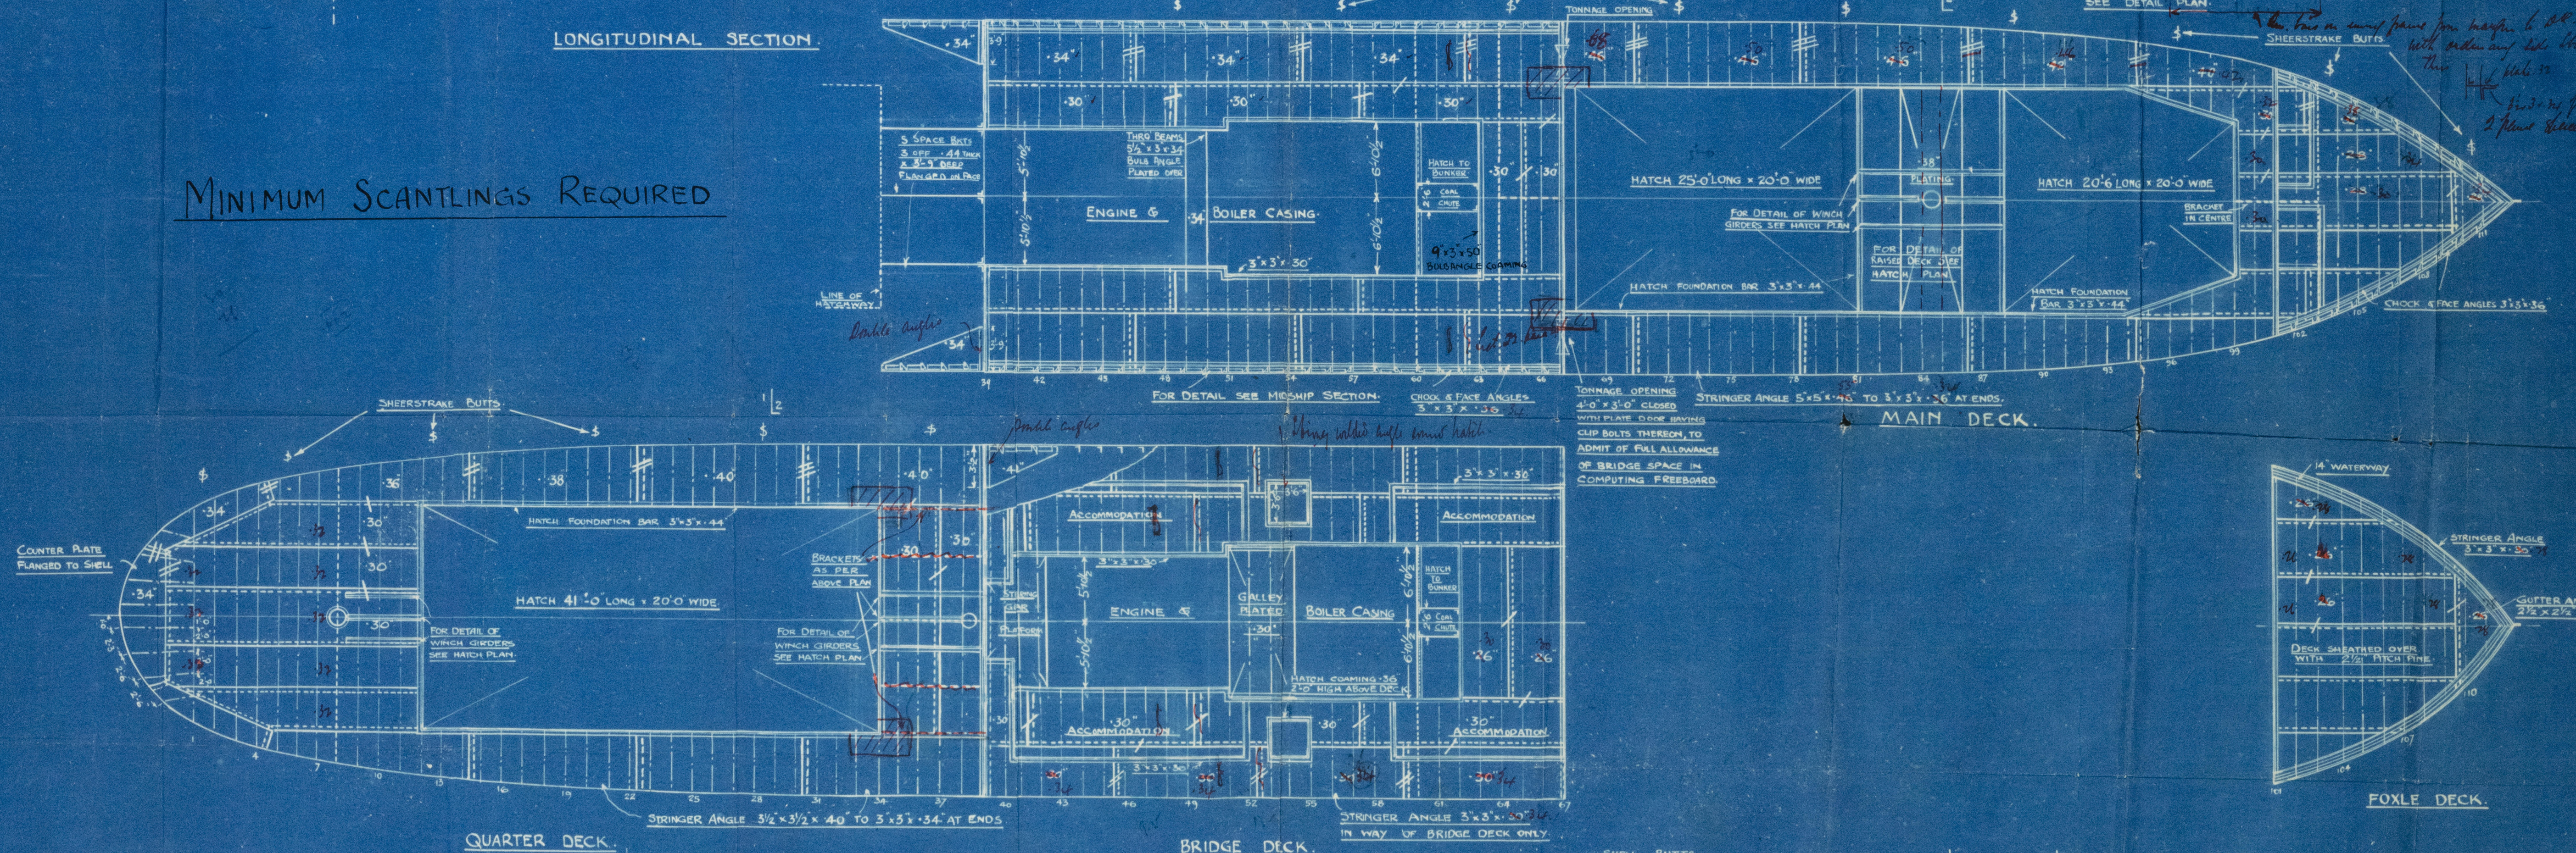

QUARTER DECK.

BRIDGE DECK.

FOXLE DECK.

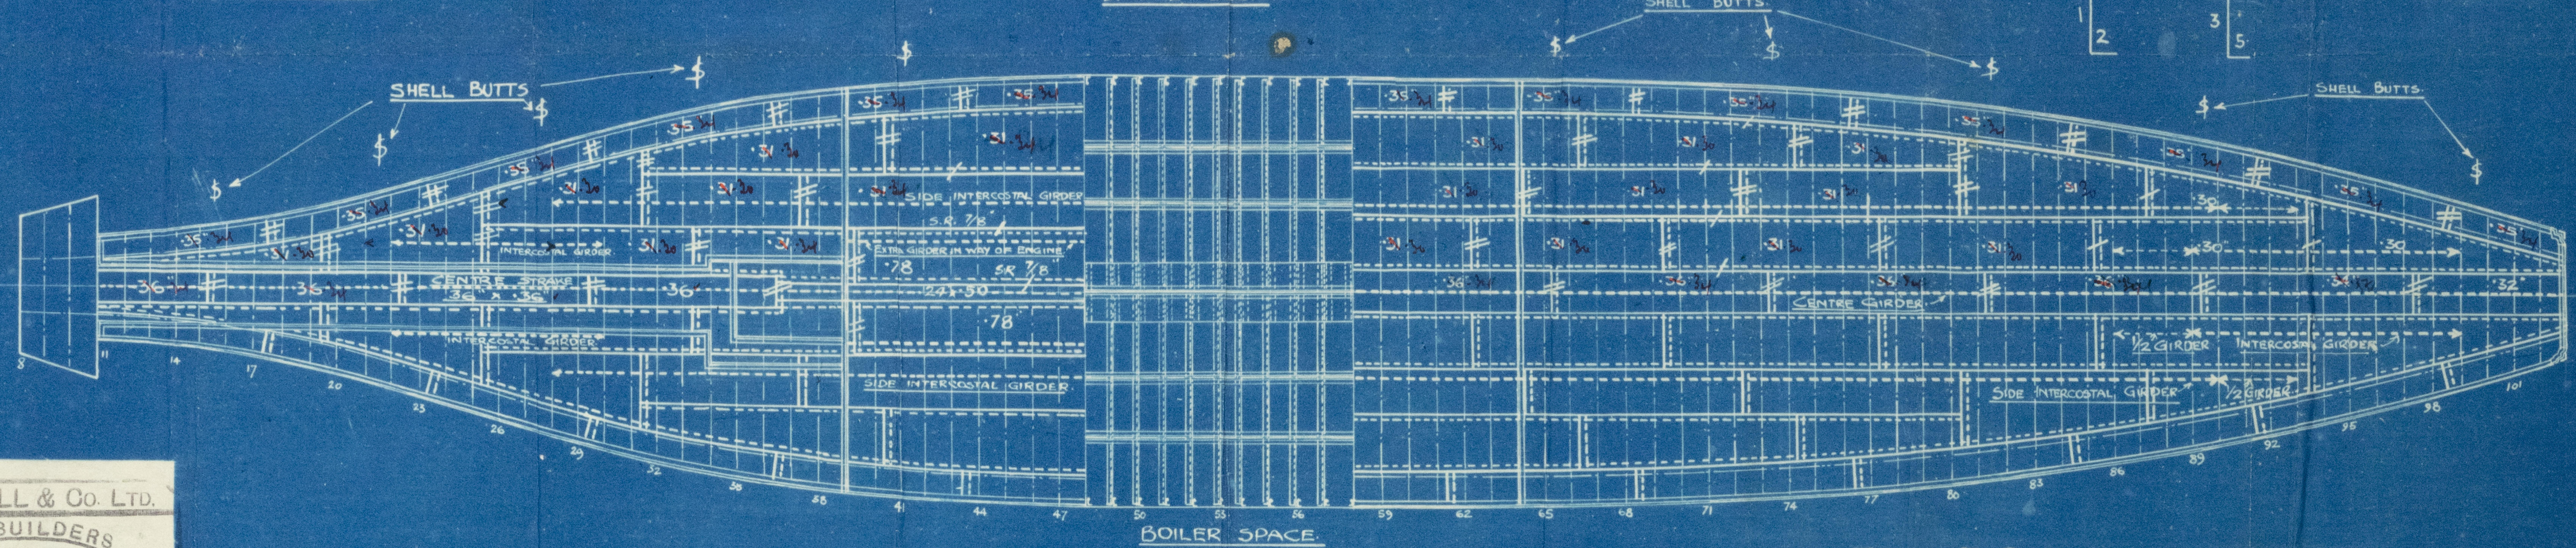


TANK TOP PLAN.

ALEX^S HALL & CO. LTD.
SHIPBUILDERS
DEC. 1923
4063
ENGINEERS & BOILERMAKERS
ABERDEEN

SHIP NO 591

SCALE:- $\frac{1}{8}$ " ONE FOOT

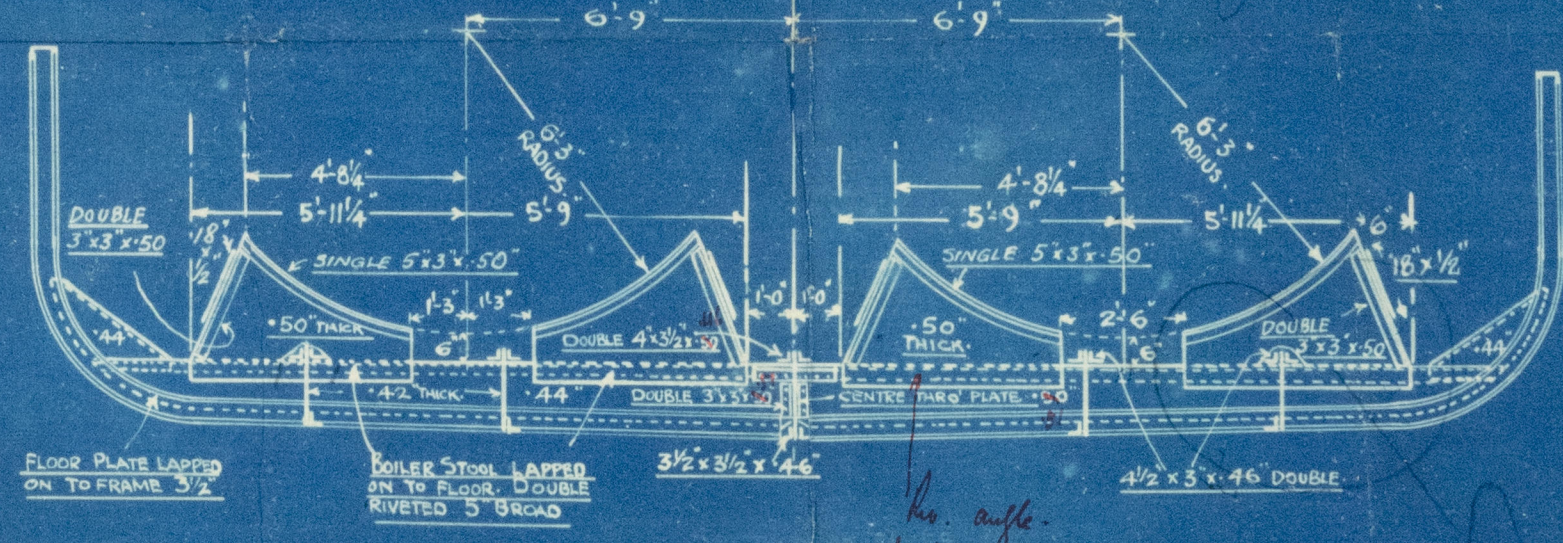

SECTION AT FRAME 55
LOOKING AFT.
SCALE $\frac{1}{4}$ " ONE FOOT.

APPROVED
LLOYD'S REGISTER OF SHIPS
Montgomery
26.12.23

PROFILE, BEAM, TANK TOP, ENGINE & BOILER SEATING PLANS.

Nº 591.

A. HALL + COY LD.

OFFICE. DECKS. TANK TOP.

S. "GLEN DERRY"

BN. REPORT. 13580.

RECEIVED



© 2020

Lloyd's Register
Foundation

W637-0042