

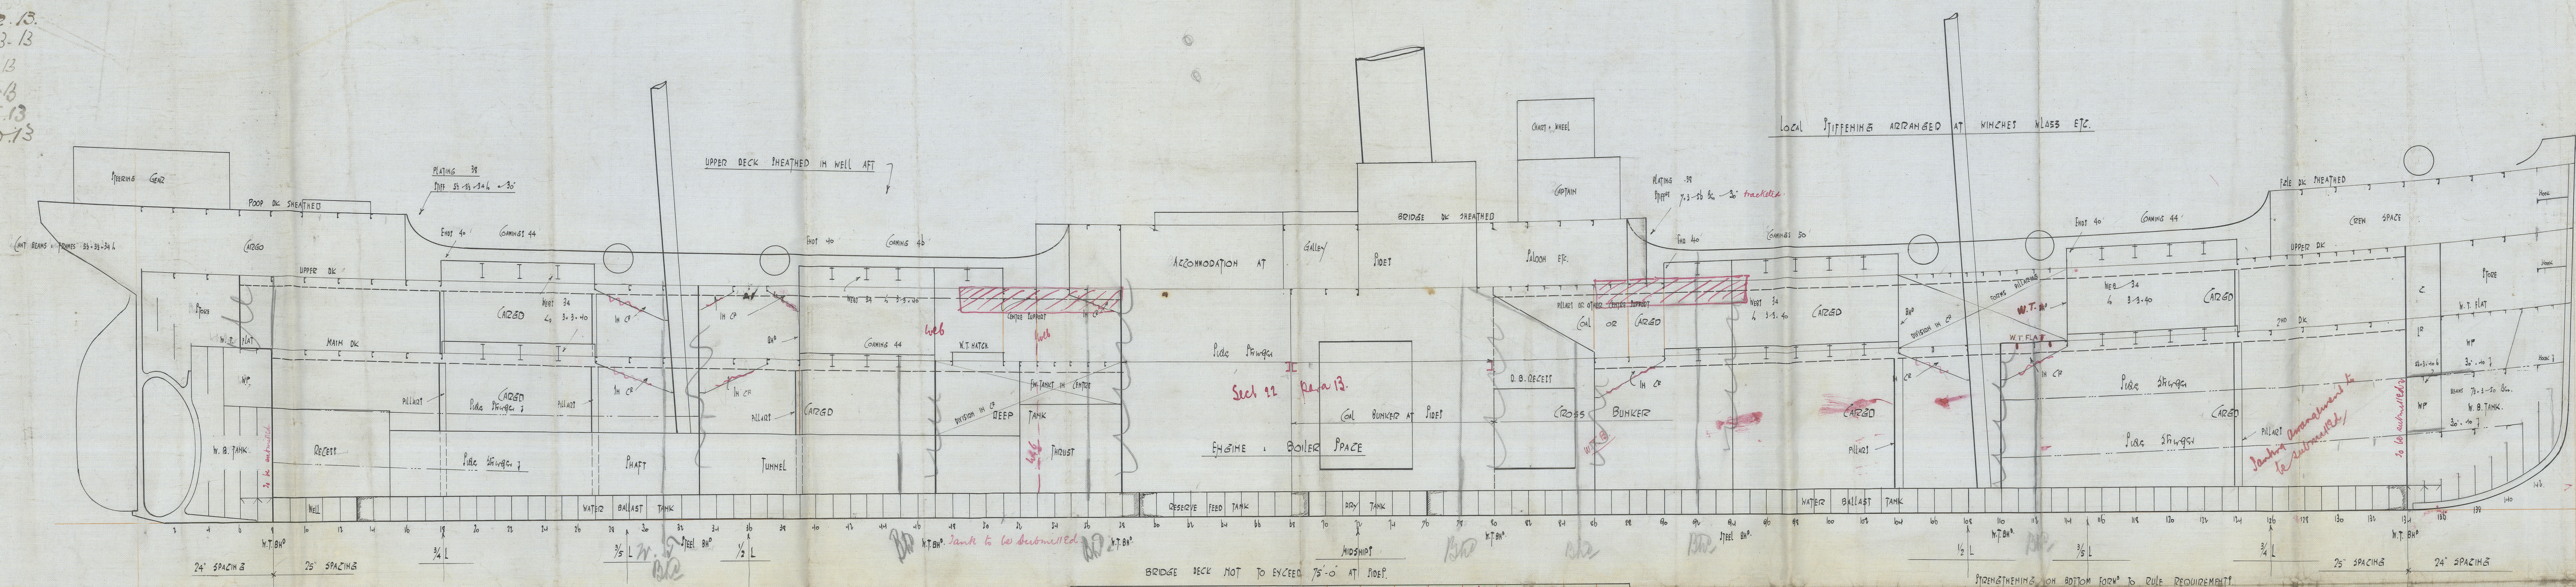
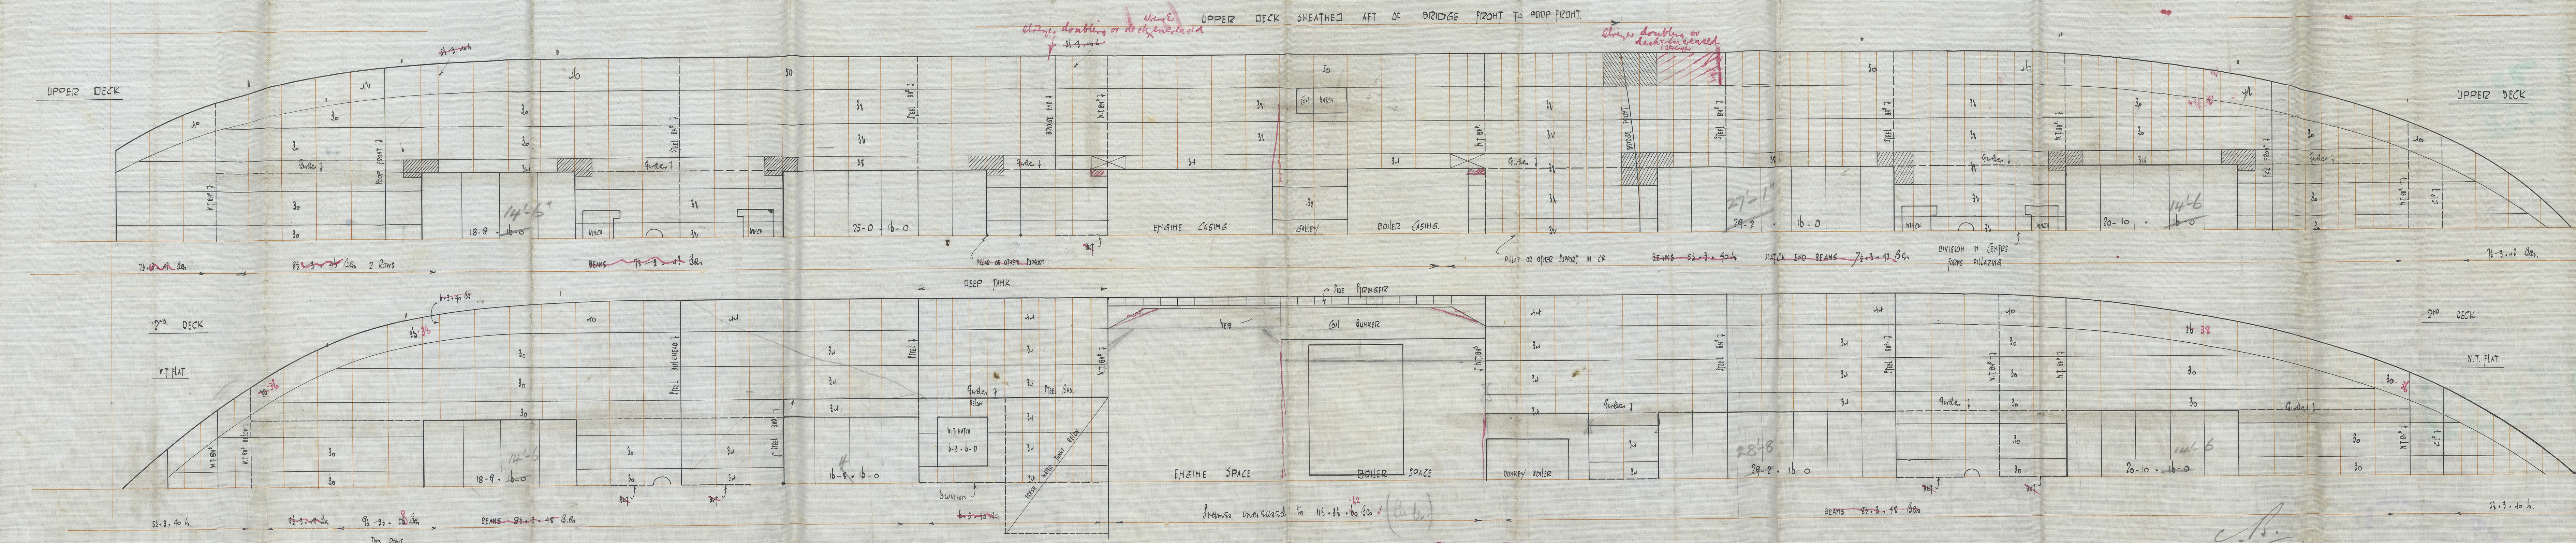


10.2.13.
17.3.13
1.4.13
21.4.13
29.5.13
28.10.13

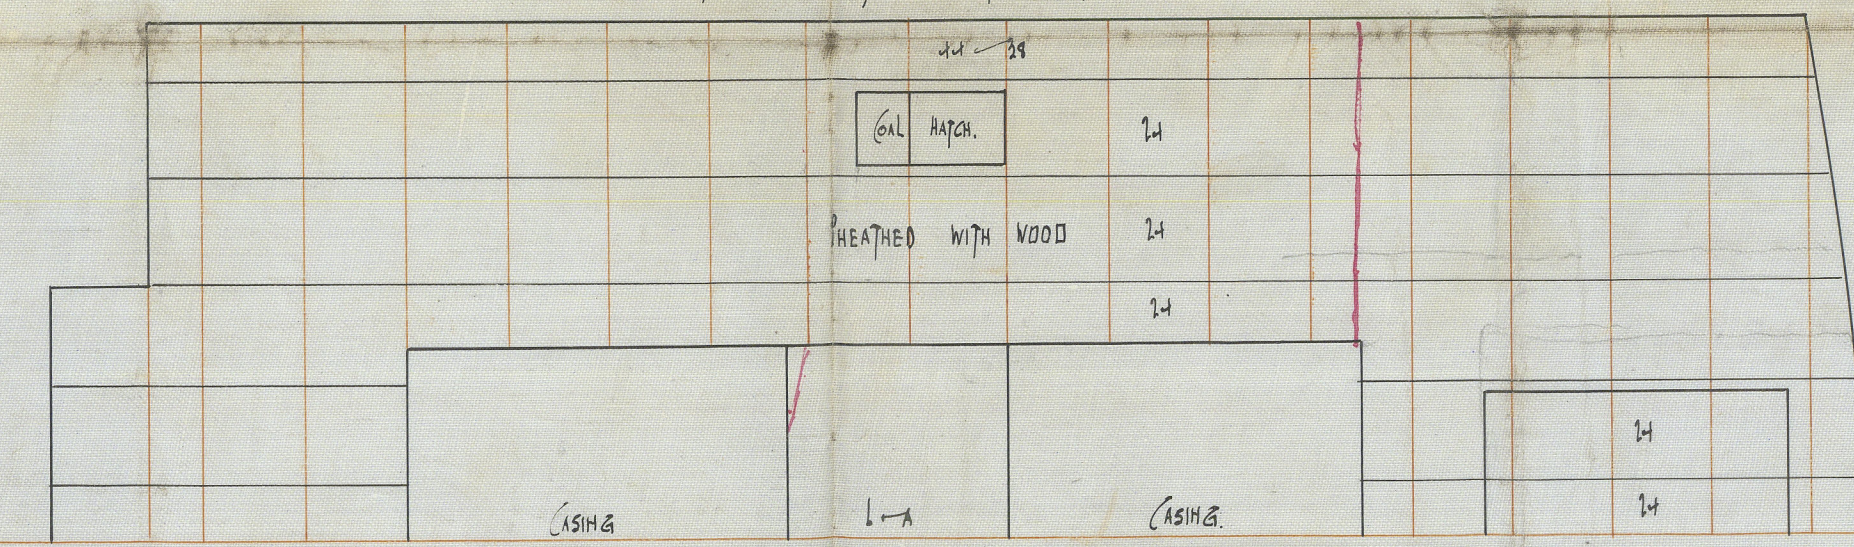

No 586 S S
PROFILE & DECK PLANS
300' 45" 28'

1/8" = 1'
TO CLASS 100 AT LLOYD'S.

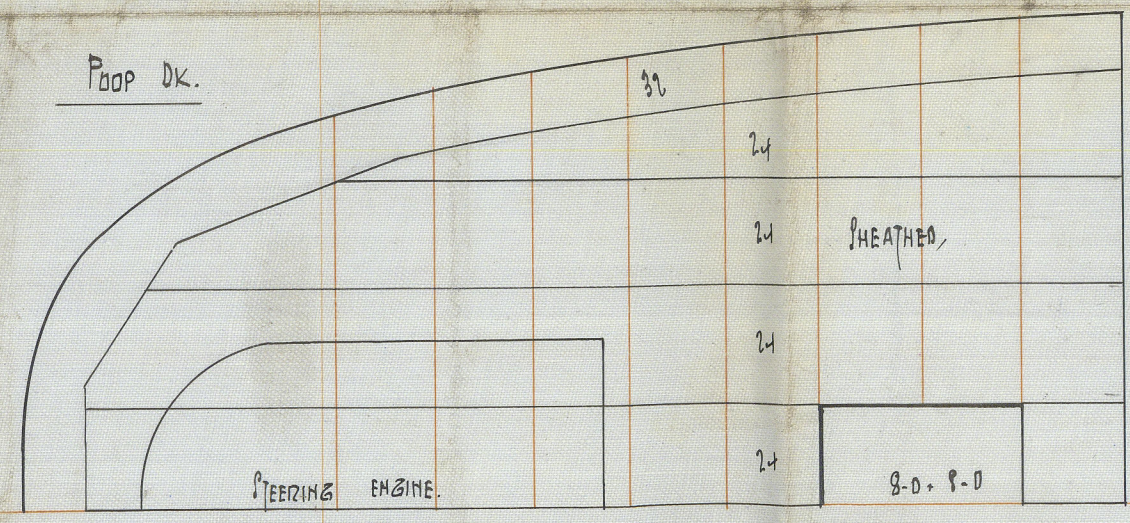


See midship section for Beams. 2 Row.

W638-0221

Sir R. Dixon & Co.
S.S. No. 586
Profile & Deck Plan

S. Michael
MIDDLESBRO' 8532

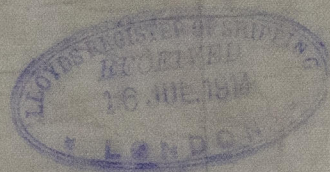

RECEIVED



© 2021

Lloyd's Register
Foundation

W638-0221