


78.3.01

S.S. Nos 415 & 416.  
 Steel Single Screw Spar Deck Steamers.  
 Altered Plan to suit Amended Arrangement of Ship.

Principal Dimensions.  
 Length overall 310' 0"  
 Length B.P. 300' 0"  
 Breadth extreme 43' 9"  
 Depth moulded to Main Bk. 19' 0"  
 Scale 1/8" = 1 Foot.  
 Pillars below Beams shown.

Steel Centre Bulkhead fitted in Holds where shown. Plating 1/32", connected to deck by double 5 x 3 x 3/20 angles, & to Tank Top by double 5 x 3 x 3/20 angles. Vertical stiffeners double 5 x 3 x 3/20 angles, spaced 4 feet apart.

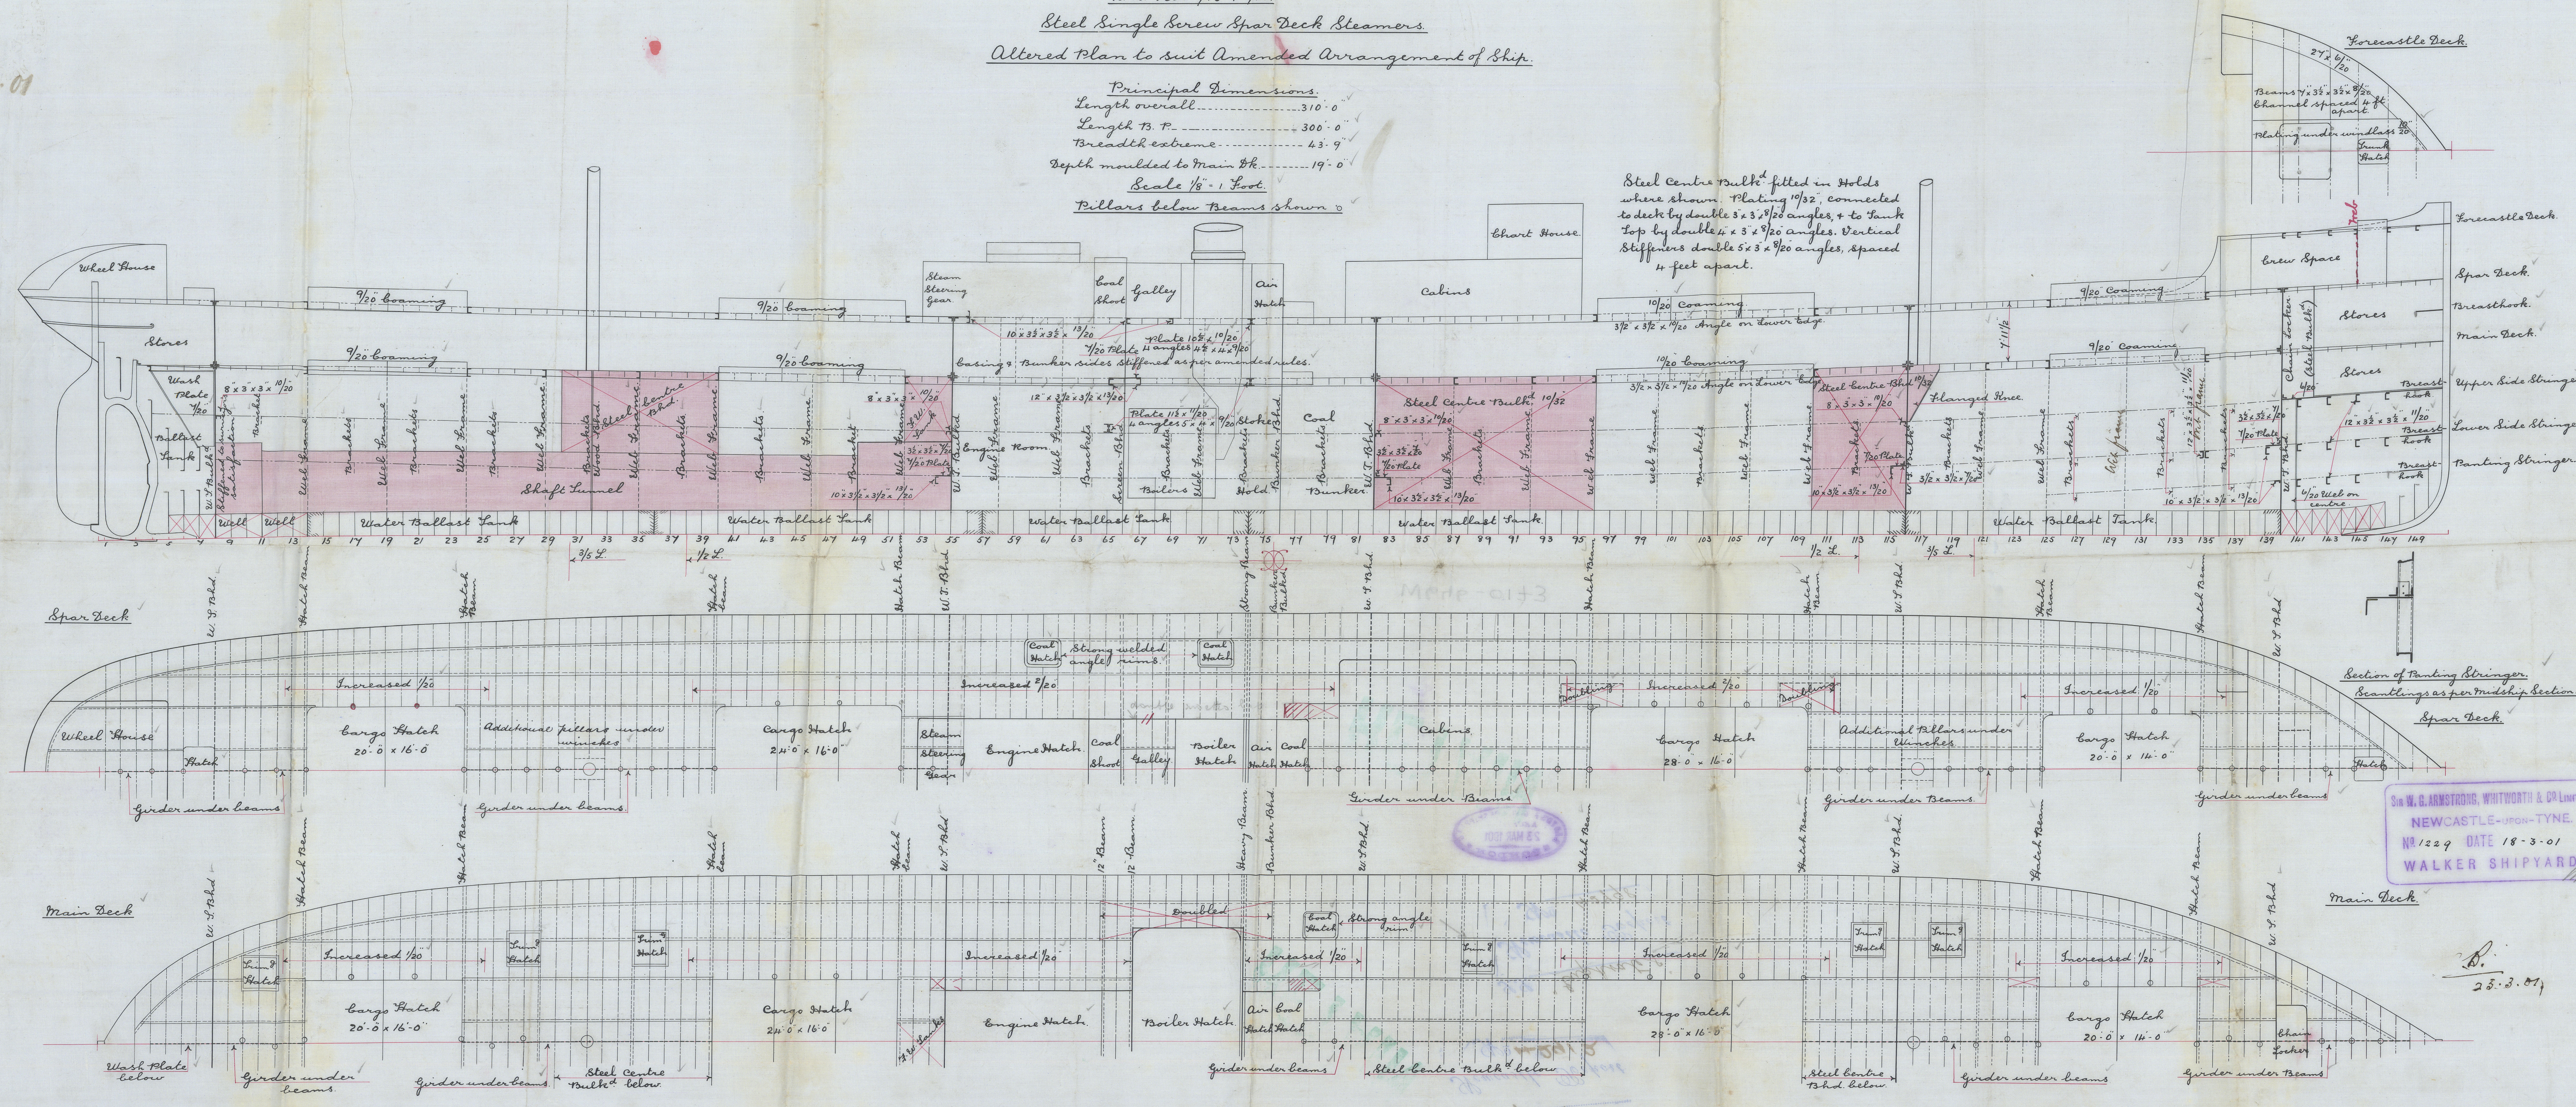

Sir W. G. ARMSTRONG, WHITWORTH & CO. LTD.  
 NEWCASTLE-UPON-TYNE.  
 No 1229 DATE 18-3-01  
 WALKER SHIPYARD

D.  
 28.3.01



~ Near Armstrong Whitworths  
SS 71546

Profile S.S. Euphrates 715.

S.S. Signis 716.



Newcastle Report

42912

S.S. "Euphrates"

Newcastle Report

42498

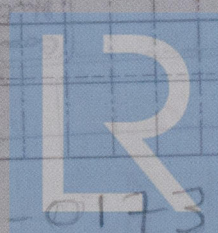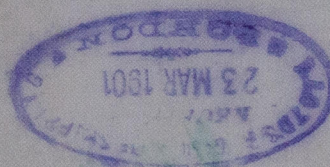

© 2021

Lloyd's Register  
Foundation

W646 0173