

STEEL BOILER 11-0 DIA 10-6 LONG

180 LBS W.P. LLOYDS


Nº 5051 - 2

RILEY BROS. (BOILERMAKERS) LTD.
STOCKTON ON TEES.

Shell Plate 9'-9" Wide

Buttstraps $\frac{7}{8}$ " thick
Tensile 28-32 tons.

Manhole Ring 7" x 1"

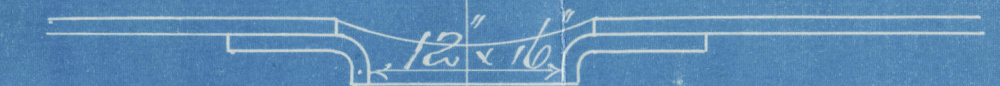

Heating Surface. 1130 Sq. ft.
Grote Area. 32 Sq. ft.
Firebars in one length. 5'0"

961
Messrs Riley Bros Lim^d.

Boilers 5051

5052

for

Messrs Dundee S. B. Co^s

S.S. No. 289

Working Press 180 lbs

2 Main Boilers

No.	5790
LLOYD'S TEST	
360	
9.8.17 - W.M.	

Indl rht No. 9852

RETAIN

Duplicate of No. 4968



© 2020

Lloyd's Register
Foundation
W654-0053