


# Nº 146 MIDSHIP SECTION

HALF SECTION IN WAY OF BRIDGE

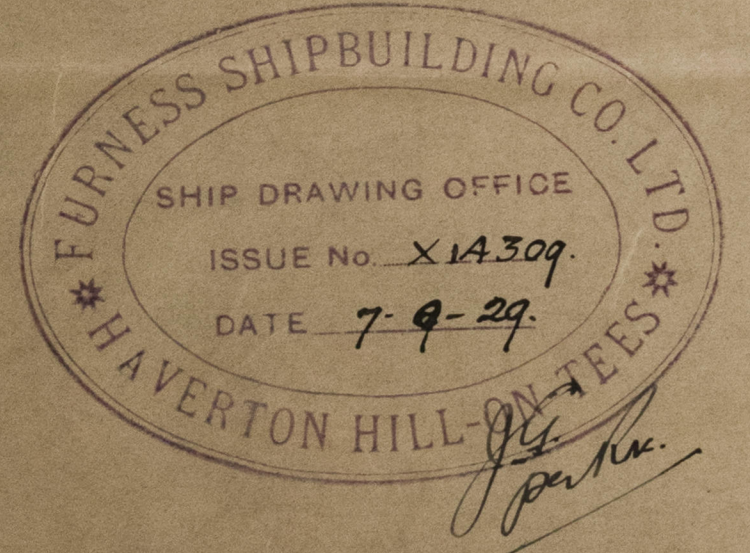

Furness S.B. Co's  
Nº 146.

Midship Section (as built)

S.S. Quoebridge  
MDB. RPT. No. 15808

W66-0055



© 2021

Lloyd's Register  
Foundation