


Lloyd
4-2-29.

"ISHERWOOD COMBINATION SYSTEM.

TO CLASS LLOYDS 100 A.I.

MASTS, WINCHES, WINDLASS & STEERING GEAR SUPPORTED TO SURVEYORS SATISFACTION.

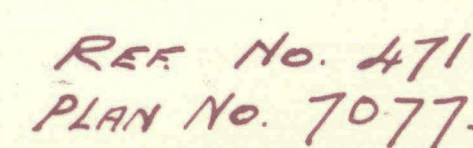

S/S OUSE BRIDGE

Furness

Profile & Dks.

FURNESS
146

~~GEN. BOX NO. 146~~

W 66-0057



© 2021

Lloyd's Register
Foundation