


No 953 SHIP. " "  
Standard Steamer Type C.  
Profile & Deck Plans.  
331'-0" P. P. x 46'-6" B. M. L. x 25'-6" M. L.  
Scale 1/8" = 1 Foot.  
Class 100 A.1. Lloyds, or B.5. \* British Corporation.

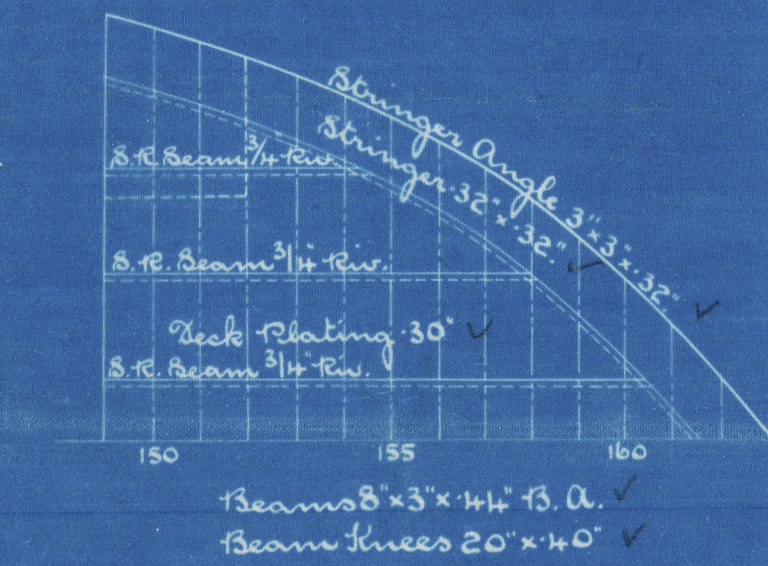

NEWCASTLE-UPON-TYNE.  
WALKER SHIPYARD.  
NO 8078 DATE 3-1-18



N<sup>o</sup>. 953.

Prentiss & Whitworth & Co.

Standard Steamer


Type "C"

PROFILE & DECK PLAN.

S. S. WESTERN VALLEYS

NEWCASTLE ON TYNE.

Report No. 42384.

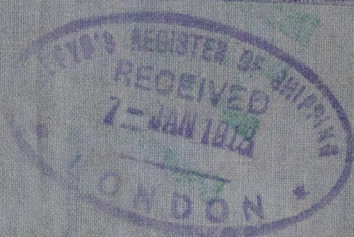

Wreck 52 B 70



© 2021

Lloyd's Register  
Foundation